


# MIDSHIP SECTION

S. S. N<sup>o</sup> 83

CLASS 100 A.I. LLOYDS

DIMENSIONS  
LENGTH B.P. = 226'-0"  
BREADTH M.D. = 35'-3"  
DEPTH M.D. = 16'-7"  
SCALE 1/2" INCH = 1 FOOT

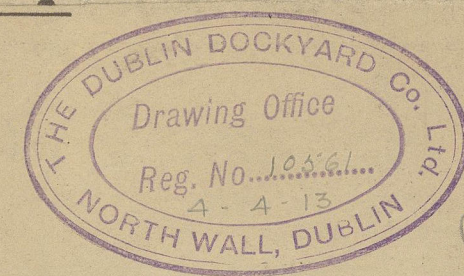


EQUIPMENT LETTER "N"  
2 BOWER ANCHORS 25 1/2 CWTs EACH STOCKLESS  
1 " " 22 " " " " " "  
1 STREAM " 6 1/2 " " EX. STOCK  
1 KEDGE " 3 1/2 " " " " " "  
210 FATHOMS 1 1/16" STUD CHAIN CABLE  
75 " 3 1/2" STREAM STEEL WIRE  
90 " 3 1/2" TOWLINE " " " "  
90 " 2 1/4" HAWSER " " " "  
90 " 5" WARP OR 2" STEEL WIRE

RIVETING  
KEEL PLATE TREBLE RIV. OVERLAPS OR STRAPS  
MAIN D<sup>o</sup> SHEERSTRAKE QUADRUPEL RIV. OVERLAPS  
FOR 1/2 L. DOUBLE AT ENDS. WHEN 1/2 L. UNDER  
STRAKE BELOW TREBLE RIV. OVERLAPS FOR 1/2 L.  
TO DOUBLE AT ENDS. WHEN 1/2 L. UNDER  
R.Q. D<sup>o</sup> SHEERSTRAKE TREBLE RIV. OVERLAPS  
FOR 1/2 L. TO DOUBLE AT ENDS. WHEN 1/2 L. UNDER  
KEEL TO UPPER TURN OF BILGE TREBLE RIV.  
OVERLAPS FOR 1/2 L. TO DOUBLE AT ENDS. WHEN 1/2 L. UNDER  
UPPER TURN OF BILGE NO STRAKE BELOW SHEERSTRAKE  
TREBLE RIV. OVERLAPS FOR 1/2 L. DOUBLE AT ENDS. WHEN 1/2 L. UNDER  
MAIN D<sup>o</sup> STRINGER PLATE TREBLE RIV. OVERLAPS  
FOR 1/2 LENGTH TO DOUBLE AT ENDS. WHEN 1/2 L. UNDER  
R.Q. D<sup>o</sup> STRINGER PLATE TREBLE RIV. OVERLAPS  
FOR 1/2 LENGTH TO DOUBLE AT ENDS. WHEN 1/2 L. UNDER  
DECK PLATING DOUBLE RIV. OVERLAPS  
FOR 1/2 L. TO SINGLE AT ENDS. WHEN 1/2 L. UNDER  
CENTRE GIRDER TREBLE RIV. OVERLAPS  
FOR 1/2 L. TO DOUBLE AT ENDS. WHEN 1/2 L. UNDER  
MARGIN PLATE & CENTRE TANK TOP DOUBLE RIV.  
TANK TOP PLATING DOUBLE RIV. OVERLAPS FOR 1/2 L.  
SINGLE AT ENDS. WHEN 1/2 L. UNDER

11.4.13 LLOYDS NUMERALS  
22.4.13 B = 35'25"  
2.5.13 D = 16'52"  
30.5.13 51'87" = 1" N<sup>o</sup>  
24.6.13 L = 226'  
ADD FOR ERECTIONS 1172'62" = 2" N<sup>o</sup>  
9.7.13 84'26"  
12661'88" = EQUIPMENT N<sup>o</sup>

ERECTOR  
R.Q. DECK 111'68" x 4" x 1" = 446'72"  
BRIDGE 9'58" x 7" x 75" = 50'29"  
FORECASTLE 28'0" x 7" x 75" = 147'00"  
CASING 57'5" x 7" x 5" = 201'25"  
846'26"

d = 13.87 MAIN DECK  
d = 17.87 R.Q.  
d = 18.87 BOILER SPACE  
d = 15.45 ENGINE  
1/2 L = 13.60 MAIN D<sup>o</sup>  
1/2 L = 10.96 R.Q.

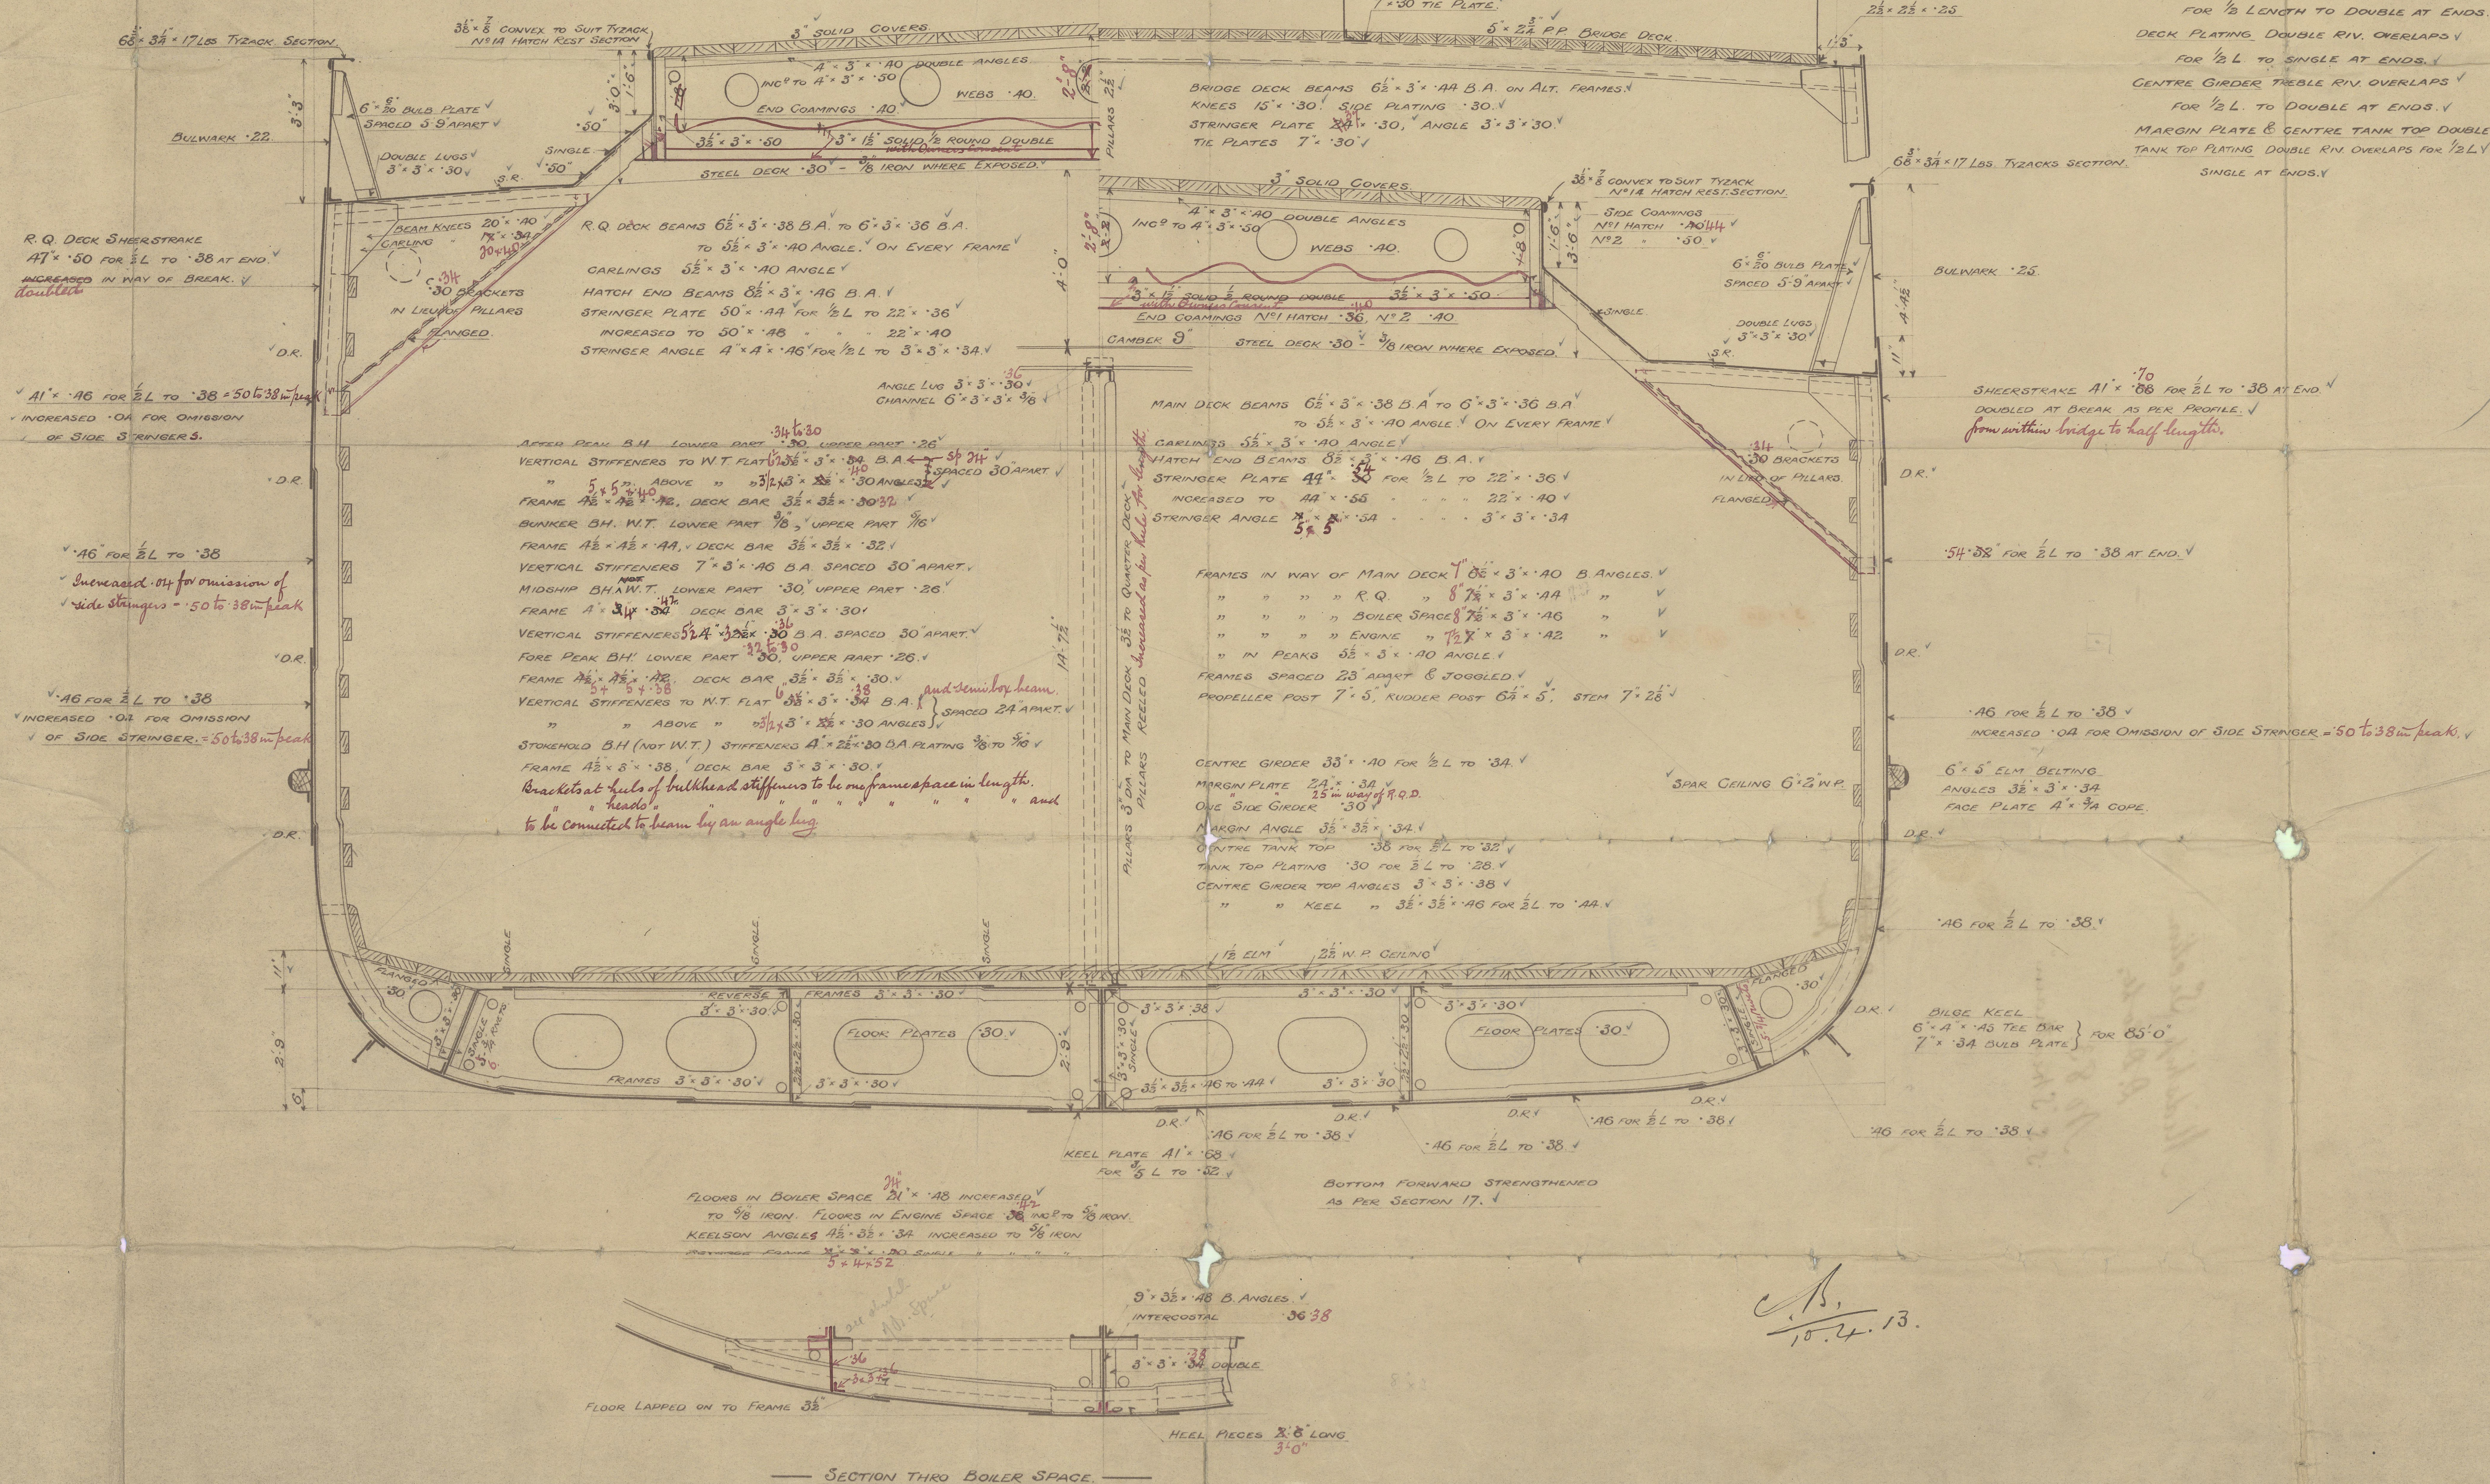

SECTION THRU BOILER SPACE




Midship Section

D. D. Lott.



No 83.

S.S. "Streattham"

Sub 5598.

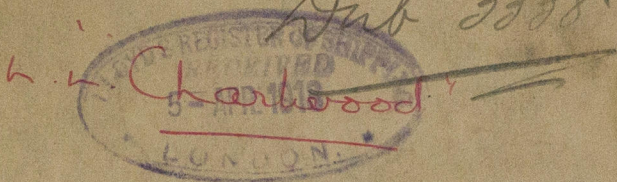

4/4/13  
~~Dub. 5/6/13~~  
Juno

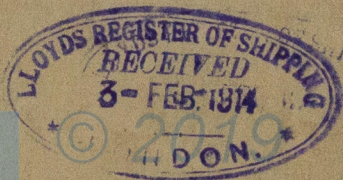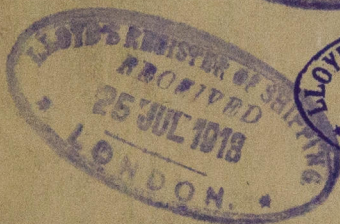

LR  
W156-0122

Lloyd's Register  
Foundation