

11.4.13
22.4.13
2.5.13
30.5.13
16.6.13
24.6.13
9.7.13

*Increase engine opening 4 1/2" off top
between 849*

— PROFILE AND DECK PLANS —

— S.S. N° 83 —



— SCALE 1/8" = 1 FOOT —

226'-0" B.P. x 35'-3" B.M.D. x 16'-1 1/2" D.M.D.



*Brackets equal area
fillers; steepen where
in new sketch*

Print flat

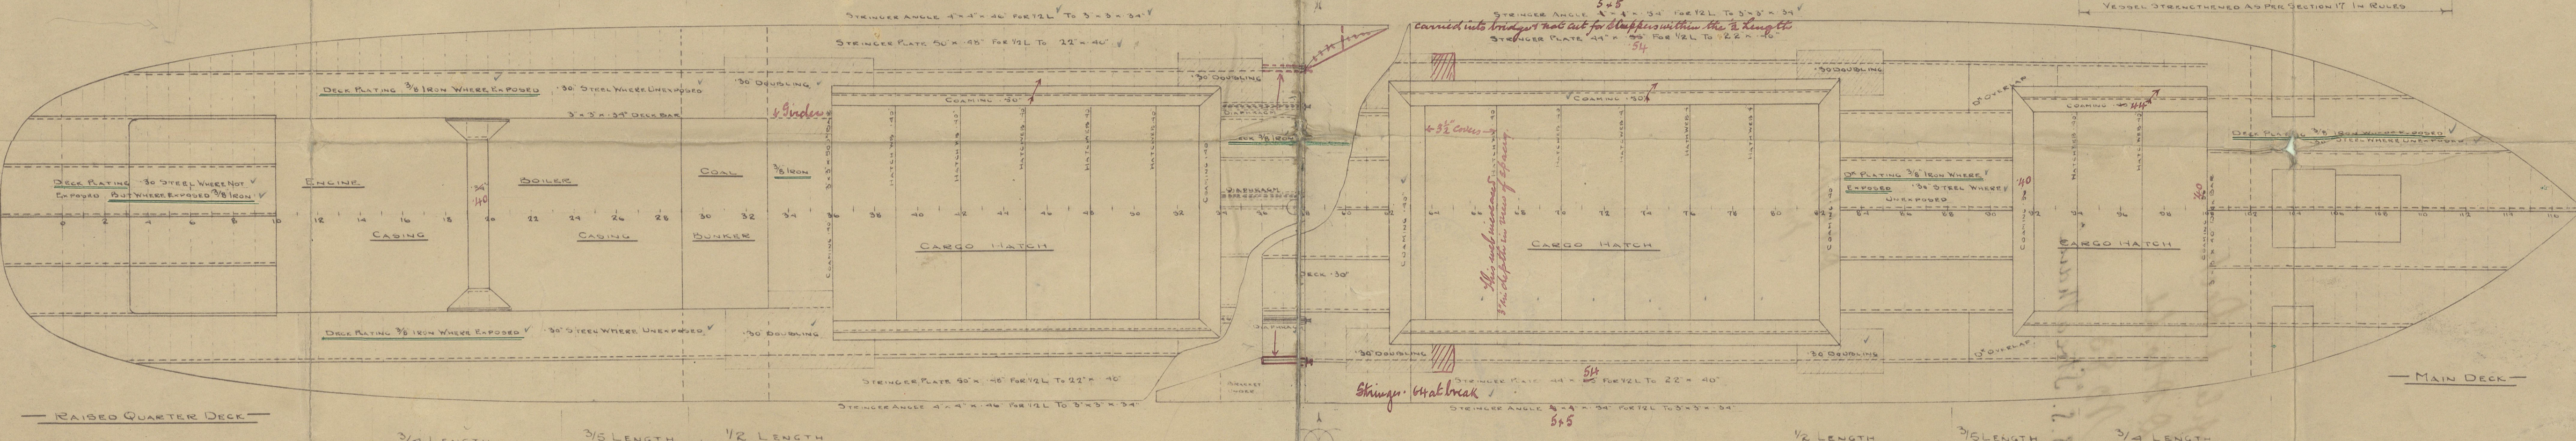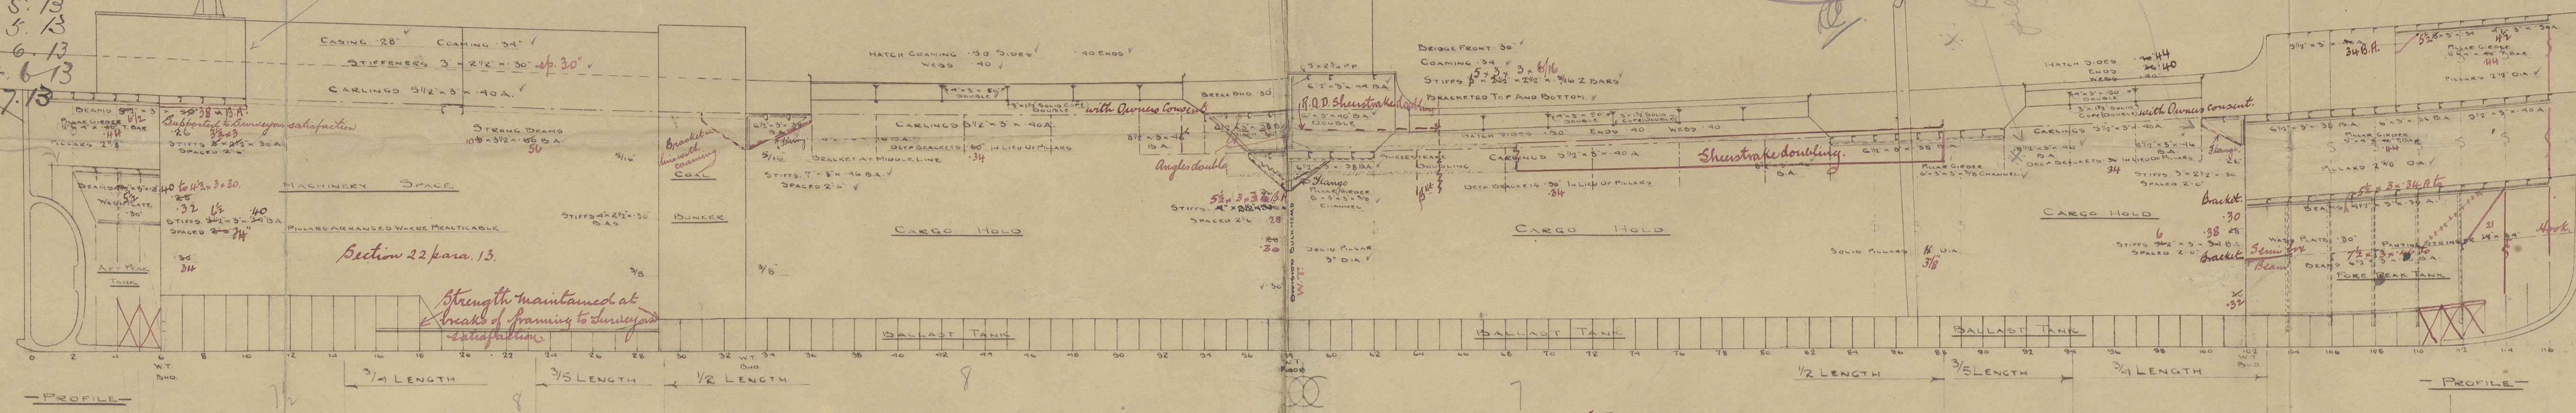

APPROXIMATE PARTICULARS FOR FREEBOARD
REGISTERED DIMENSIONS 226'2" x 35'4" x 14'2"
UNDER DECK TONNAGE (APPROX) 930 TONS
SHRE AT STEM 0'-0" 1/8 L FROM STEM 3'-3 FEET
SHRE AT STERN 2'-8 3/8 L FROM STERN 1'-03 FEET
BRIDGE CLOSED FOCSLE OPEN WITH SIDE HOUSES ETC.

*C.P.
10.4.13.*

W156-0123

Profile & Deck

D.D. Co. Ltd

No 83.




S.S. "Streattham"

Deb 5558.

Charlwood



Deb 4/4/13
Jm

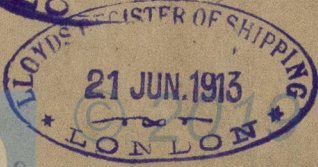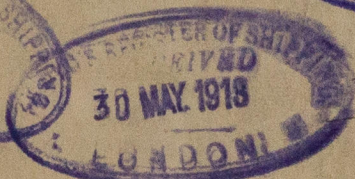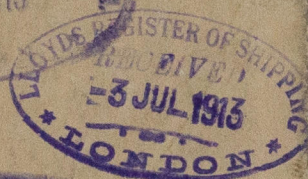

Lloyd's Register
Foundation