


To be returned to J. L. 11

J. L. 11
MIDSHIP SECTION


Scale 1" = 1 Foot

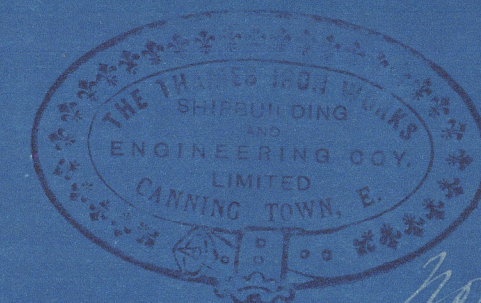


DIMENSIONS
LENGTH B.P. 130' 0"
BEAM MOULDED 18' 6"
DEPTH 7' 0"

Nov. 24/04
H. (Machinist)

120 = 17.6 mch. H.

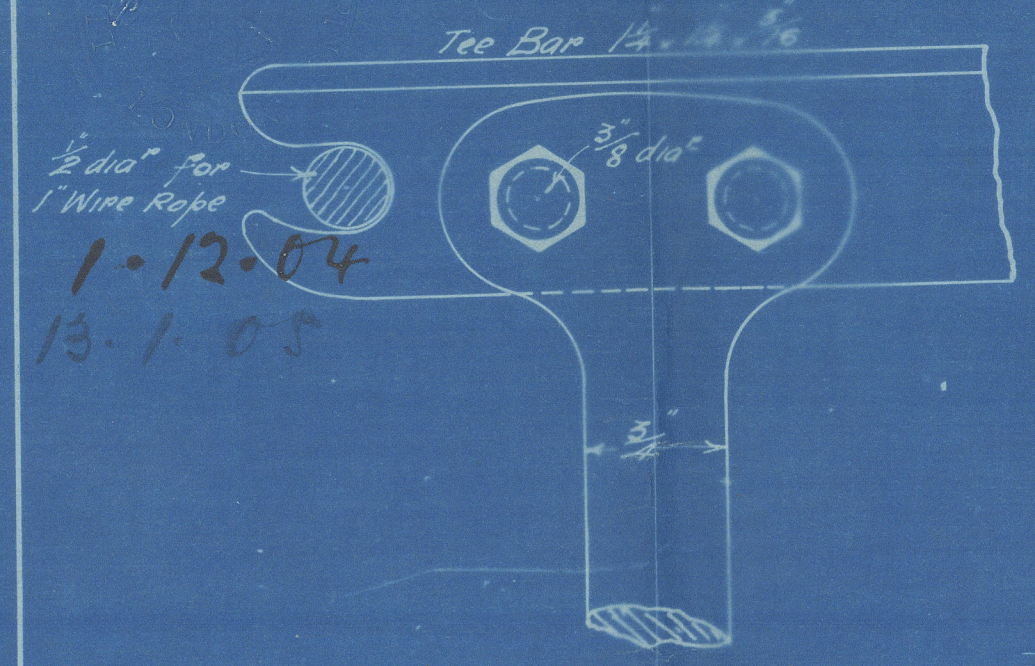

Full size Sketch of Head of Aiming Stanchion.

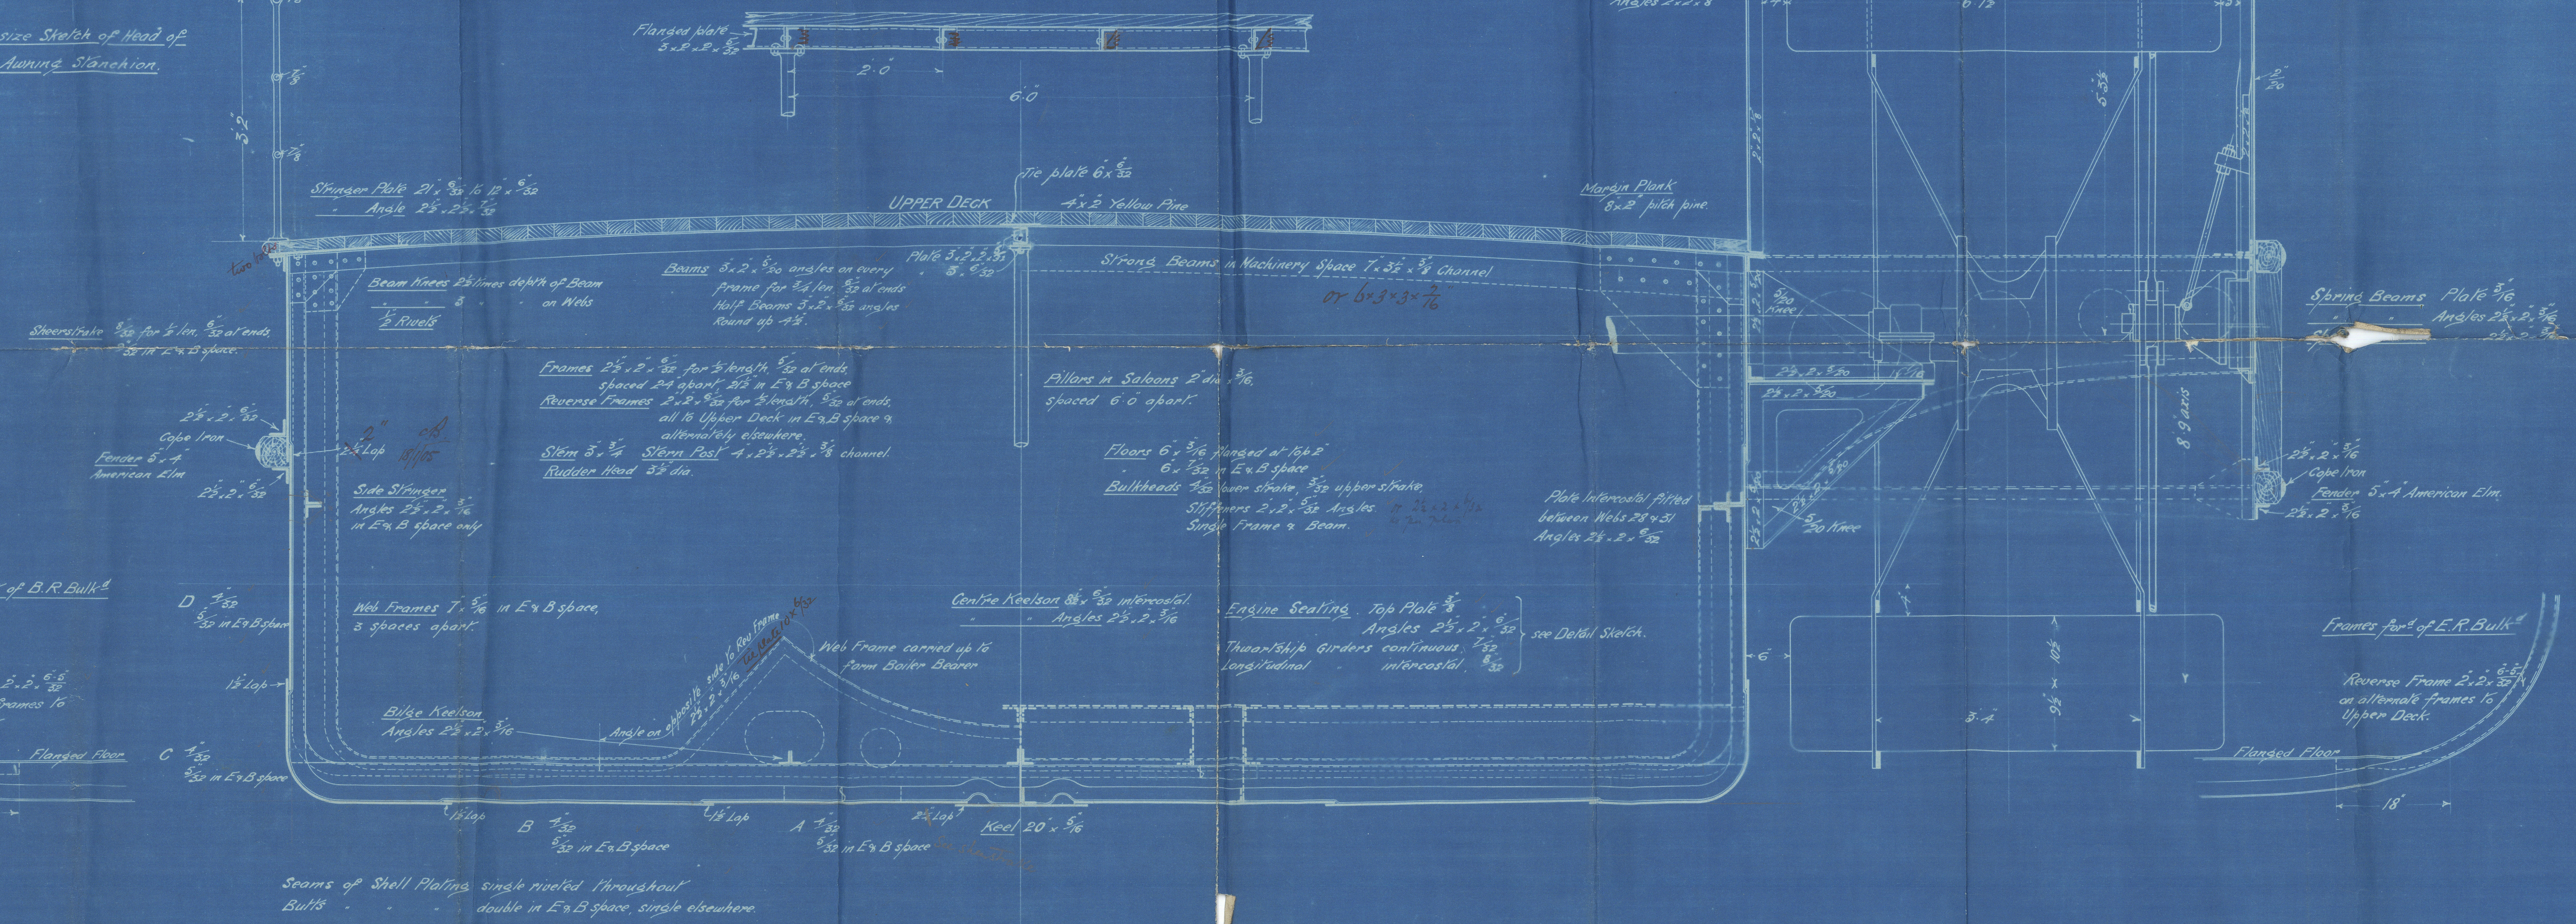

Seams of Shell Plating single riveted throughout
Butts double in E & B space, single elsewhere.

HT/6
29/11/04
13/1/05

STM
30/1/04

Midship Section

K 83 a t f.

L. C. C.

Purcell (1905)

3 dot case


+ 9 other sister ships
built by Thomas
Iron Works

RETAIN



Lloyd's Register
Foundation

W 15630057

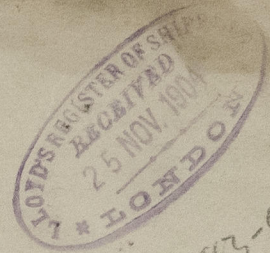

W1563-0057



© 2020

Lloyd's Register
Foundation