


all steel castings to
be tested as required
by the Rules.

25/11/11

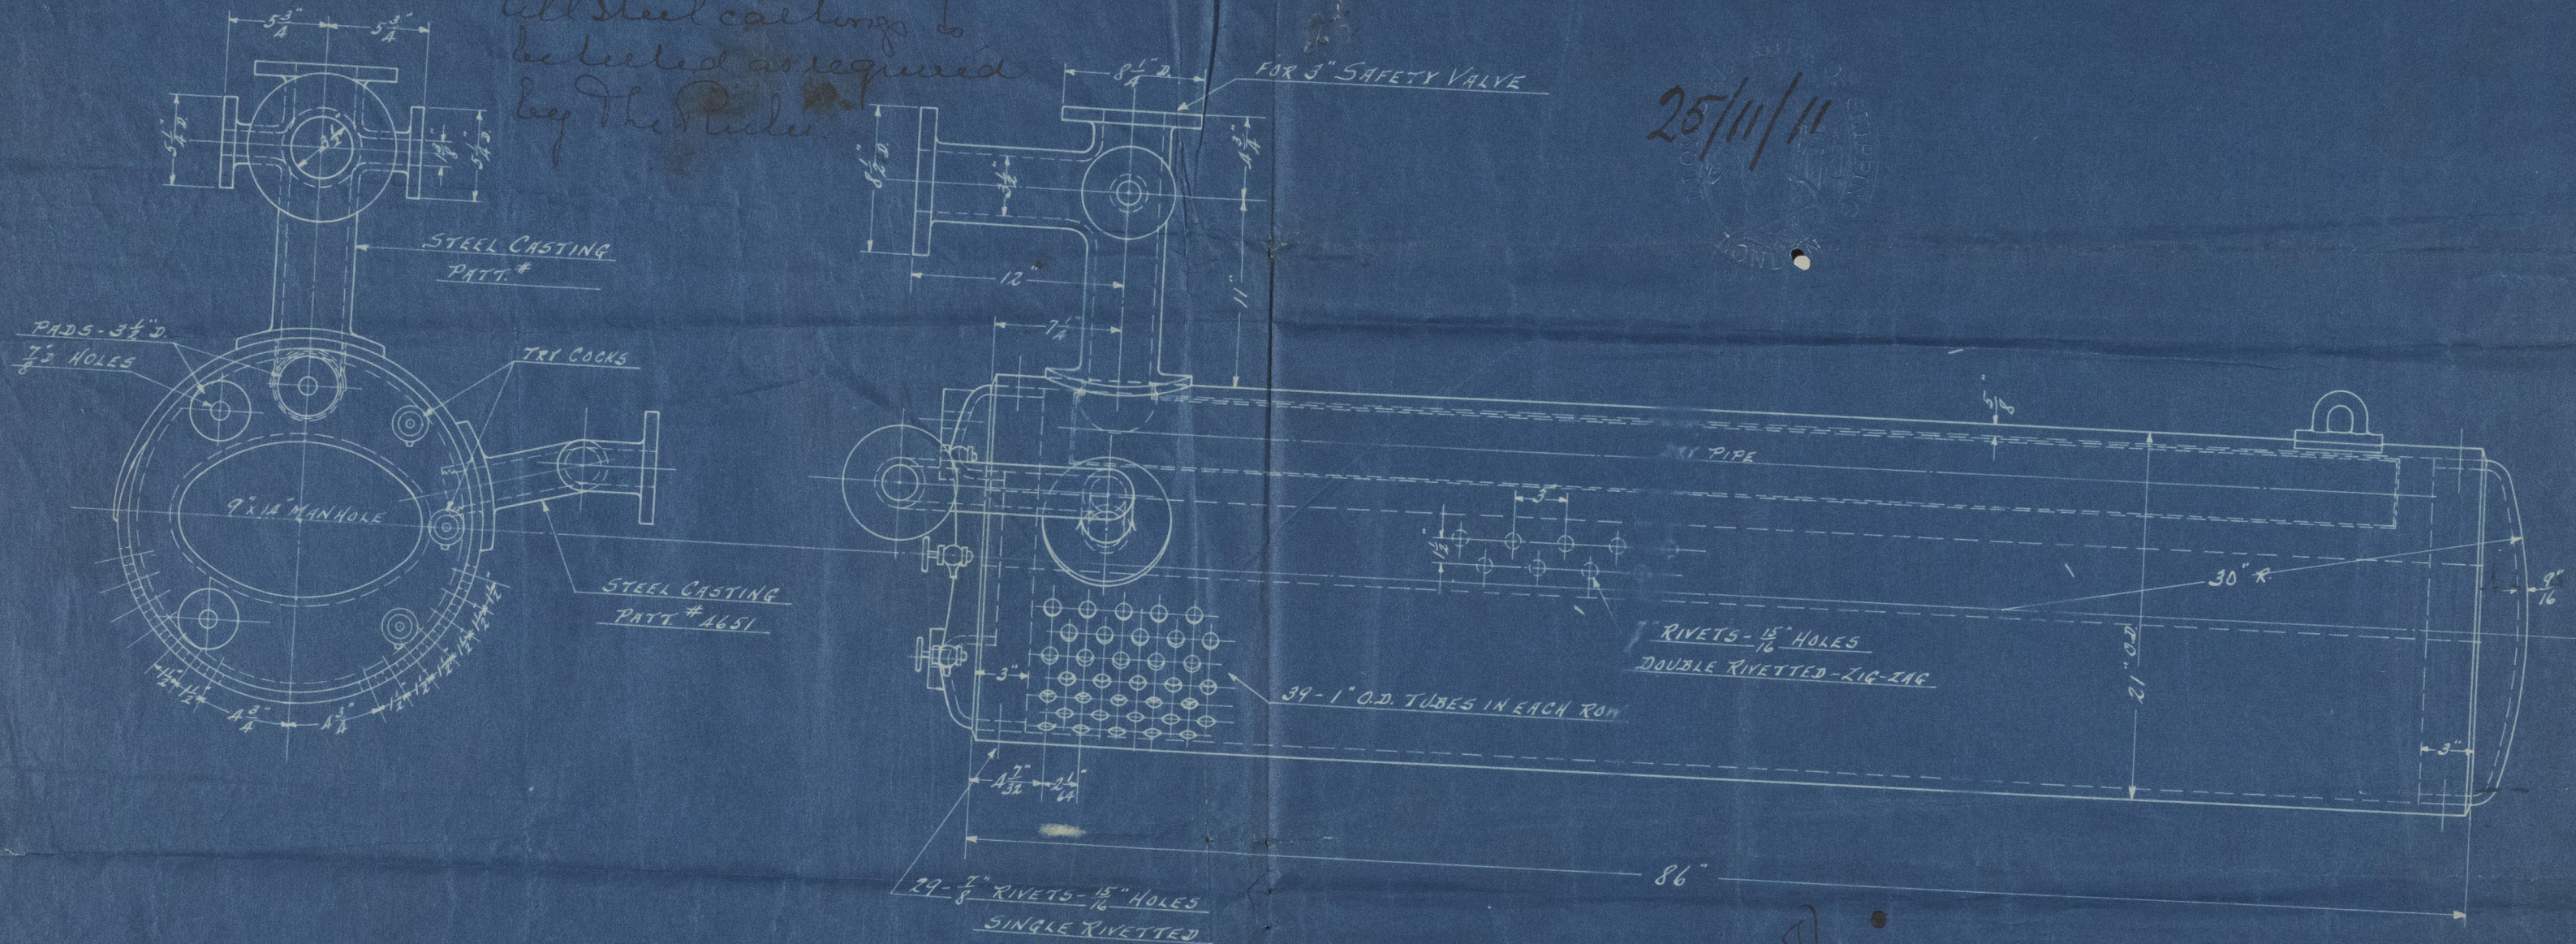

SEABURY PATENT SAFETY WATER TUBE BOILER
TYPE "D"

Working pressure 200 lbs per sq inch

APR 25/11/11

GAS ENGINE & POWER CO. AND CHARLES L. SEABURY & CO.
CONSOLIDATED

DRAWN BY S. H. S. 15 OCT. 31, 1911.

ENGINEERING DEPARTMENT

SHEET NO. 3545 E

SCALE 1/2" = 1 FT.

STEAM DRUM OF BOILER FOR N.Y. SHIPBUILDING CO.

N. York. S. B. Co.

123 & B4

Donkey Boilers

Nyk. Apts 9369 & 9370

inland
land

32



© 2020

Lloyd's Register
Foundation

W1564-0059