


# HORIZONTAL MULTITUBULAR STEEL BOILER 10'-0" DIA X 9'-6" LONG 180 LBS W.P. LLOYDS SURVEY

SCALE 1" = 1 FOOT


No 6182

1/11/12.

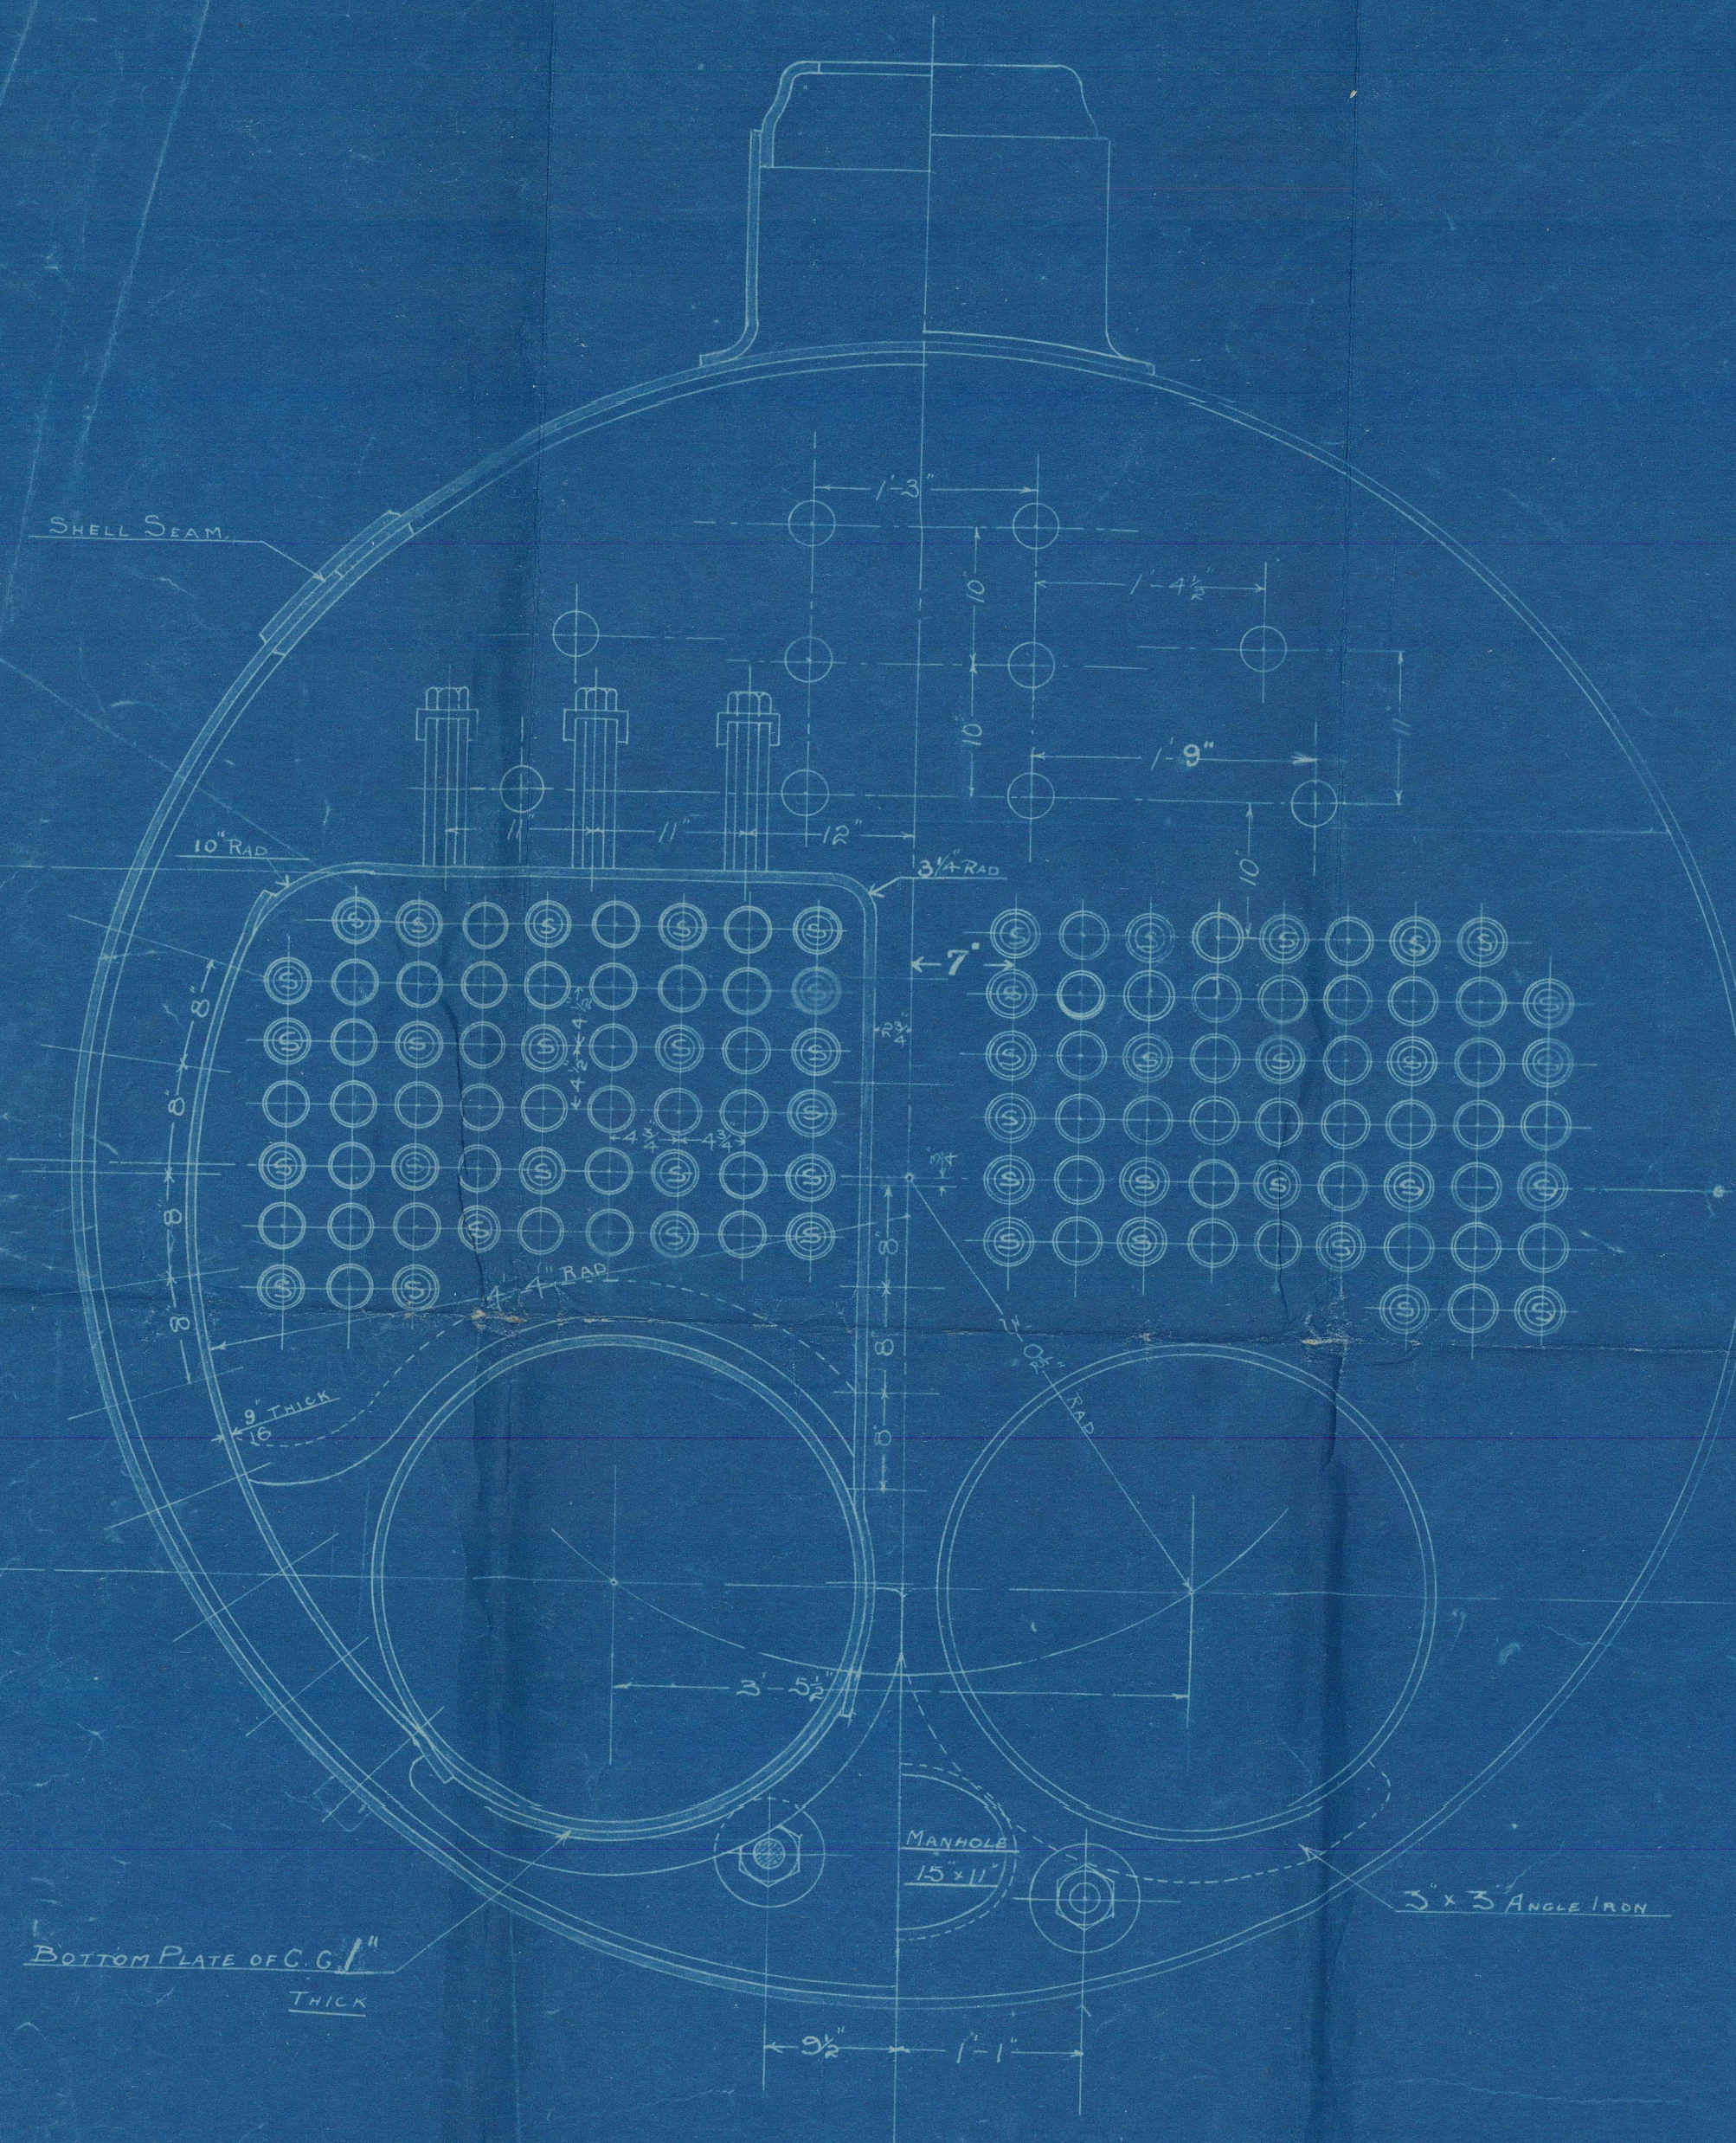

HEATING SURFACE 805.120  $\pi$

GRATE AREA 31.816  $\pi$

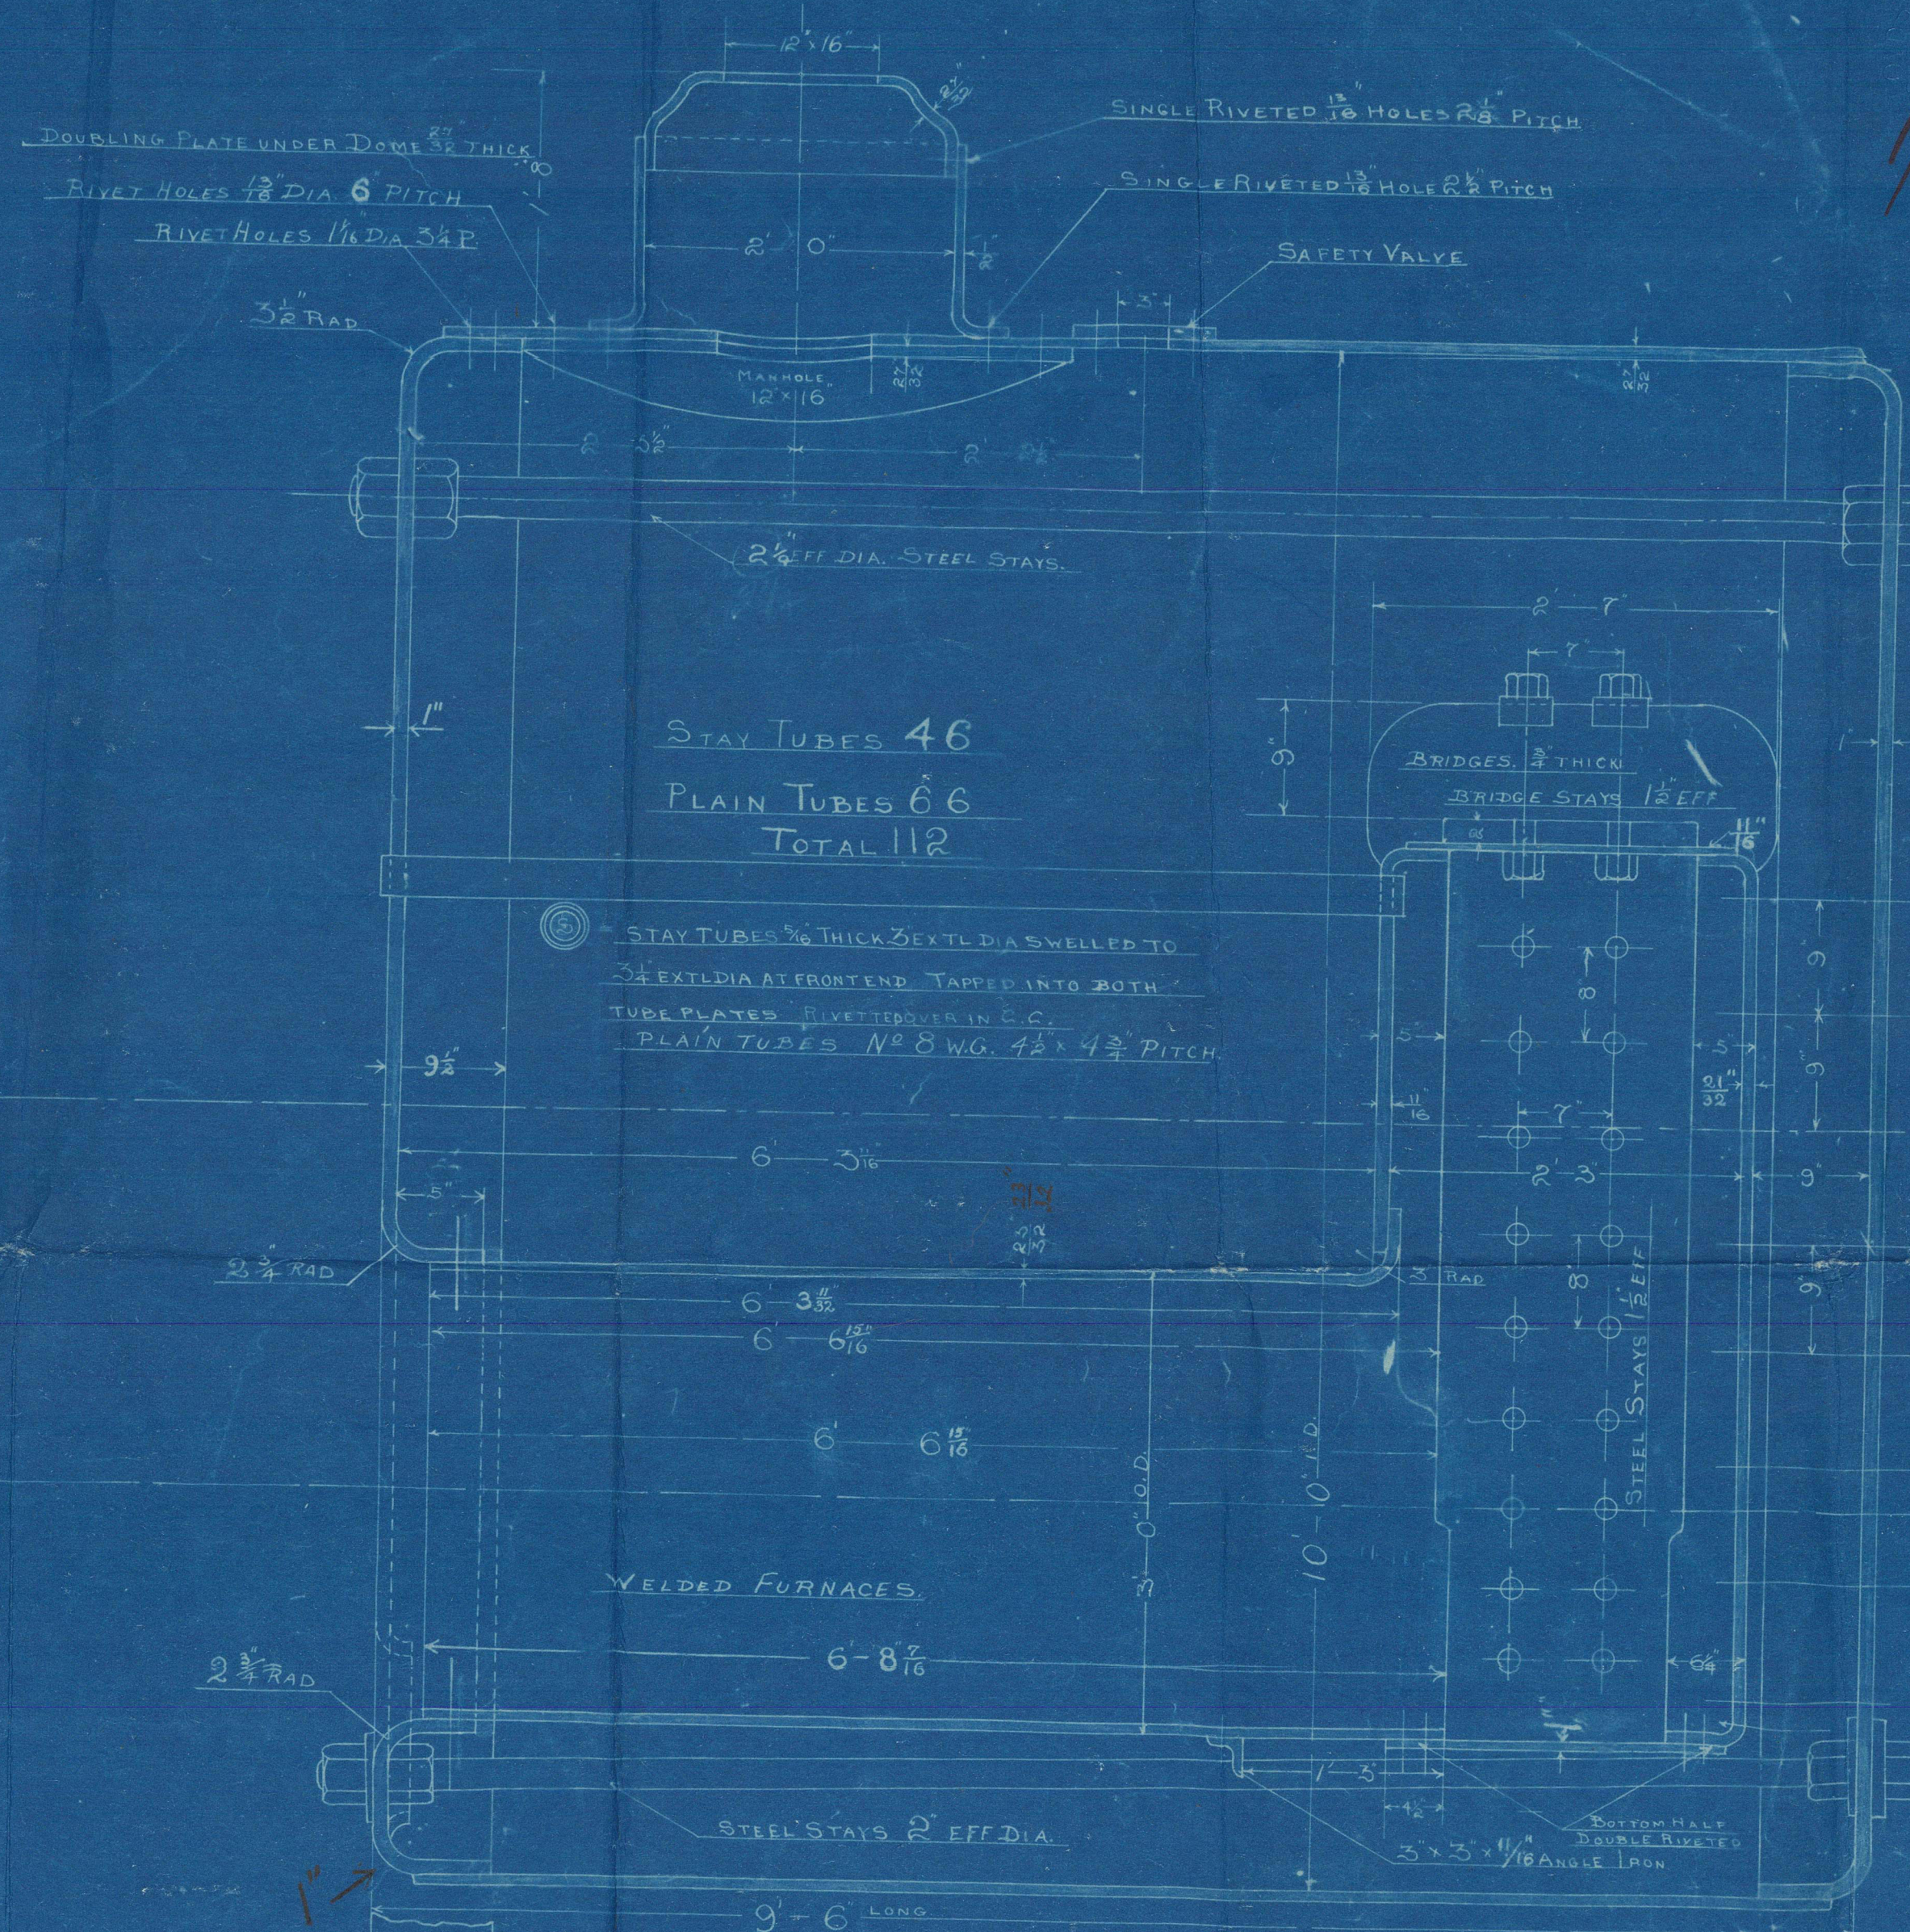


SHELL RIVETING HOLES  
1/8" DIA 3 1/2" PITCH

STRAP RIVETING HOLES 1/8" DIA

THICKNESS OF STRAPS 3/16"

PLATE 86.6%

RIVETS 90%

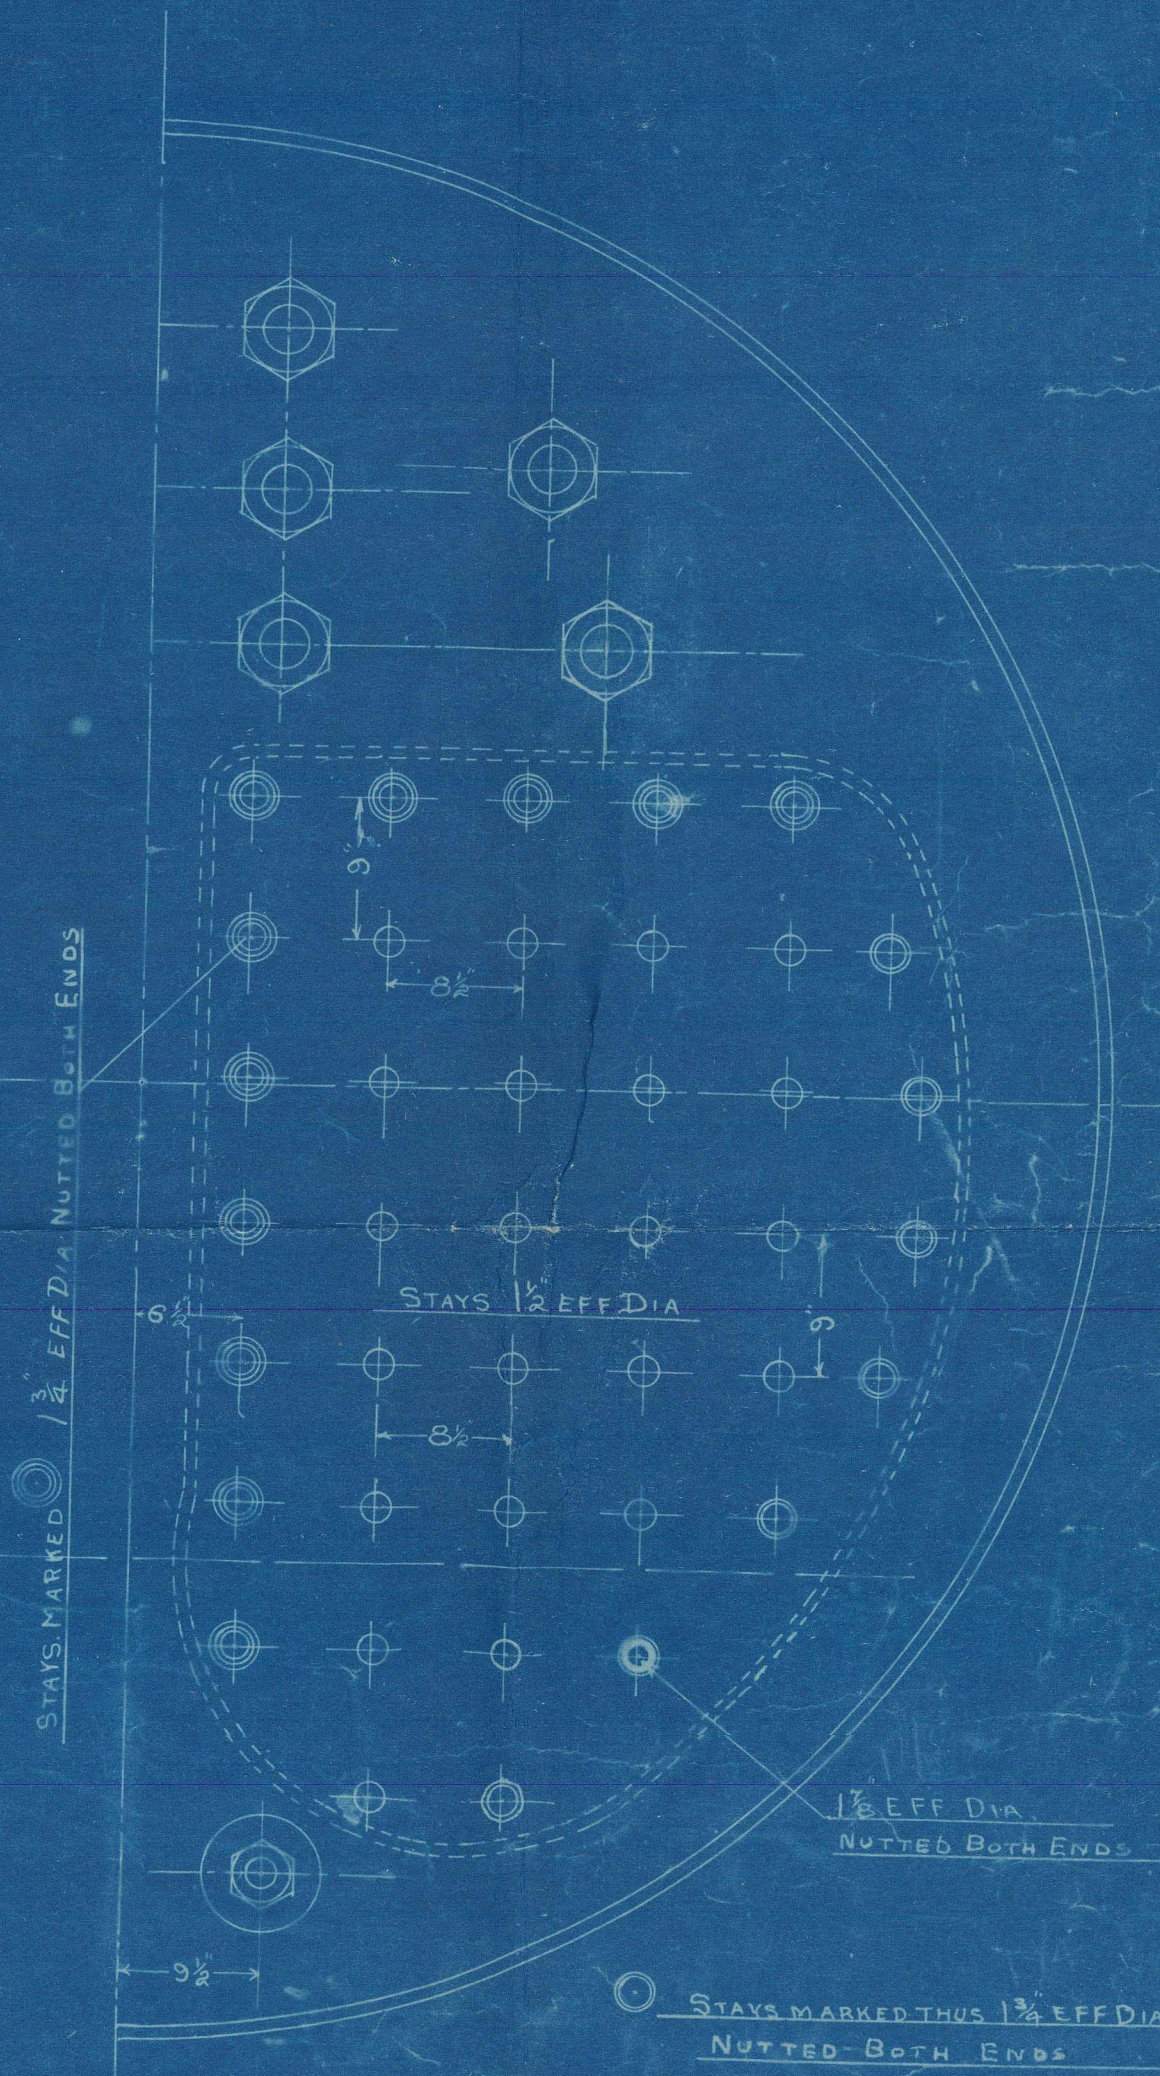





150B



W1565-0028

Main Boilers

4

4


Steam Donor A. J. S.

London Report.

+

Full Report No. 2636L

RETAIN

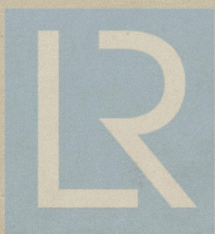

© 2021

Lloyd's Register  
Foundation

W1565-0028



Sutton's  
6/82

0028



© 2021

Lloyd's Register  
Foundation