


ELLIOTT & GARROD, LIMITED
 No. 377A
 Date NOV 1 1912
 HEAD OFFICE & WORKS, BECCLES, SUFFOLK

SIZE 80 CRANK & DISC 26-2-09.

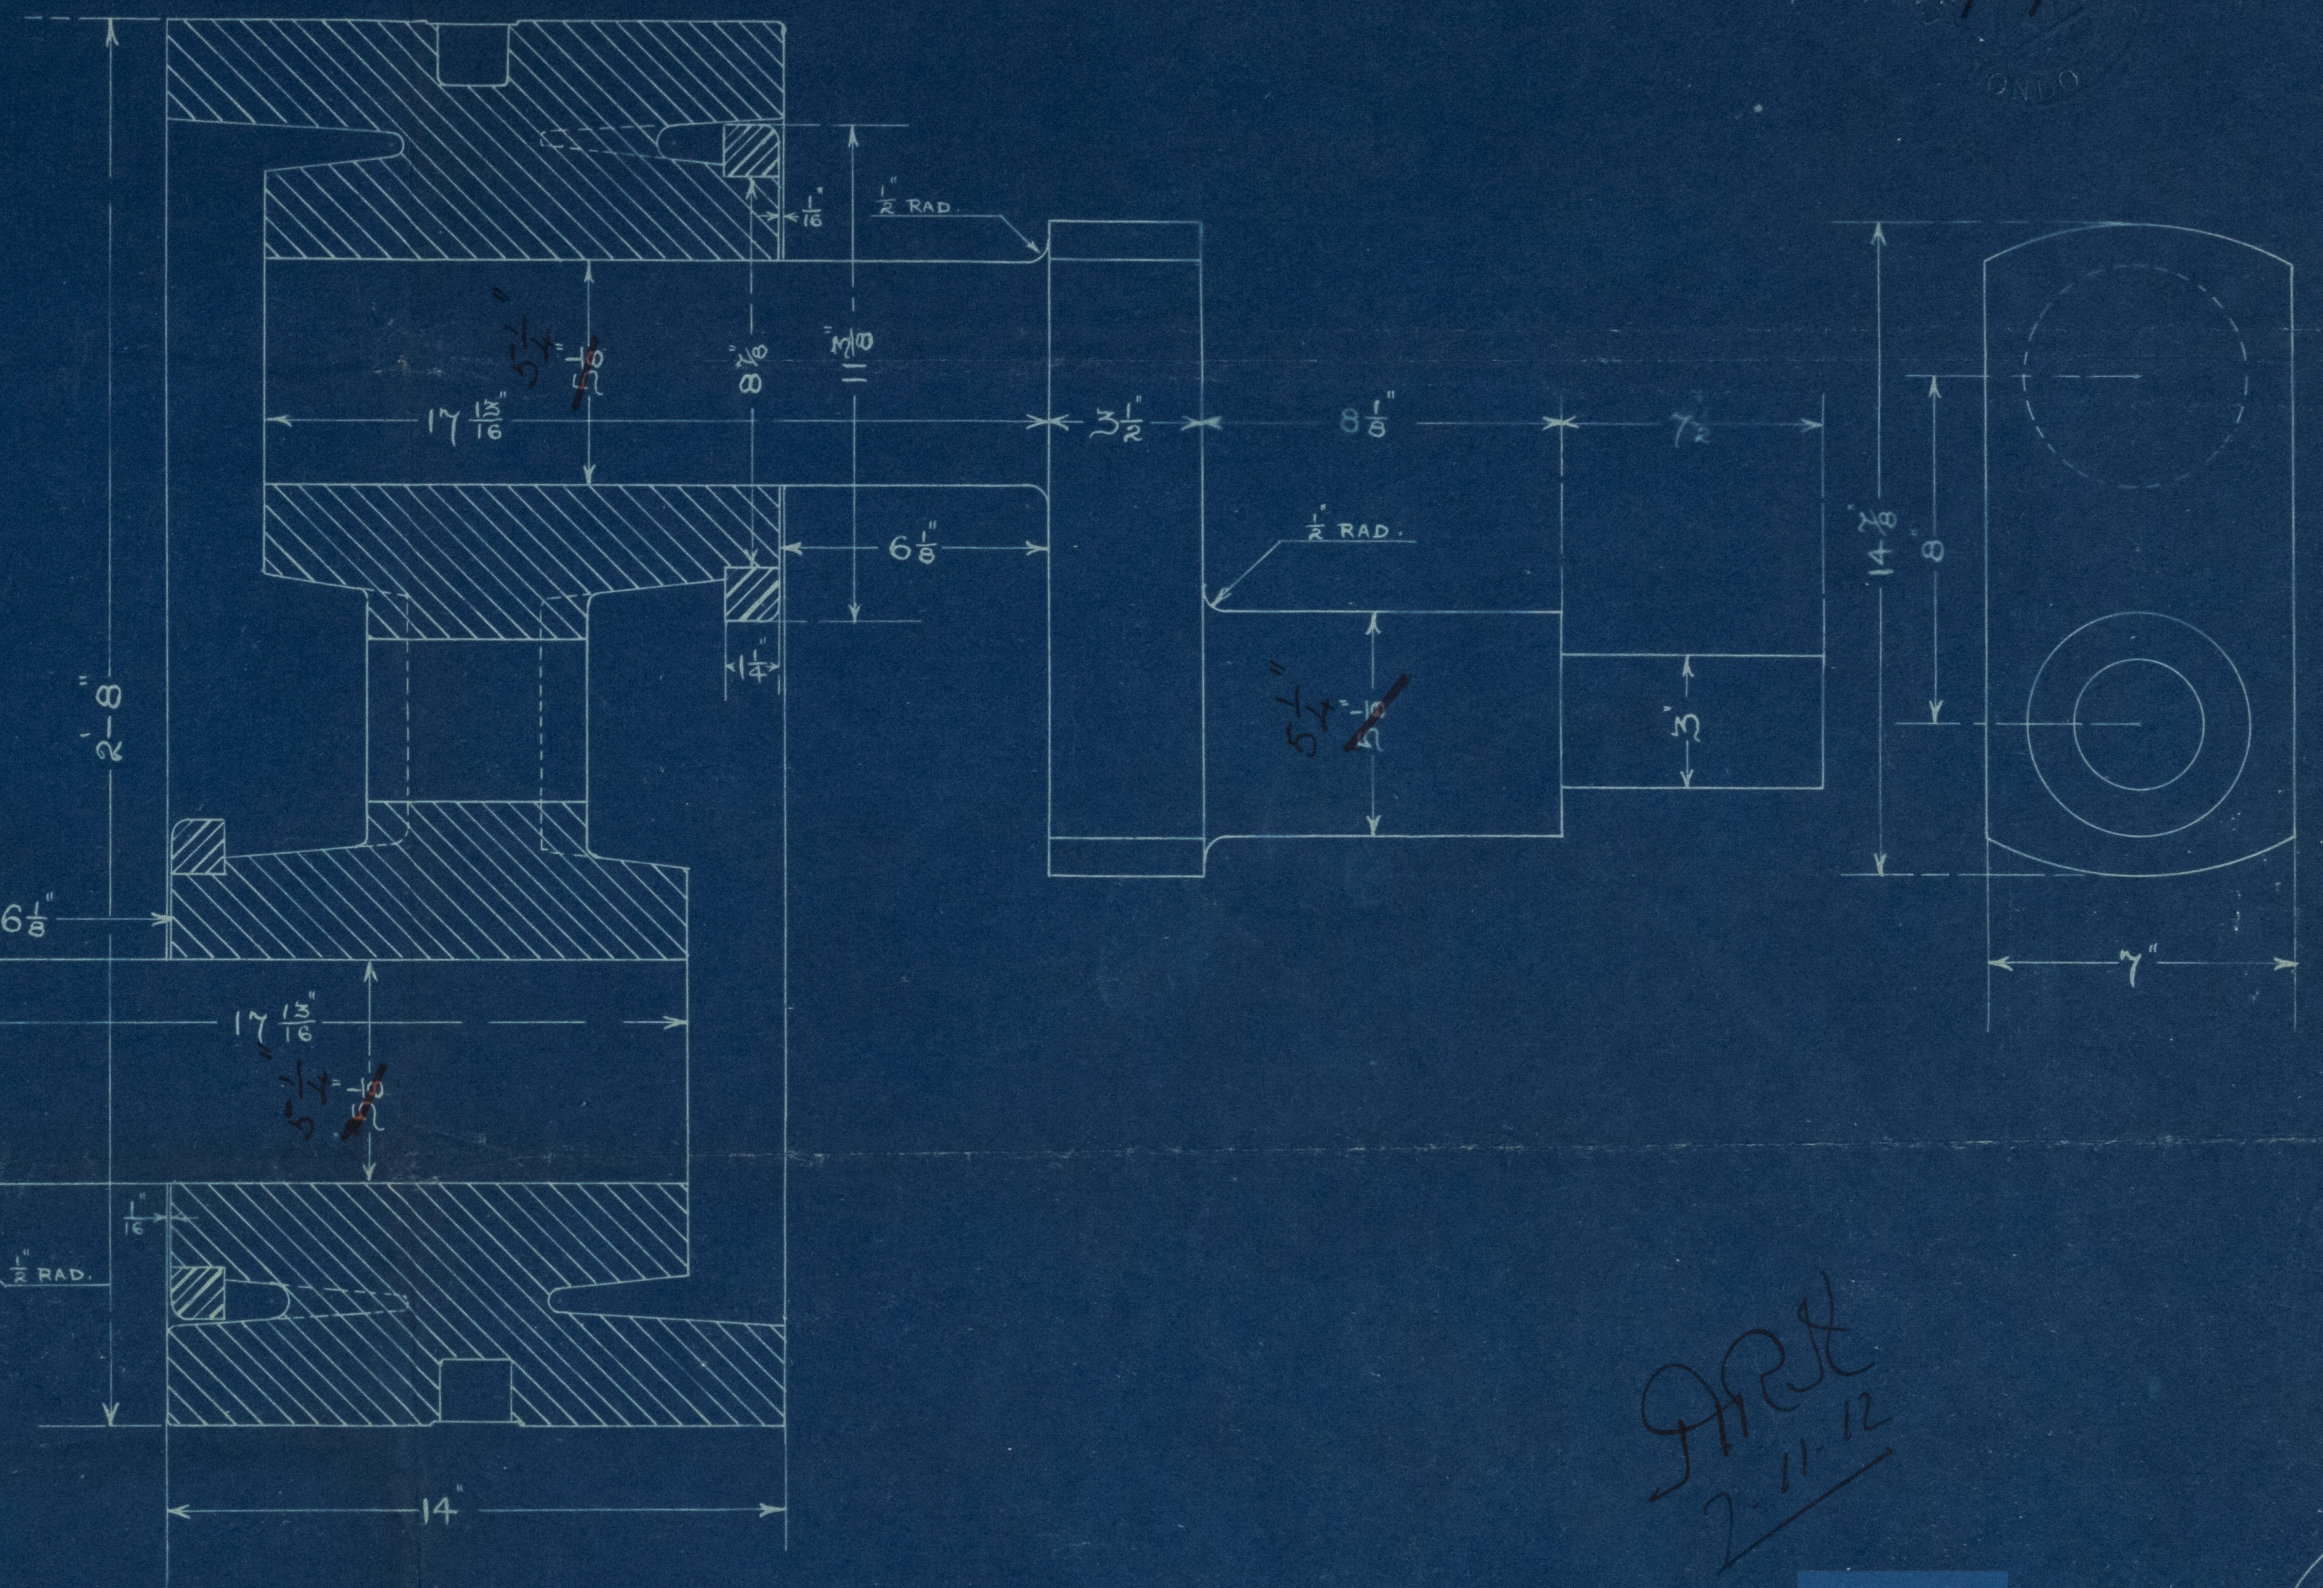

9/11/12

GRX
 2-11-12



377A

W1565-00292

FROM

ELLIOTT & GARROOD, Ltd., BECCLES,

For enclosure to

The Secretary,

Lloyd's Register of B. & S. Shipping,

London, E.C.

00292/2

Shafburg



Elmswood

Cochrane 563

Steam Trawler R.E.S.

London Report No.

+ Hull Report No 26364

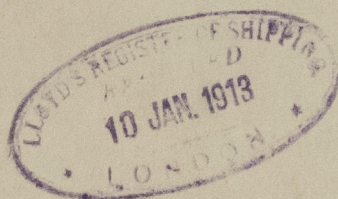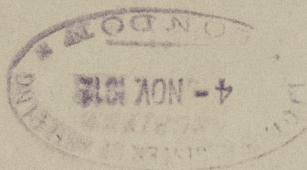

RETAIN



© 2021

Lloyd's Register
Foundation