

2' no 2 Perimeter  
E 27.01

waiter 2 up stairs

13.11.12

13.11.12

# MIDSHIP SECTION


STEEL SCREW DRIFTER

N<sup>o</sup> 563

DIM<sup>s</sup> 110'-0" x 21'-0" x 11'-0" MLD

SCALE 1/2" = ONE FOOT

TO BE CLASSED 100 A1 FOR FISHING  
PURPOSES. DECK PLATED OVER IN  
WAY OF MACHINERY SPACE. ENGINE &  
BOILER CASING AS PREVIOUSLY  
APPROVED

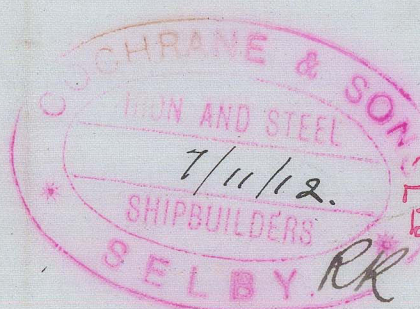

## NUMERALS

B + D = 32.00

L x (B + D) = 3520.00

## PROPORTIONS

L/D = 10.00

L/B = 5.23


S = 9.75

## EQUIPMENT

- ✓ 1<sup>ST</sup> BOWER ANCHOR 4 3/4 CWT<sup>s</sup> Ex STOCK OR 6 CWT<sup>s</sup> STOCKLESS
- ✓ 2<sup>ND</sup> " " 4 1/4 " " " OR 5 1/2 CWT<sup>s</sup> " "
- ✓ KEDGE ANCHOR 2 1/2 " " "
- ✓ 90 FATHOMS 1 1/2 " CABLE
- ✓ 60 " 5 1/2 " HAWSER
- ✓ 60 " 4 " WARP

## RIVETING

- ✓ BUTTS OF SHELL PLATING LAPPED &
- ✓ DOUBLE RIVETED, EXCEPT GARBOARD
- ✓ & SHEER STRAKE WHICH ARE TO BE
- ✓ STRAPPED & DOUBLE RIVETED. LANDING
- ✓ EDGES DOUBLE RIVETED EXCEPT TOP EDGE
- ✓ OF SHEER STRAKE WHICH IS TO BE SINGLE RIVETED
- ✓ BUTTS OF STRINGER & TIE PLATES TO BE LAPPED
- ✓ & DOUBLE RIVETED

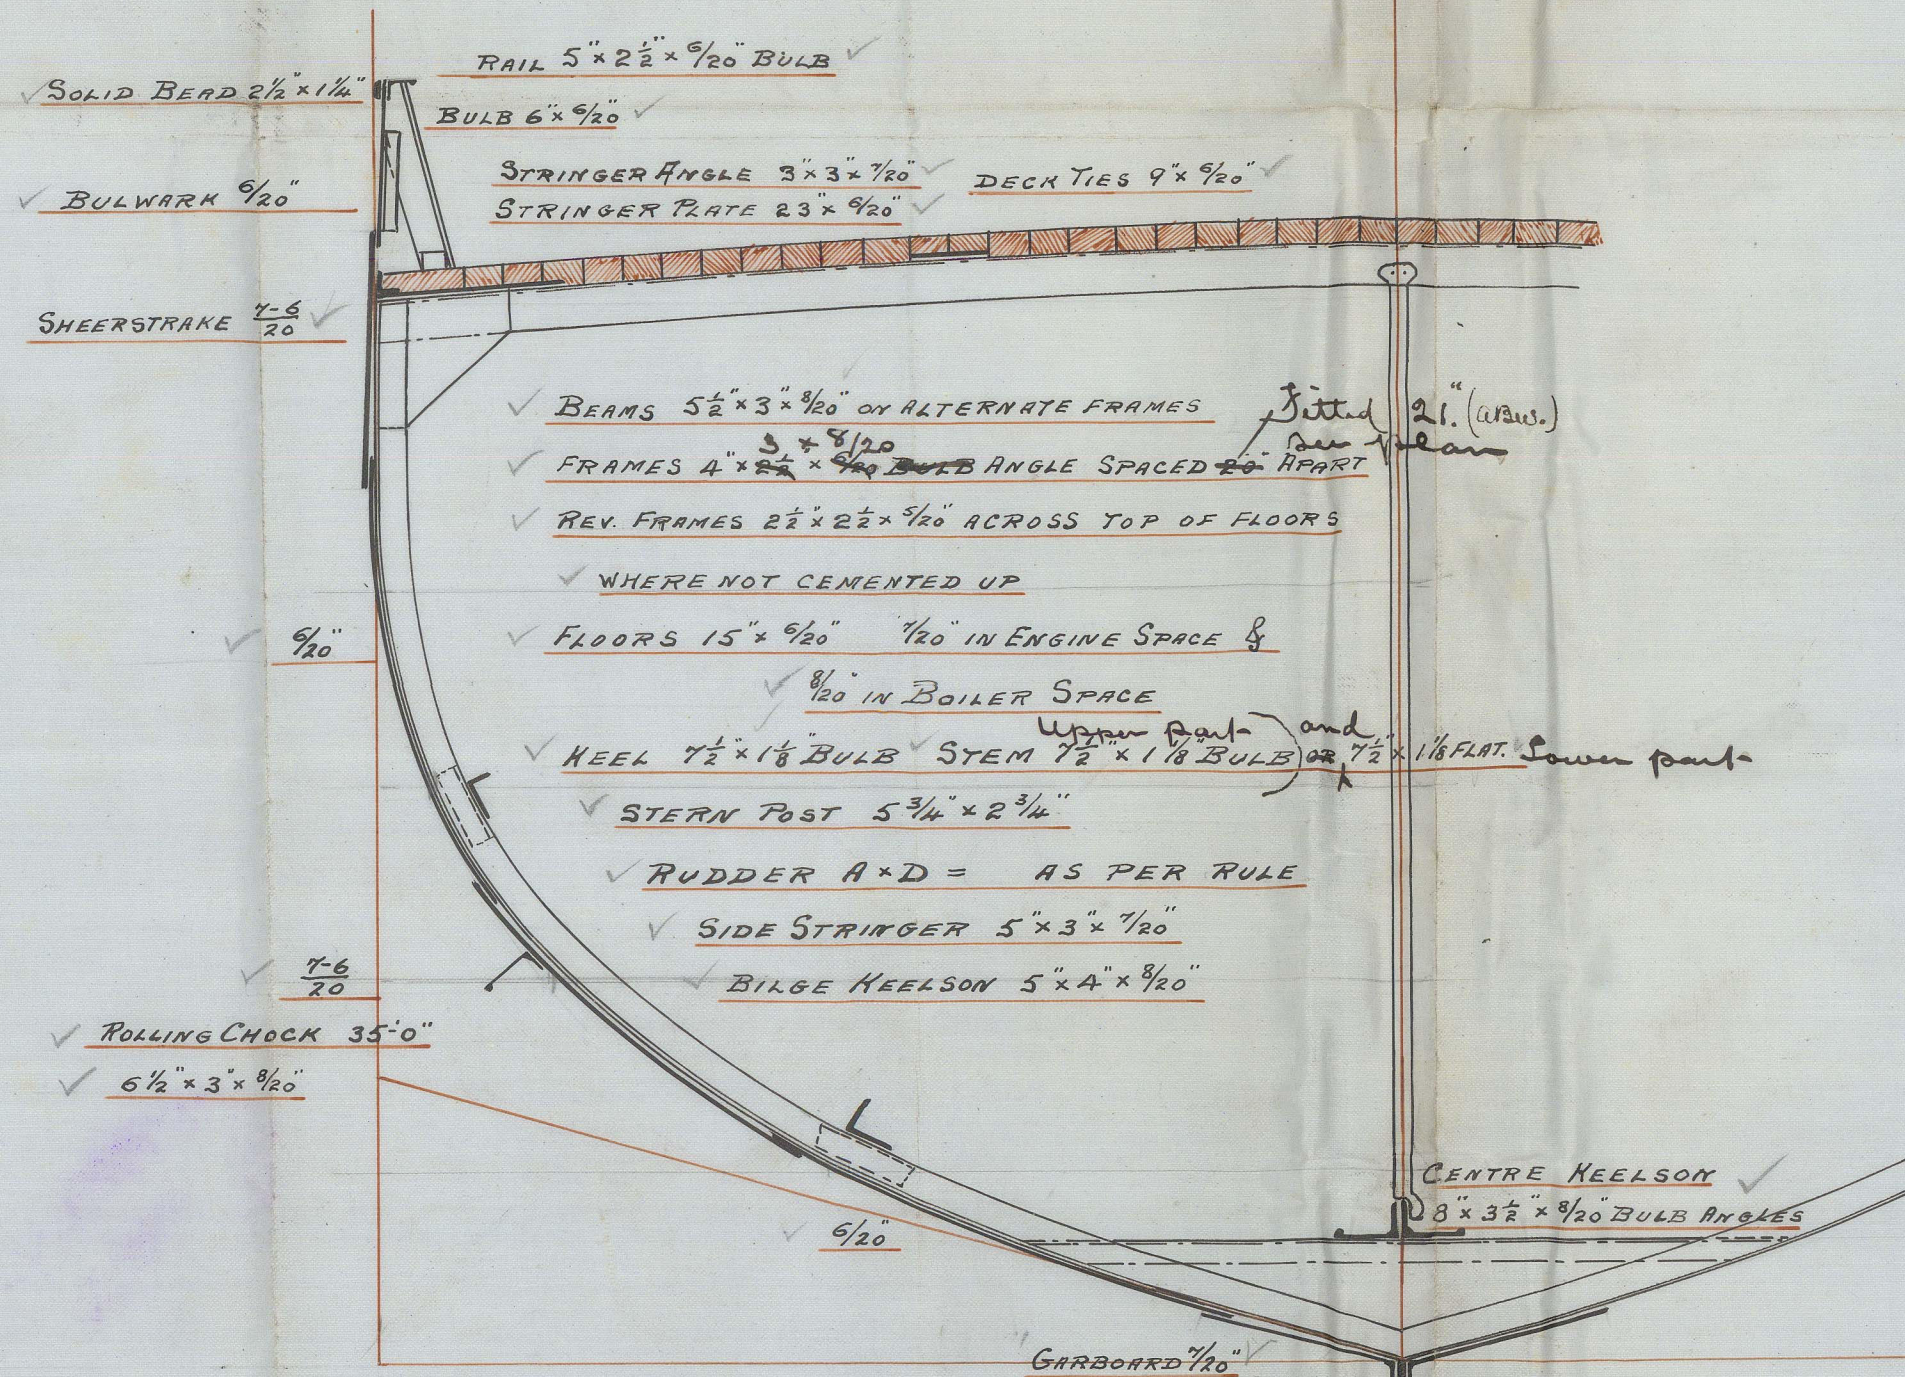

13.11.12

NOV 18 1912



Cochrane & Son's  
No. 563

Midship Section

1/2 R. R. S.

Hull Rpt No: 26364



3.11.15

RETAIN



© 2021

Lloyd's Register  
Foundation

W 565-0032