
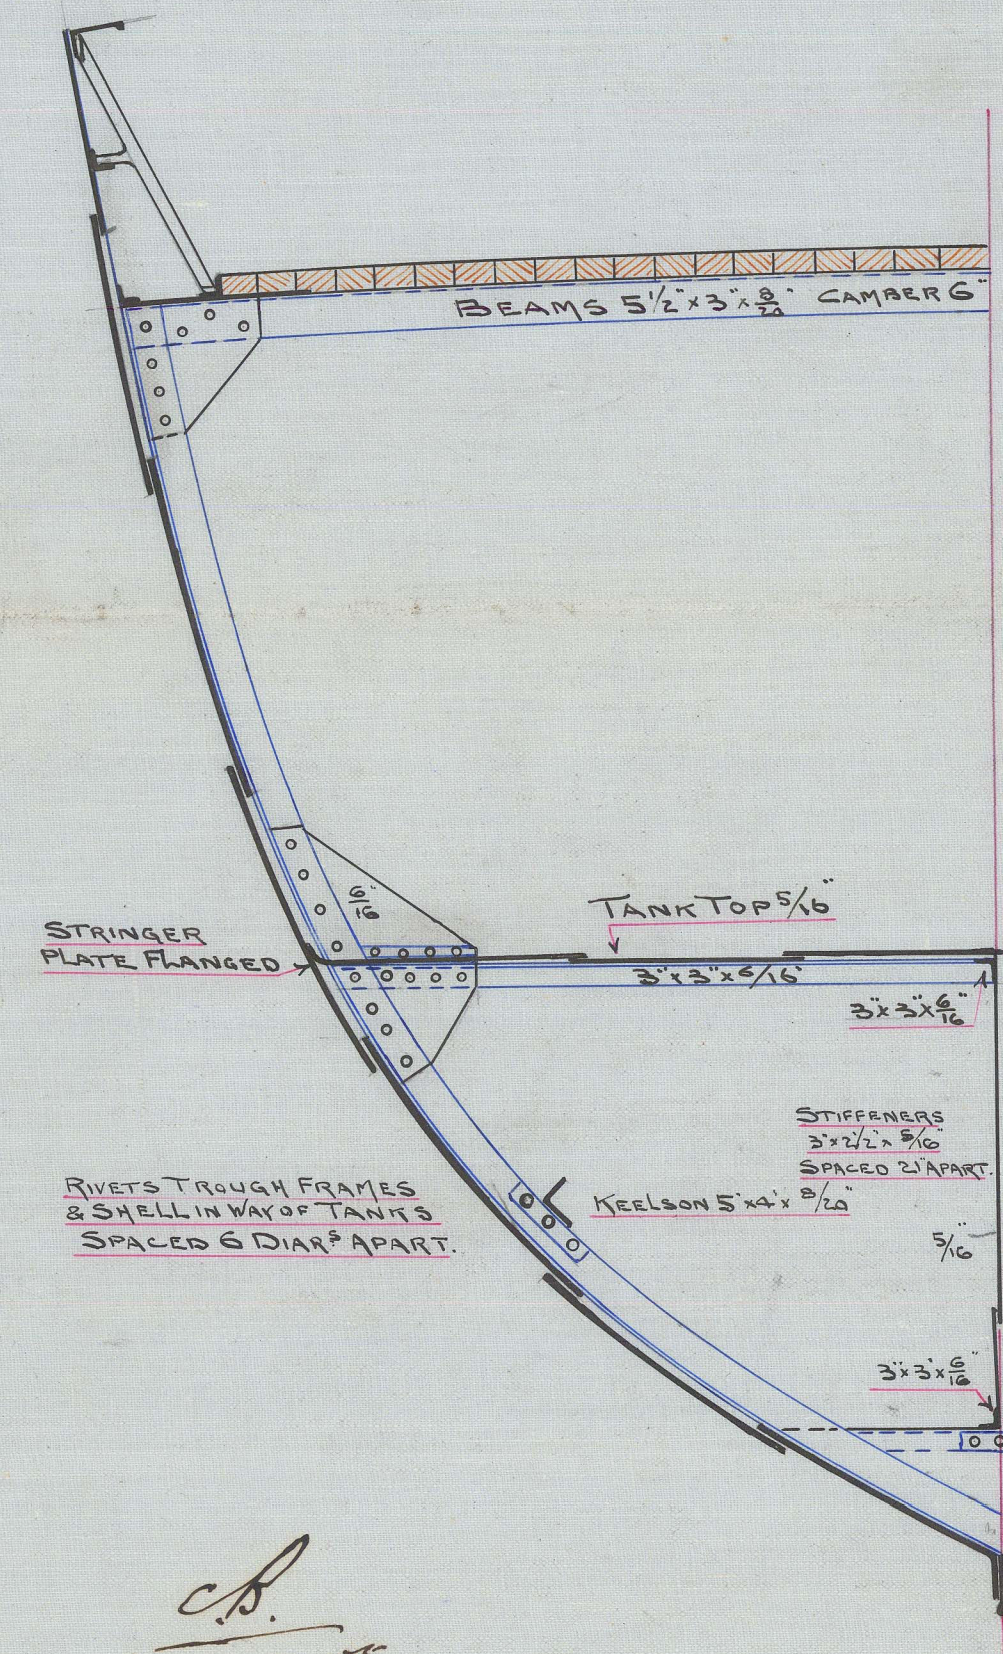


SECTION THROUGH BALLAST TANK
SCALE 1/2" = 1 FOOT.

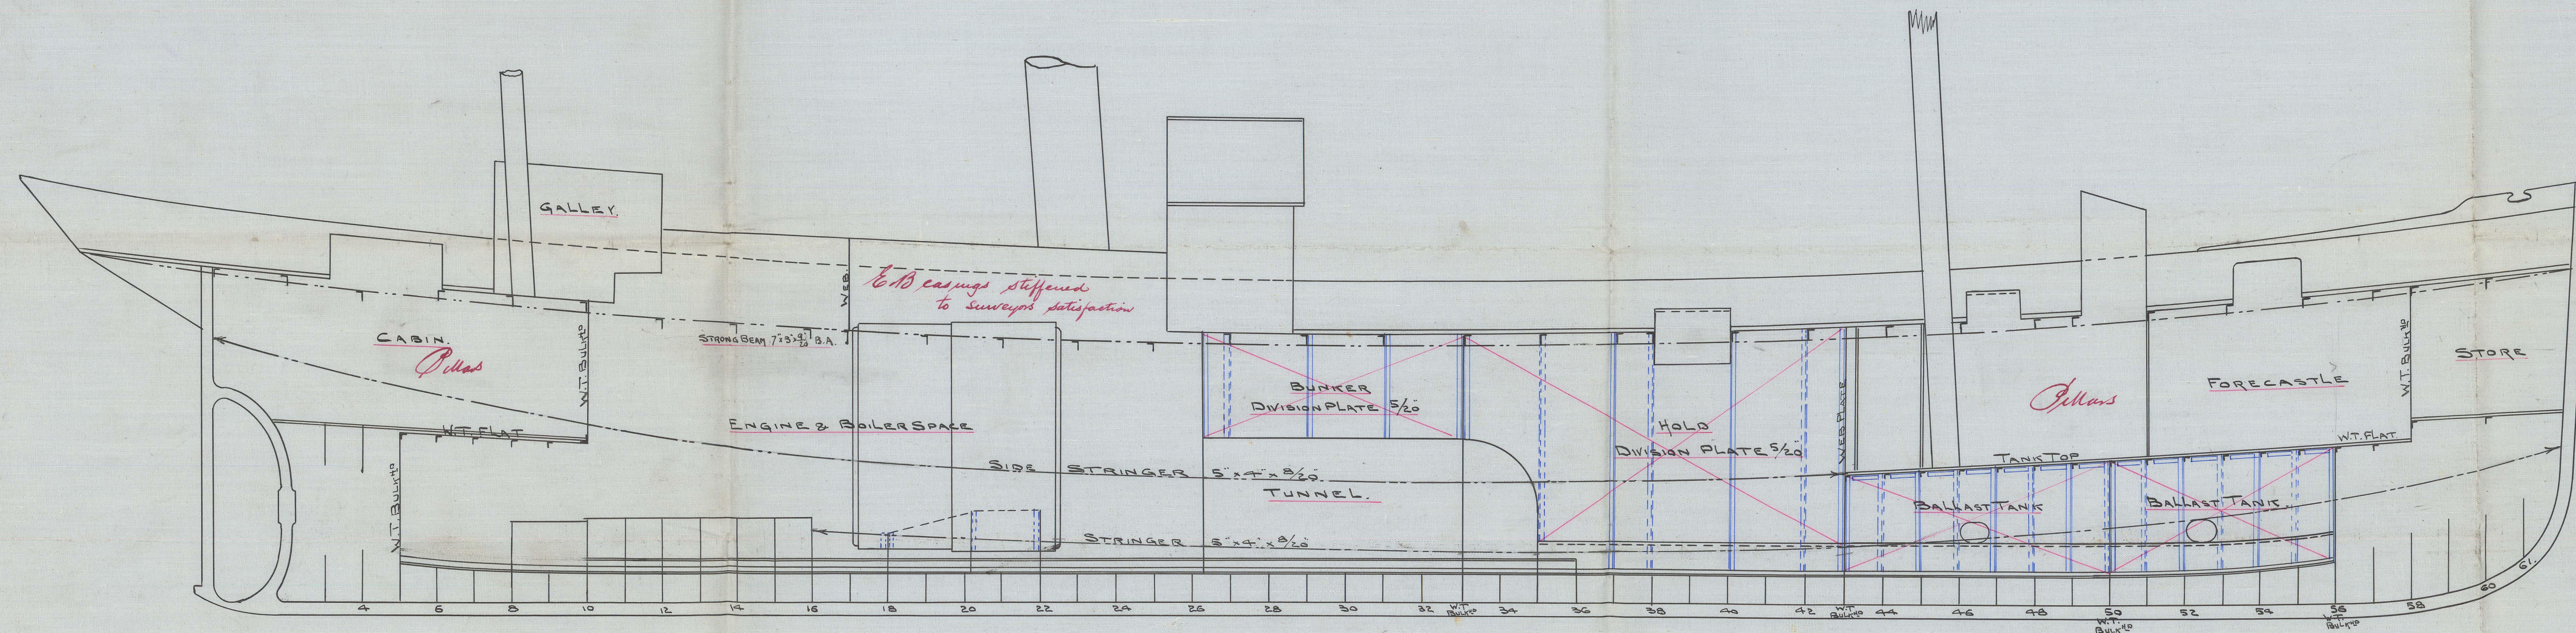

C.B.
10.4.05.

Goole S. & R. Co. Ltd.

No 81 + 82

Profile + Section in
way of Ballast Tanks


RETAIN

s/s Reeve

Hull Report No. 17405

s/s 'Raven'

Hull Report No. 17502

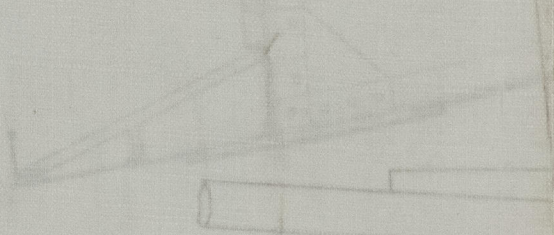

© 2021

Lloyd's Register
Foundation

W1565-0141