

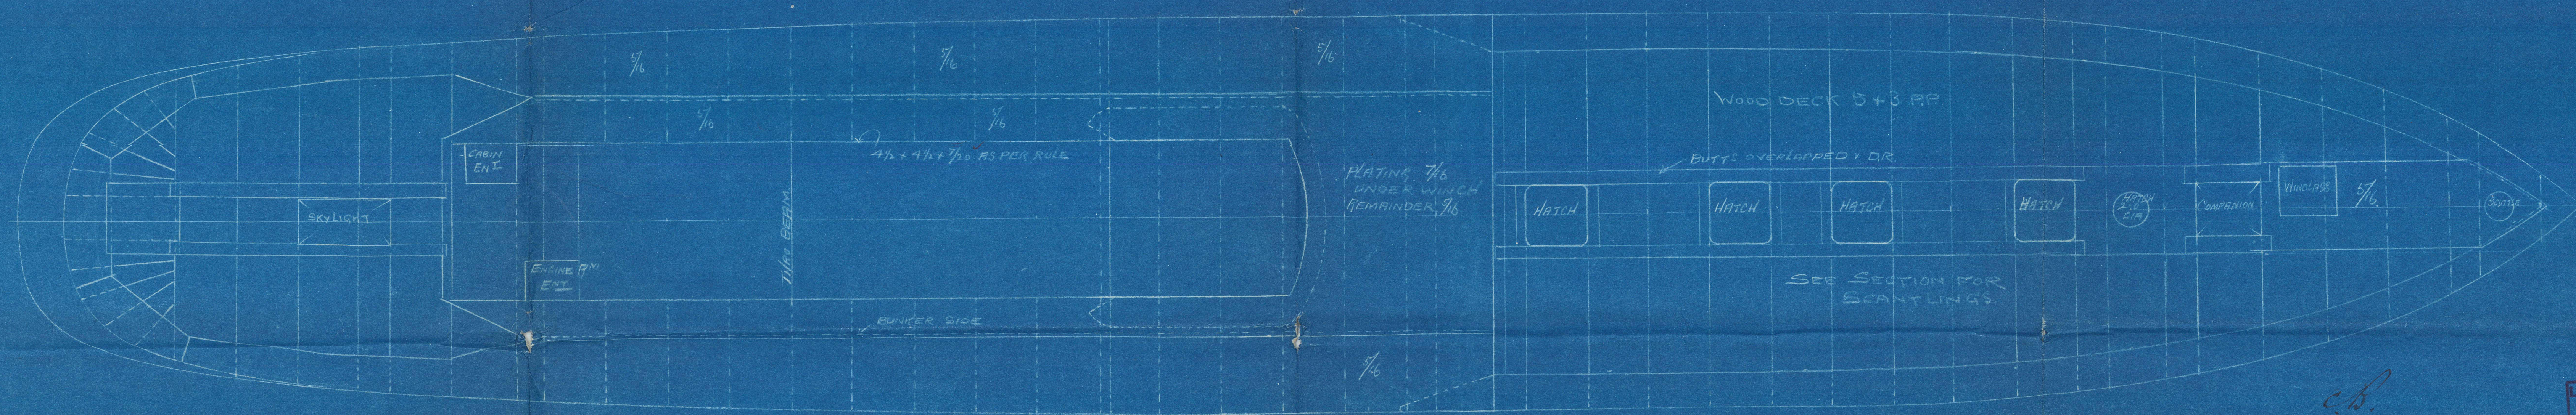
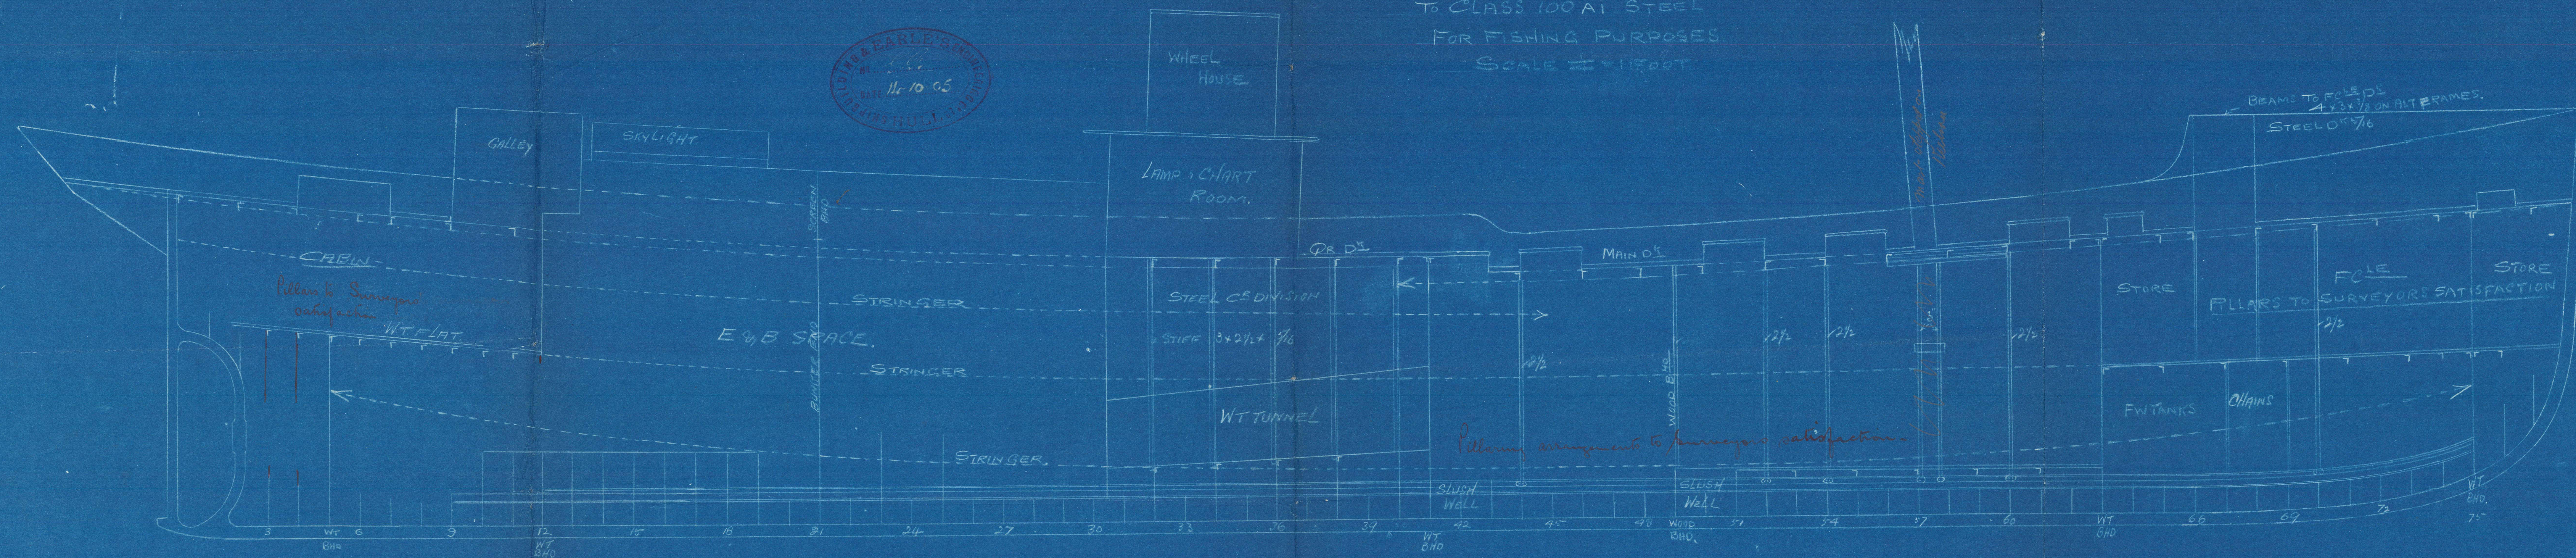


19.10.05

Nº 520
PROFILE & DECK PLAN
131'-8" BP x 22'-1" M² x 12'-10" M²
TO CLASS 100A1 STEEL
FOR FISHING PURPOSES
SCALE 1" = 1 FOOT

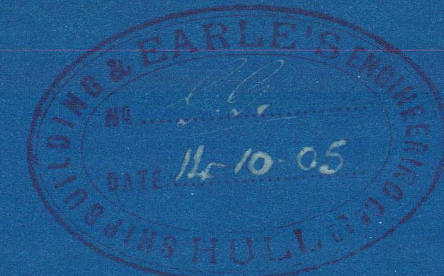

c.b.
19.10.05.

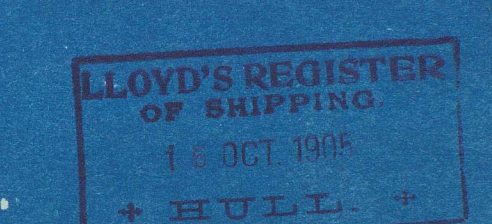


RETAIN

Earle's S. & R. Co.

No. 520.

Paper & Deck.

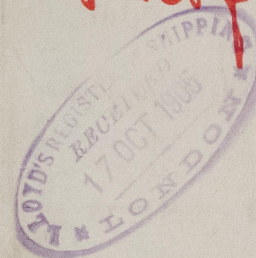

Spec North King
Hull Report No 17965



© 2021

Lloyd's Register
Foundation

W1567-0073