

$$B+D = 35.41$$

$$L \times (B+D) = 4142.97$$

$$\frac{d}{L} = 12.25$$

$$\frac{L}{D} = 86.$$

NUMERAL FOR RUDDER. 46.31. 4.10.15

# MIDSHIP SECTION.

## N° 372

DIMENSIONS: 117'-0" BP x 22'-0" EX x 12'-9" DEPTH OF HOLD.


SCALE 1/2" = 1 FOOT.

CLASS 100 A1. STEAM TRAWLER.

STEEL.

### EQUIPMENT

1 ANCHOR 5 1/4 CWT EX STOCK.  
7 " 4 3/4 " " "  
1 " 2 1/2 " " "  
90 FTMS 1" STUD LINK CABLE  
60 " 6" HAWSER.  
60 " 4 1/2" WARP.

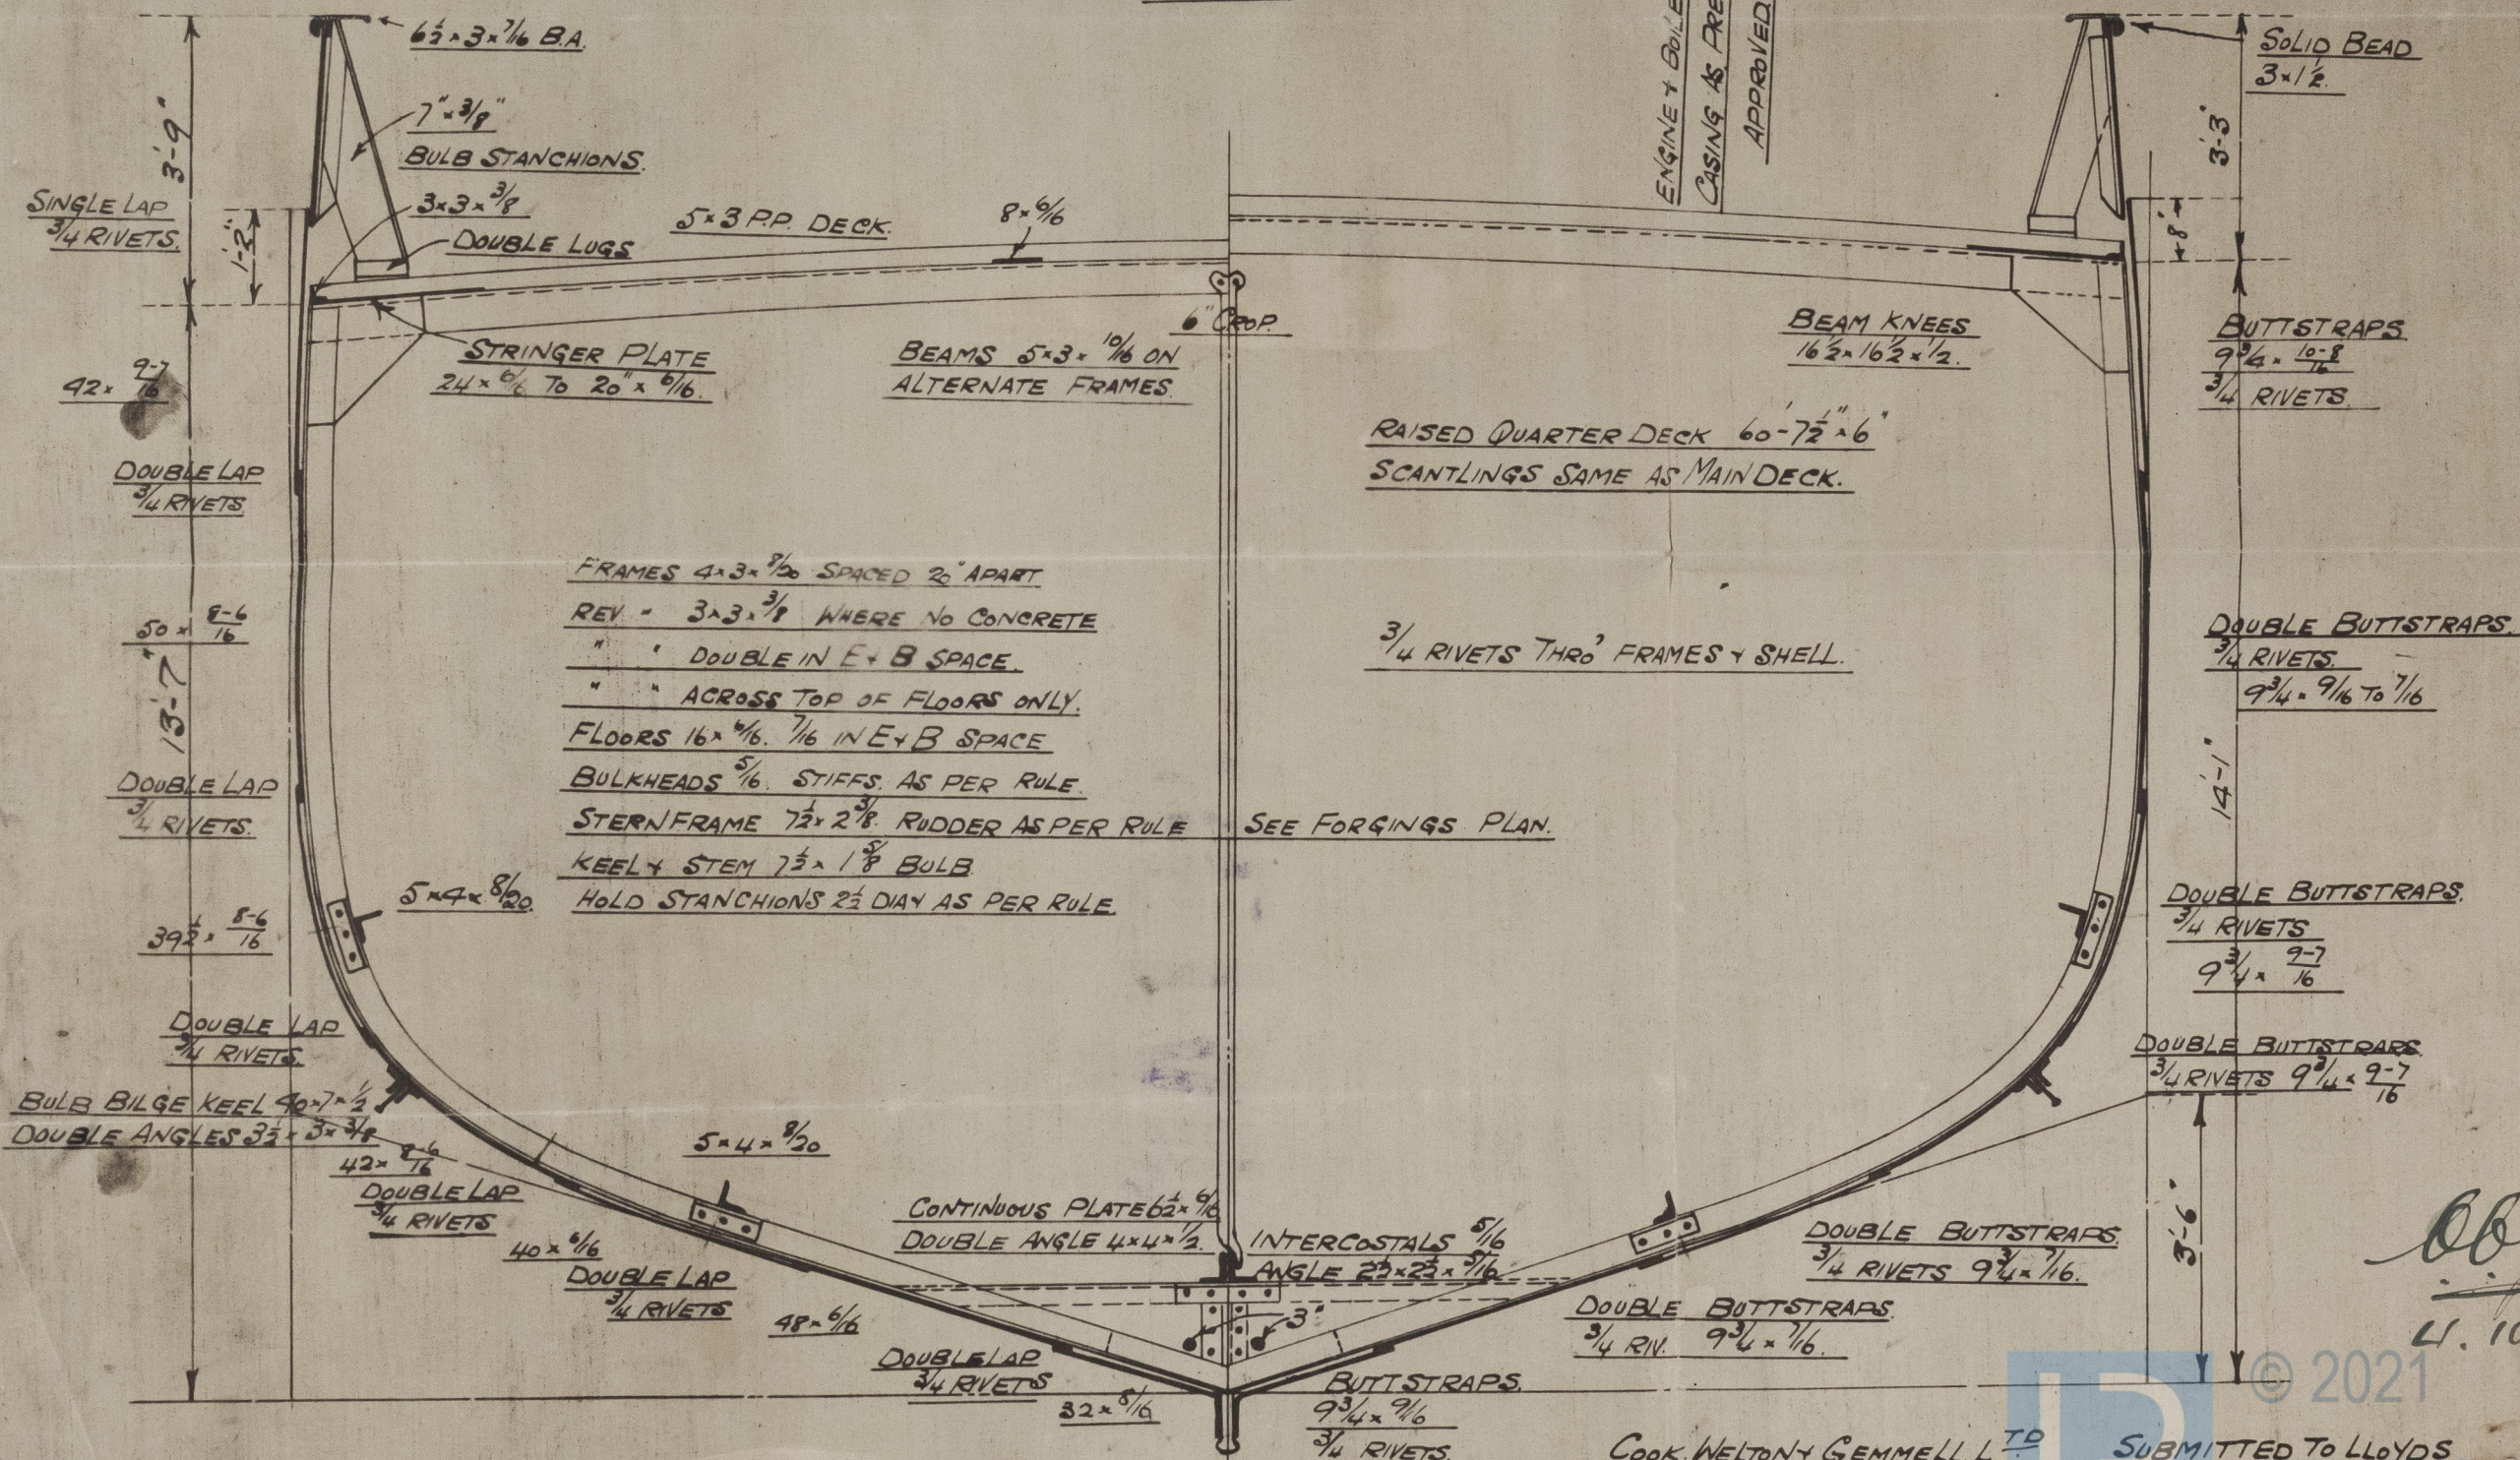

4.10.15


SUBMITTED TO LLOYDS  
APPROVED BY  
Lloyd's Register  
Foundation  
W1572-0027



Nº 372.

MIDSHIP  
SECTION

COOK WELTON & GEMMELL

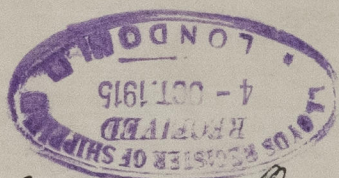

*S.S. "Raymont" Hull Rpt 10/27/15*



**RETAIN**



© 2021

Lloyd's Register  
Foundation

W1572-0027