

- MIDSHIP - SECTION -
S.S. 460' x 56' x 34' 6" [KEEL TO BEAM]

3. DECK RULE


Scale $\frac{1}{2}'' = 1$ foot.

$$28 + 57.25 + 34.5 + 33 - 7 = 113.08 \text{ FRAMING NO.}$$
$$113.08 \times 457.91 = 51780 \quad \text{PLATING NO:}$$
$$120.08 \times 457.91 + 6308.75 = 61294.58 \text{ EQUIPMENT NO.}$$

PROPORTIONS.

DEPTHS TO LENGTH (UPPER DK) 13.17

BREADTHS TO LENGTH: 8.17.

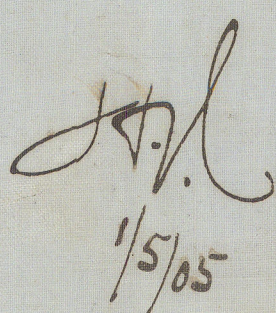

Miss^{rs} Harland & Woelfel

T.S.S. 381

Midship Section

Cancelled 13/6/08 *LP*

RETAIN

W1572-0065

No:

MIDSHIP

2.2 400' x 20' x 3'

20 CLASSES

200/10

R

NAME

150.00 x 425.21 = 63783.00
118.00 x 425.21 = 50164.38
58 + 20.50 + 37.2 +

© 2021

Lloyd's Register
Foundation

BREEDING
906678