


1.5.05  
13.6.05  
21.7.05  
9.1.06  
10.1.06  
2.7.06

 

N° 381  
LONGITUDINAL ELEVATION  
S.S. 460'-0" x 56'-0" x 34'-6" (HEEL TO BURN)  
SCALE 1" = 1 FOOT

1.5.05  
13.6.05  
21.7.05  
9.1.06  
10.1.06  
2.7.06

REMAIN

15/05



to 420 ft.  
no. 11  
288888


Messrs Harland & Wolff

T.S.S. 381.

Profile

~~Amundsen~~

"Pohilla"  
Bel 6219.

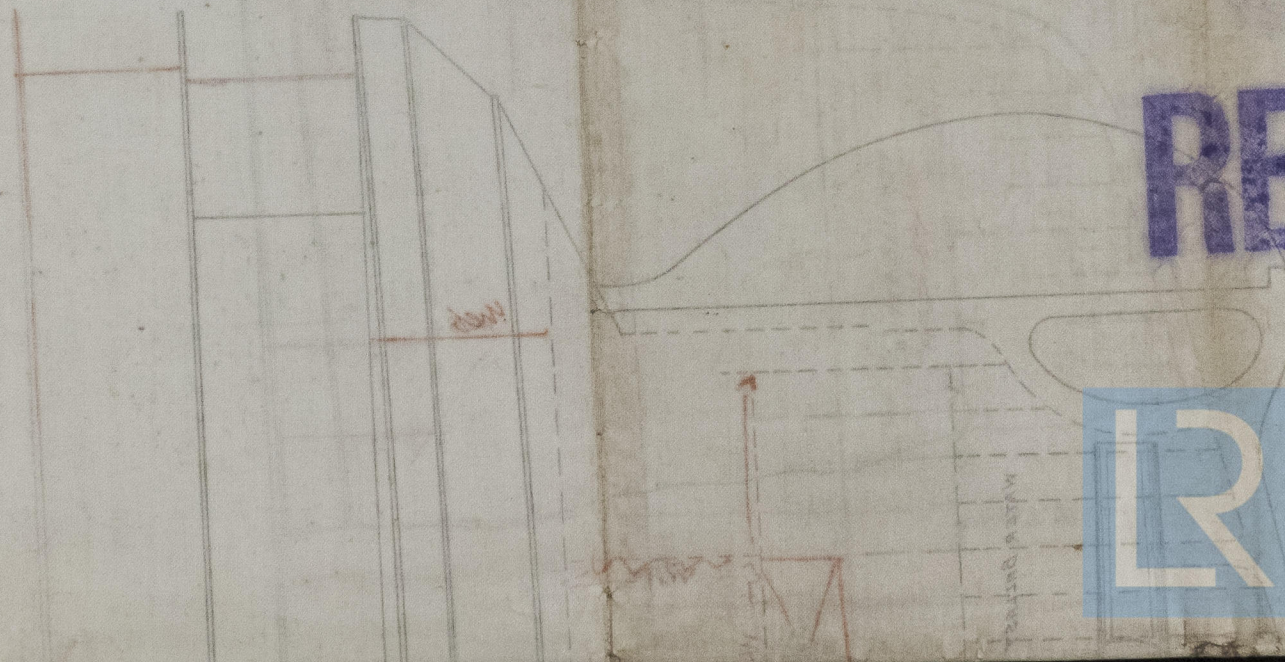

RETAIN



© 2021

Lloyd's Register  
Foundation  
W1572-0067