

N^o 1626 MULTITUBULAR BOILER FOR MESSRS JOS. T. ELTRINGHAM & CO^s N^o 272 5/16

N^o 1627

N^o 273

1 1/8 HOLES 6 5/8 APART. 83 %

WORKING PRESSURE 180 LBS PER SQUARE INCH.

SCALE 1" = 1 FOOT.

TESTED TO LLOYDS REQUIREMENTS.

23/4/09

MATERIAL.

ALL PLATES, RIVETS AND

STAYS OF STEEL

TUBES OF IRON.

HEATING SURFACE.


TUBES --- 1077 SQ. FT.

FURNACES -- 143

C. CHAMBERS. 170

TUBE PLATES. 49

TOTAL 1439 SQ. FT.

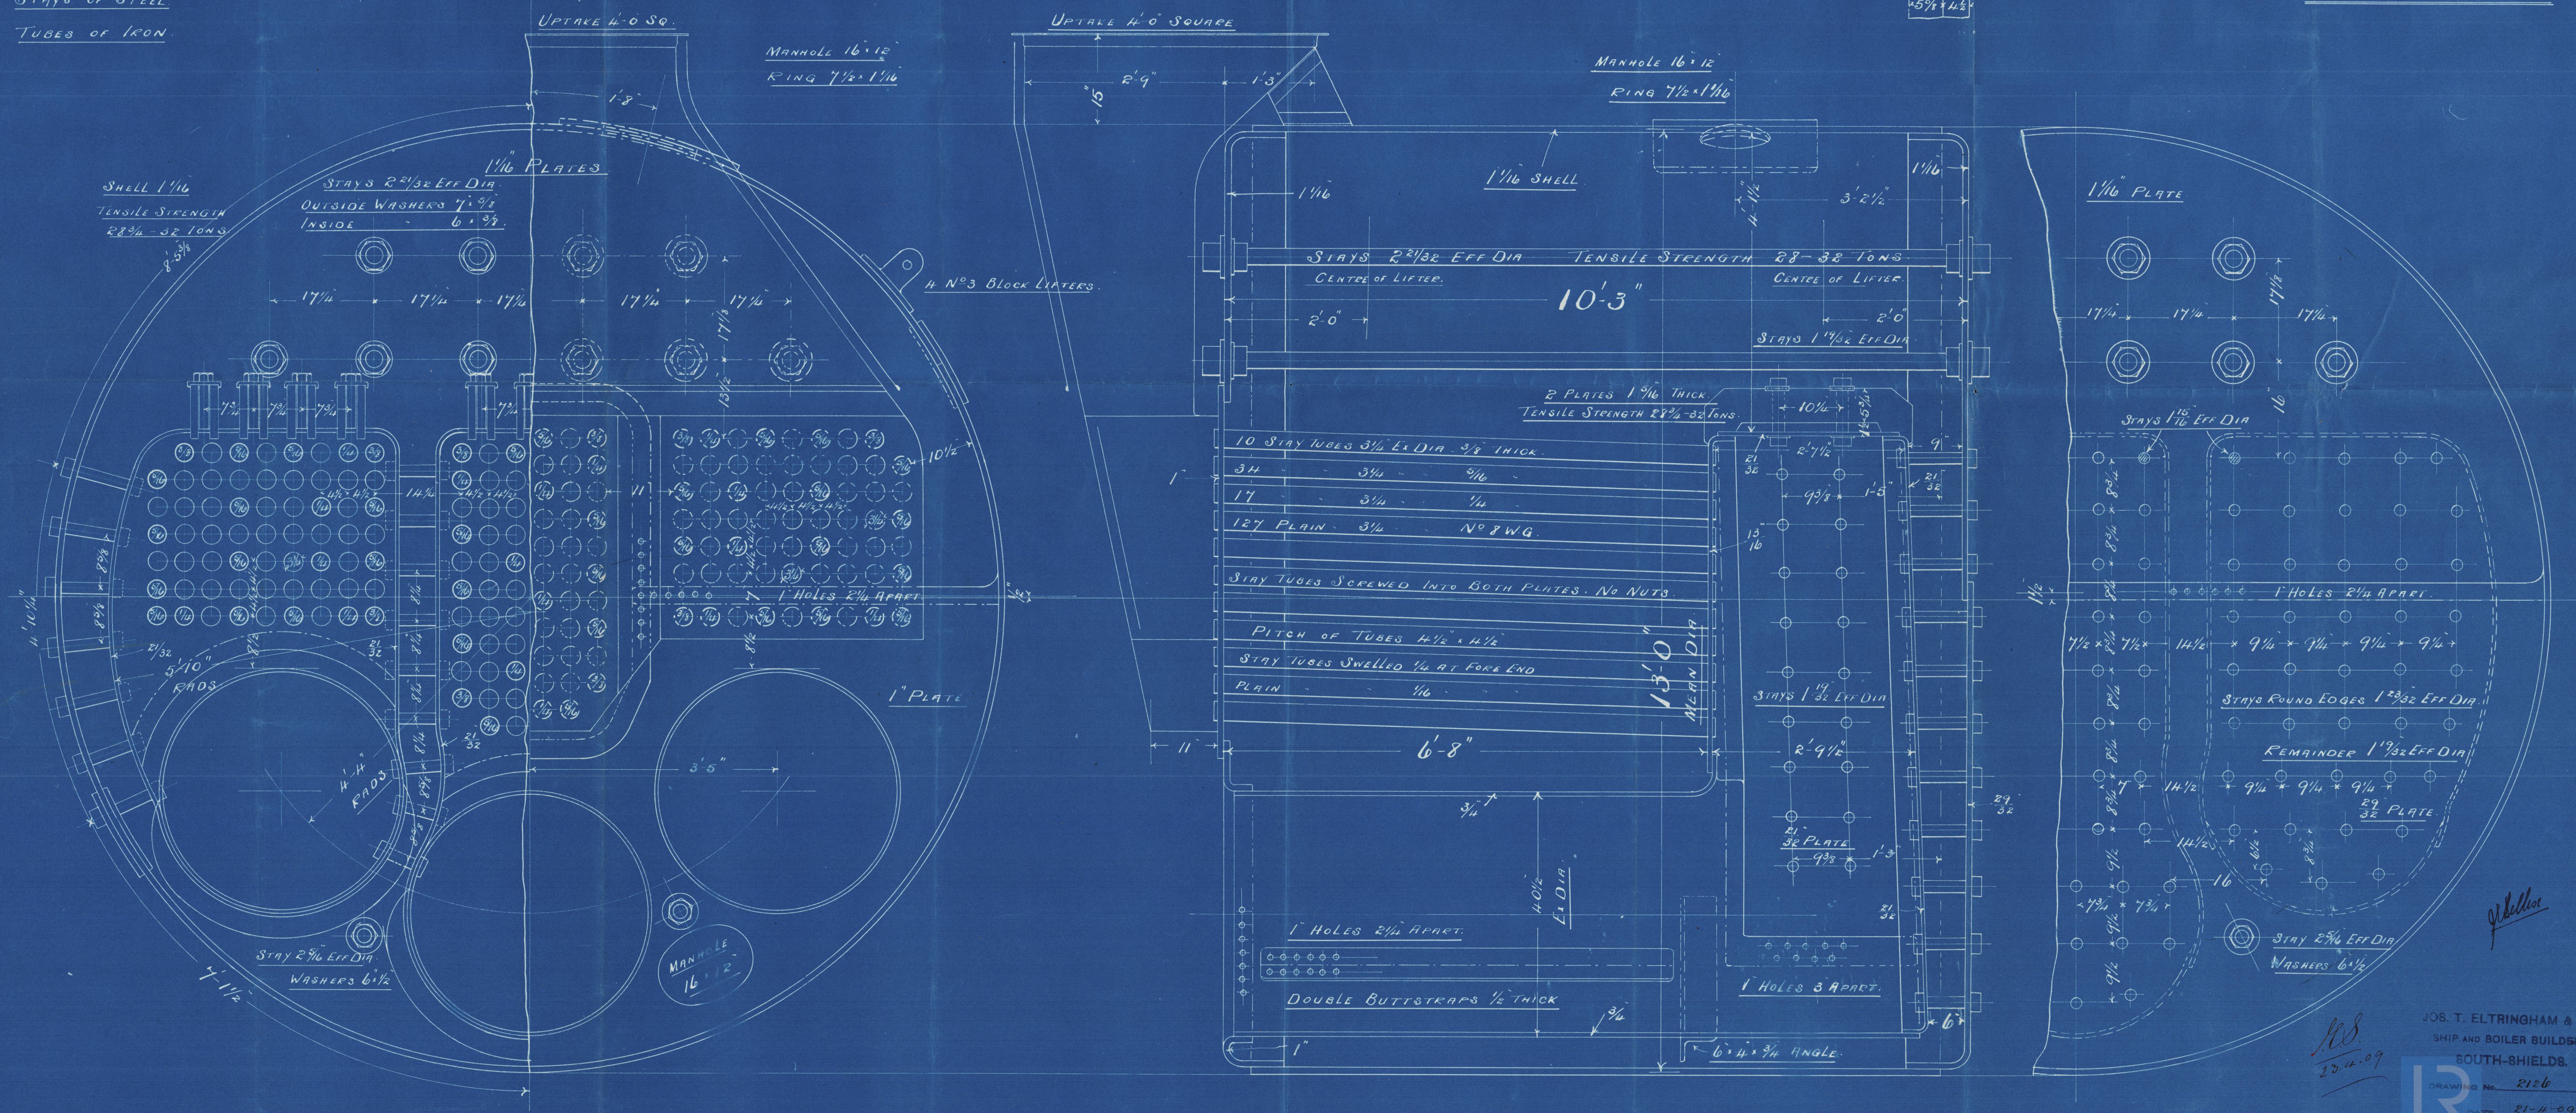

JOS. T. ELTRINGHAM & CO.,
SHIP AND BOILER BUILDERS,
SOUTH-SHIELDS.
DRAWING NO. 2126
DATE 21-4-09

Newcastle on Tyne

Boilers No 1626 & 1627.

180 lbs pressure.
S.S. "St Louis No 1"

Newcastle Post Office

No 1626 57279

No 7871.
LLOYDS TEST
360 LBS
15-7-09. W.L.


S.T. St. Lawrence
Eltham 272 s.

No 1624

No 4844
LLOYDS TEST
360 LBS
26-4-09

S.T. St. Louis No 1
Eltham 273 s.

RETAIN

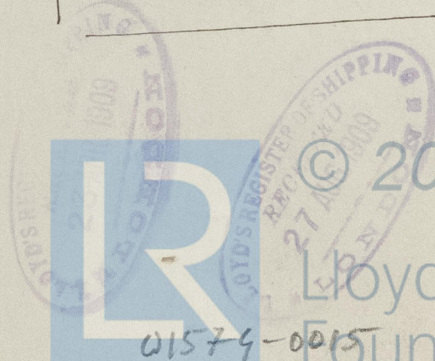

© 2020

Lloyd's Register
Foundation

01574-0015

ENCLOSURE

JOS. T. ELTRINGHAM

To

Messrs Lloyd.

NE

W1574-0015 ^{1/2}