


29.12.09 (hr. 413)
20.1.10 (hr. 416 & 417)
9.1.10
3.3.10

SCALE $\frac{1}{2}" = 1 \text{ FOOT}$.

— PROPORTIONS

FORMULATIONS		FORMULATIONS	
$35.25 + 21$	RISE OF SHEER + 58 = 93.46	TRANSVERSE №	13.25 DEPTHS TO UPPER DECK
93.46×469.83	= 43910	LONGITUDINAL №	10.87 " " BRIDGE "
$43910 + 1715$	= 45625	EQUIPMENT №	8.1 BREADTHS TO LENGTH

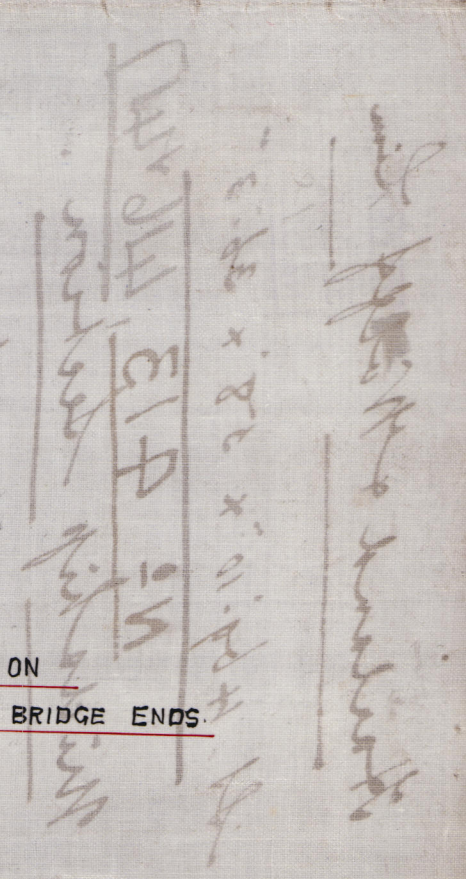

C.F.
29/12/09.

Harland & Wolff Lim

12
St. 469' 10" x 58' x 36' 3"

N^o 413, 416 & 417
Midskip Section.

amended.

RETAIN

