


27.8.07

PROFILE AND DECK PLAN
RENNOLDSON'S N° 254 SHIP
SCALE $\frac{1}{4}$ " = 1 FOOT
DIMENSIONS 80' x 20' x 10' 0" MO
CLASS LLOYDS 100A1 TOWING PURPOSES

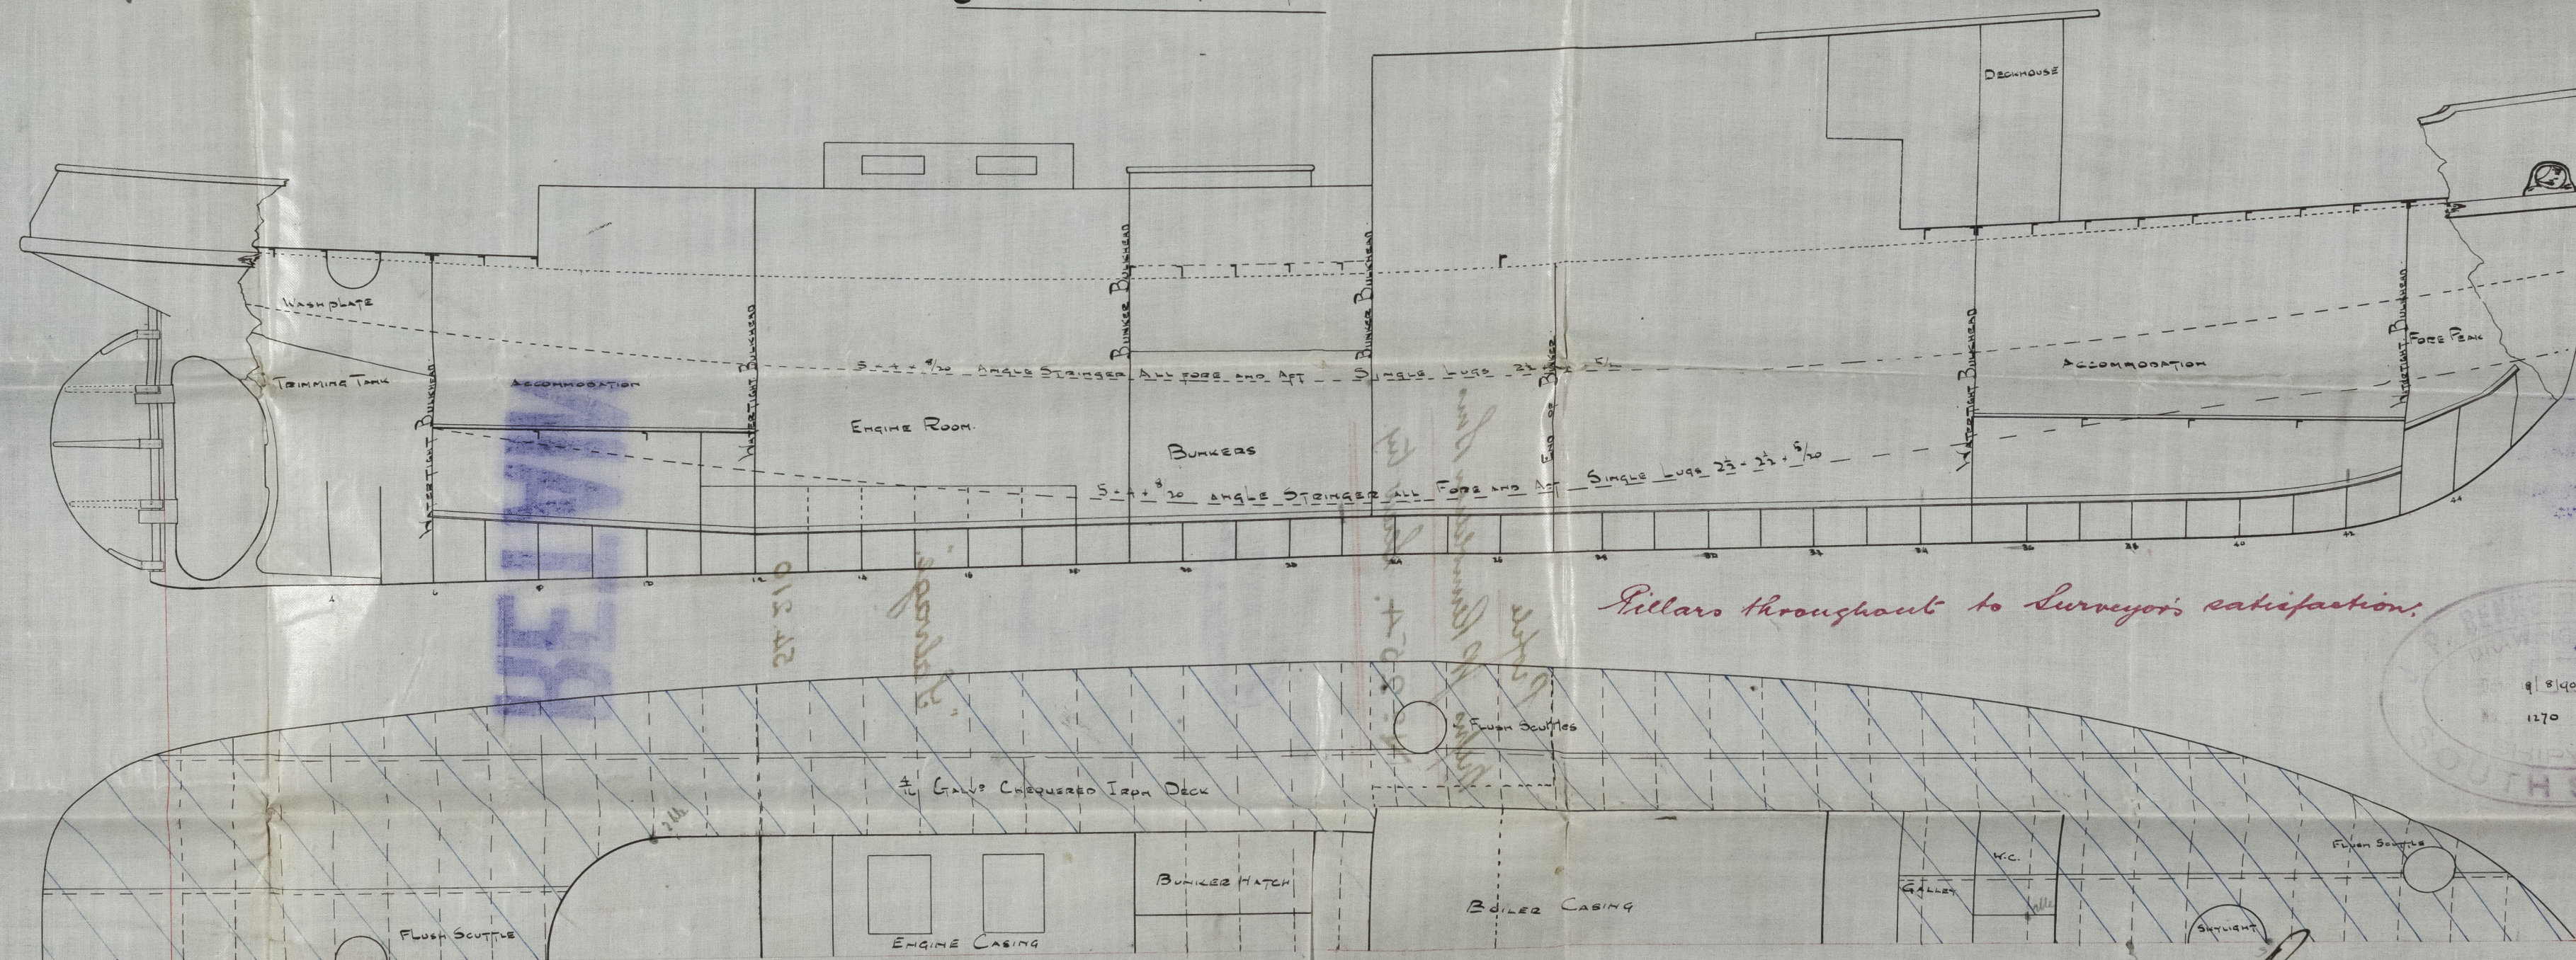


C.B.
27.8.07.

Profile

Messrs J P Remoldson Sons

No 254. Screw try.

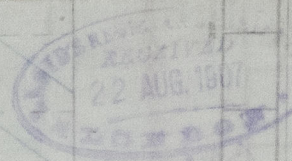

"Salvage."

54.210

RETAIN

© 2020

Lloyd's Register
Foundation

W1575-0029

