

16.3.10 Lloyd's Surveyors.  
Hull.  
DATE 10/3/10. R.H.

# MIDSHIP SECTION

STEEL SCREW TRAWLER

N<sup>o</sup> 464

DIMNS 117'-6" x 21'-6" x 12'-6" M<sup>L</sup>D.

SCALE 1/2" = 1 FOOT

TO CLASS 100A.1 AT LLOYDS FOR FISHING PURPOSES

*noted libary 11-11-10*  
*and 11-11-10*

NUMERALS

|                                       |   |         |
|---------------------------------------|---|---------|
| B + D                                 | = | 34      |
| L x (B + D)                           | = | 3995    |
| 9 <sup>th</sup> DECK 65.95 x 1        | = | 65.95   |
| For 1 <sup>st</sup> DECK 13.29 x 1.75 | = | 13.71   |
| EQUIPMENT N <sup>o</sup>              | = | 4074.66 |

*cannot remove if  
55255 10/11/10*


PROPORTIONS

|     |   |      |
|-----|---|------|
| L/D | = | 9.4  |
| L/B | = | 5.46 |

EQUIPMENT

|                              |                 |
|------------------------------|-----------------|
| 1 <sup>st</sup> BOWER ANCHOR | 5A CWB EX STOCK |
| 2 <sup>nd</sup> BOWER        | 4 1/2 " " "     |
| KEDGE ANCHOR                 | 2 1/2 " " "     |
| 90 FATH <sup>s</sup>         | 1' CABLE        |
| 60 FATH <sup>s</sup>         | 6' HAWSER       |
| 60 FATH <sup>s</sup>         | 4 1/2 WARP      |

**RIVETING**  
BUTTS OF SHELL PLATING STRAPPED & DOUBLE RIV  
EXCEPT CARBOARD & SHEERSTRAKE WHICH  
ARE TO BE STRAPPED  
LANDINGS DOUBLE RIV, BULWARKS SINGLE RIV  
BUTTS OF STRINGER & TIE PLATES OVERLAPPED  
& DOUBLE RIVETED

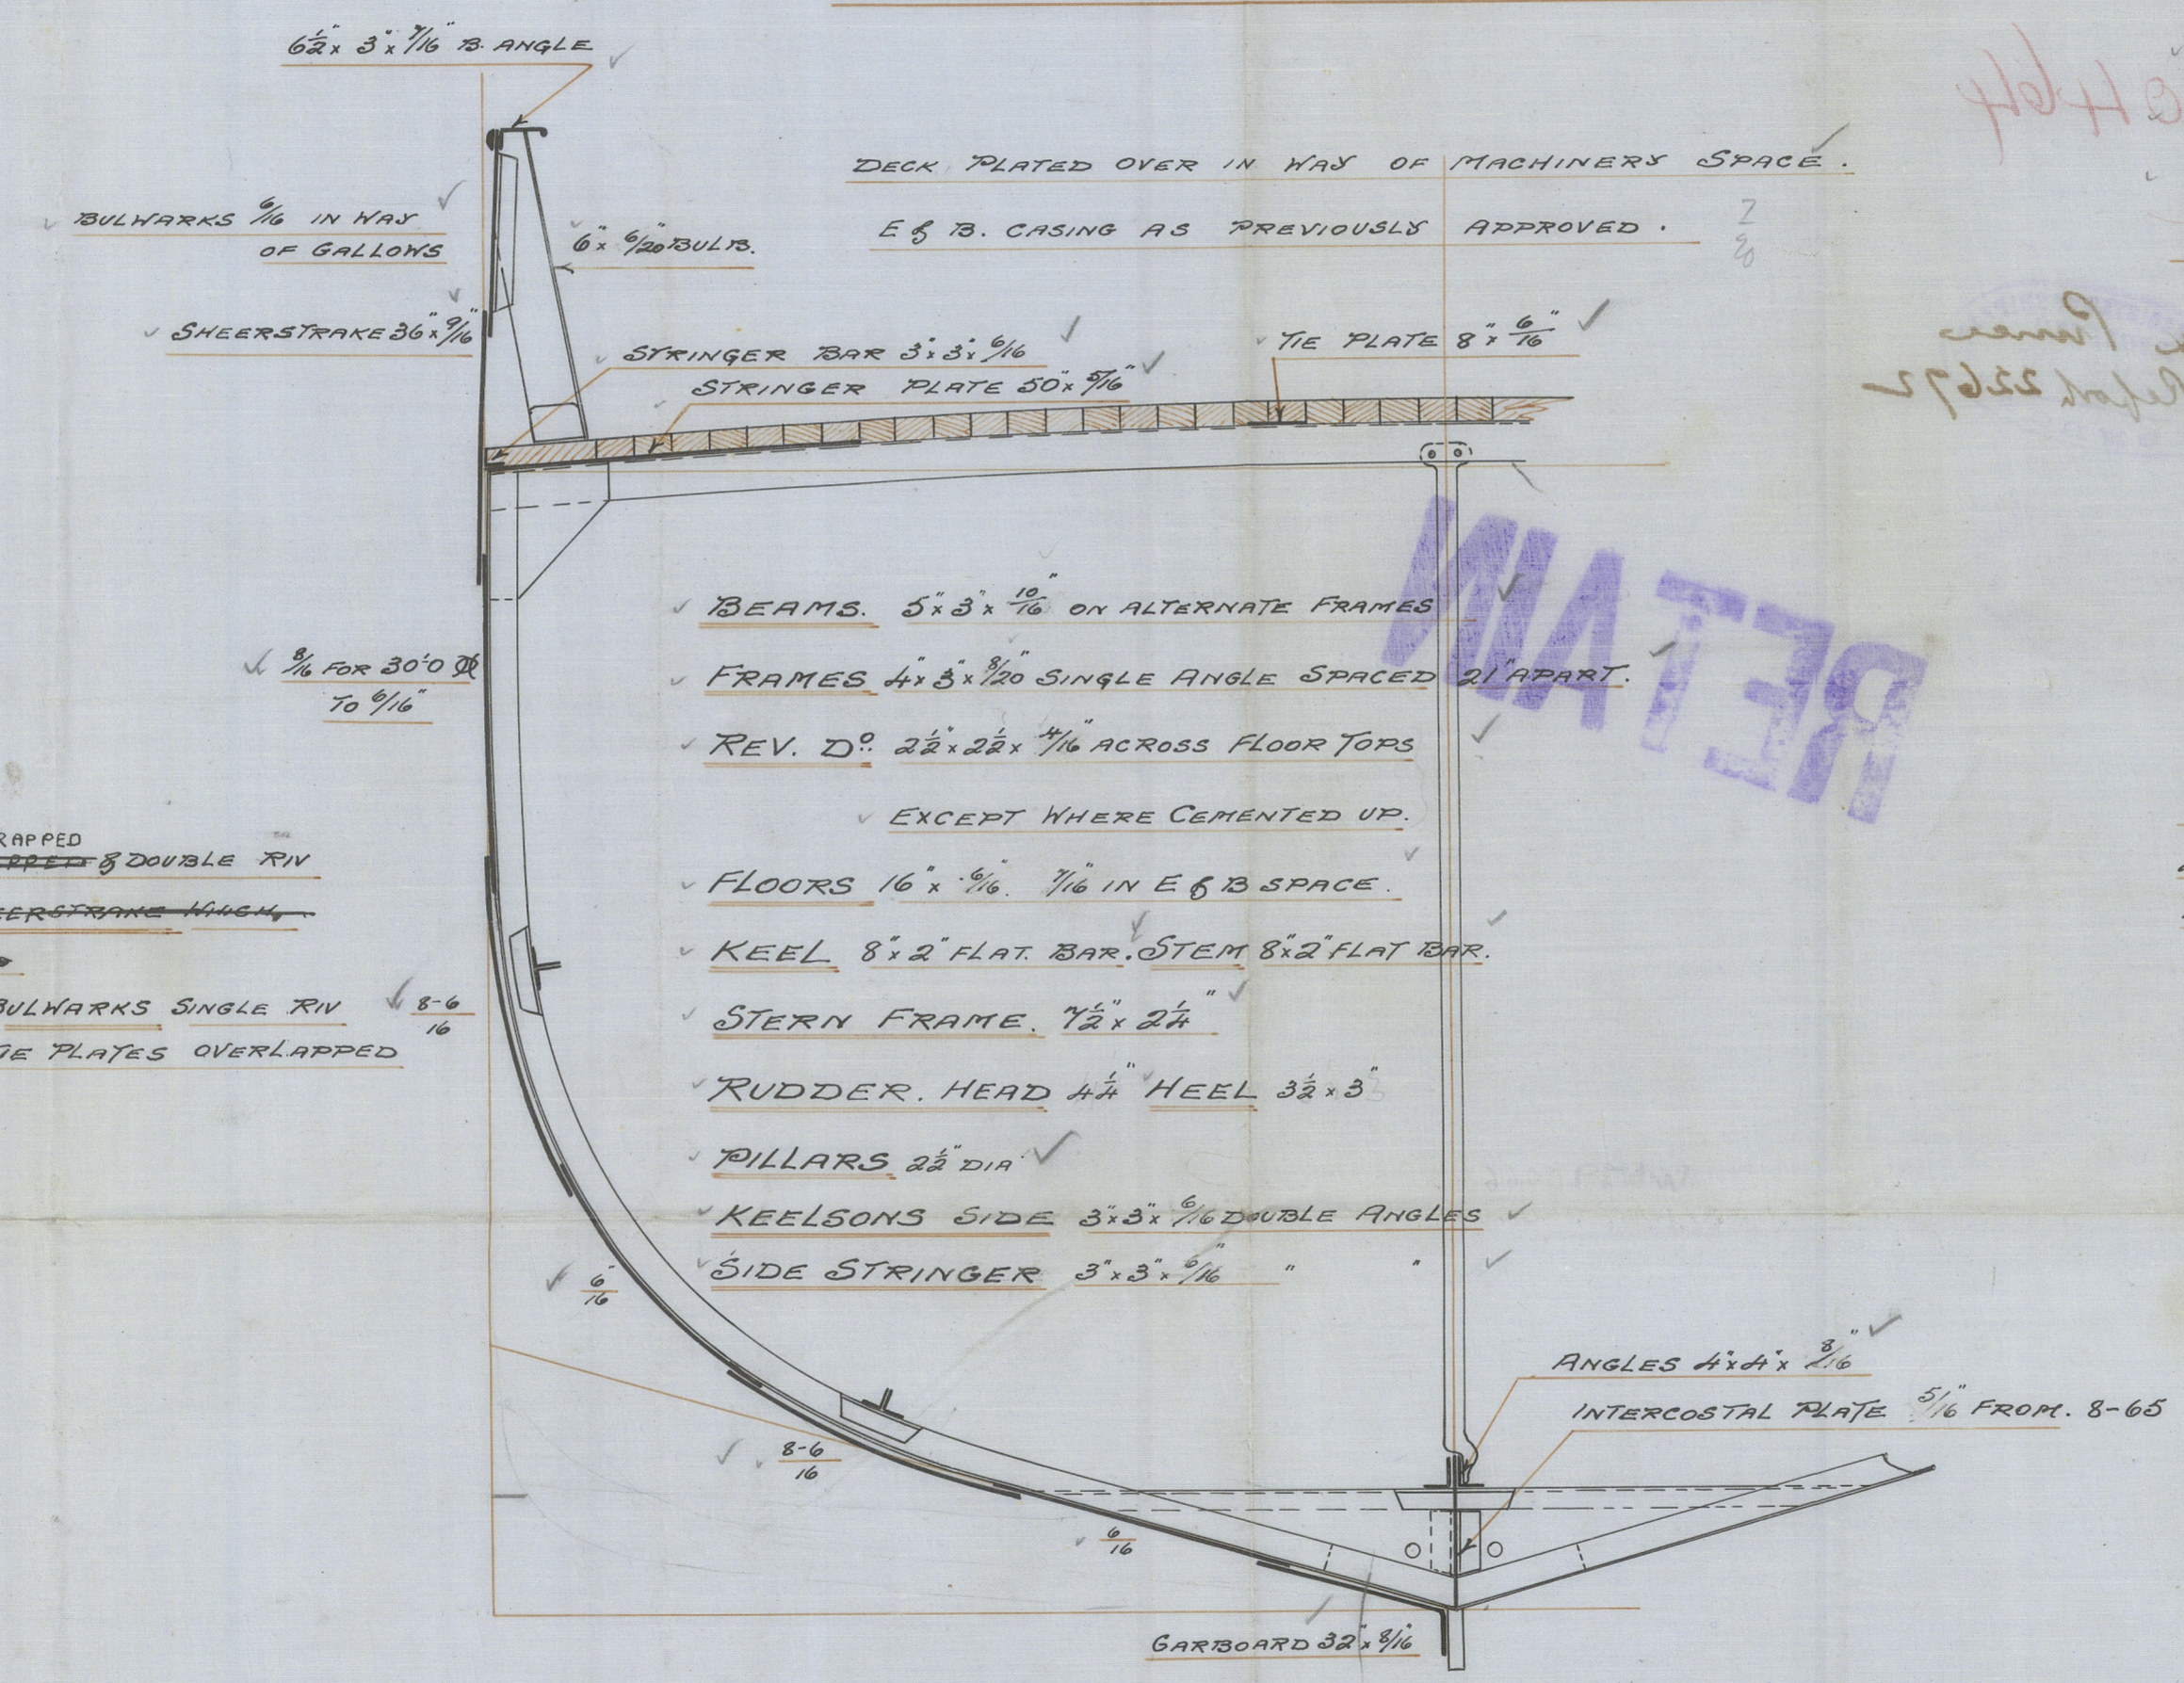

LLOYD'S REGISTER  
OF SHIPPING  
11 MAR 1910  
HULL

C.T.  
10/3/10

- Midship Section

Cochrane & Sons

No 464

1/2 Mary Pinner

Hull Reford 22672

RETAIN



© 2021

Lloyd's Register  
Foundation