

16.3.10

PLAN No. 909H.  
FOR ENCLOSURE TO  
Lloyd's Surveyors.  
Bull. FROM  
CUSHMAN & COY.  
SHIPBUILDERS LTD.  
DATE 10/2/10 R.H.



# PROFILE + DECK PLAN.

Nº 464

DIMS 117'-6" x 21'-6" x 12'-6" M.P.

SCALE 1/4" = 1 FOOT

NOTE PILLARS THROUGHOUT TO SURVEYORS. SATISFACTION.

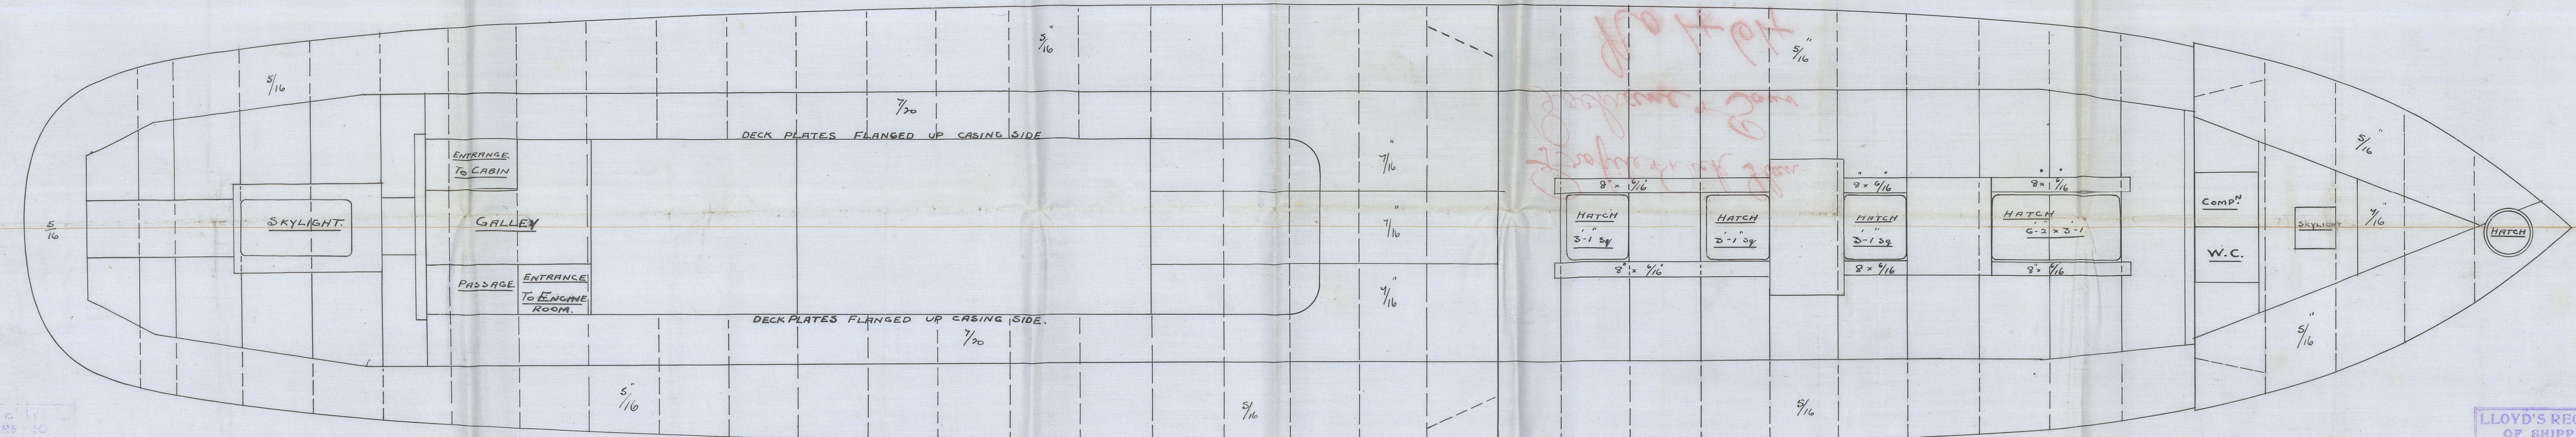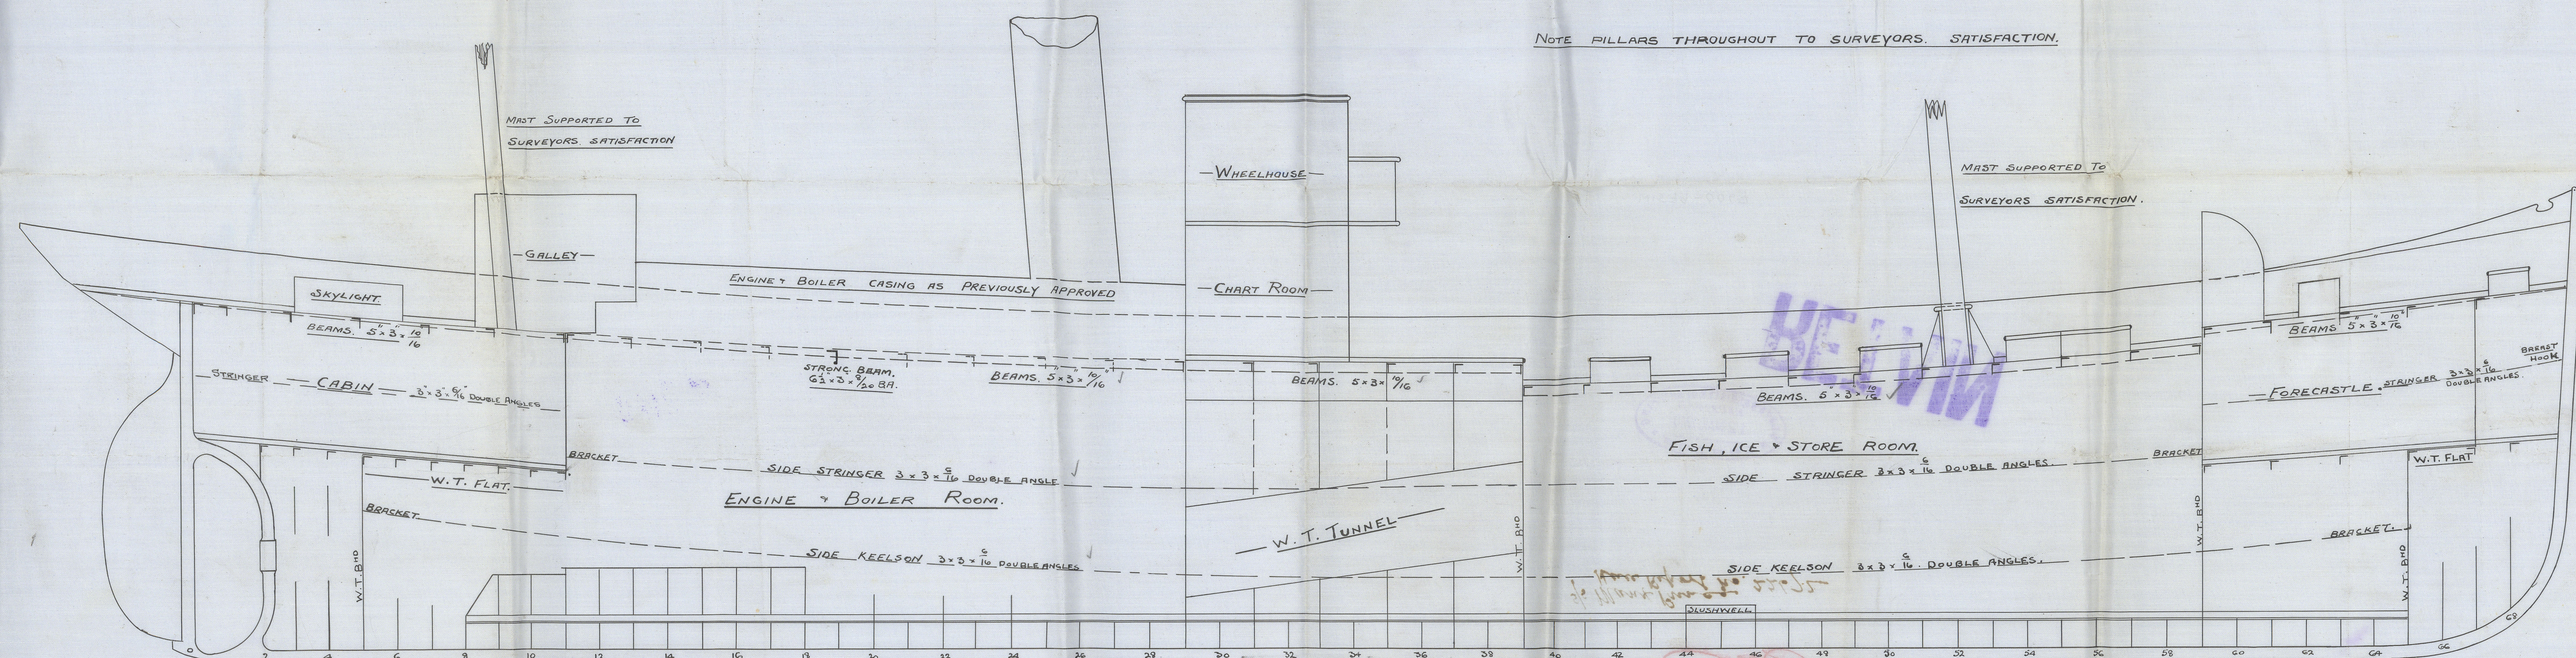

LLOYD'S REGISTER  
OF SHIPPING.  
11 MAR 1910  
+ HULL +

C-2  
16/3/10



Profile & Deck Plan

Cochrane & Sons

No 464 <sup>2 1/2</sup>

*M*

S/S Manx Prince  
Hull Report No. 22672

RETAIN



© 2021

Lloyd's Register  
Foundation

7900-0651M