

15.3.19.  
31.3.19.  
31.5.19.


# PROFILE.

PROPOSED T. S. S. 390' x 52'-5" x 26' MLD.

SCALE 1/8" = 1 FOOT.


TO CLASS LLOYD'S HULL (SHADE DECK)

NOTE. FIGURES IN BRACKETS ARE SUBSTITUTED TO  
SUIT PRESENT CONDITION OF STEEL MARKET

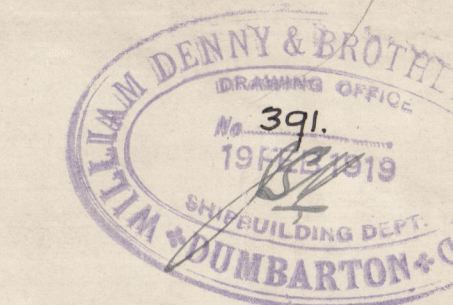

Lloyds

PLAN OF GIRDERS IN DEEP TANK.

 

Sketch in way of coal shoot  
to be submitted for consideration

Winders, windless to be  
submitted to Surveyor's satisfaction.

See 22 Para 12.

Oil Fuel

ALTERNATIVELY:-  
SOLID ROUND PILLARS IN FORE HOLDS  
AS PER MIDSHIP SECTION 2 frame spaces apart  
increased for length




Profile

Messrs W Denny & Bros Ltd

~~Refers~~ T.S.S 390 long


No 1141.

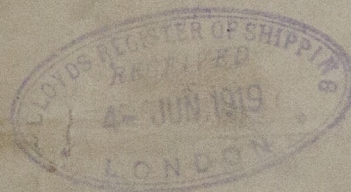

GLASGOW REPORT No. 41698

J.S. Chilka

W158-0029

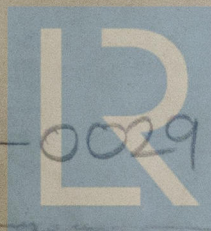

© 2020

Lloyd's Register  
Foundation