


TO CLASS 100A1 AT LLOYDS

MIDSHIP SECTION

SCALE 1/4" = 1 FOOT

DIMENSIONS: 42' 11" B.P. x 55' 8 1/2" MLD x 56' 0" EXT x 31' 3 1/4" MLD TO UPPER DECK

MILLAR'S SYSTEM OF FRAMING
(PATENTED)

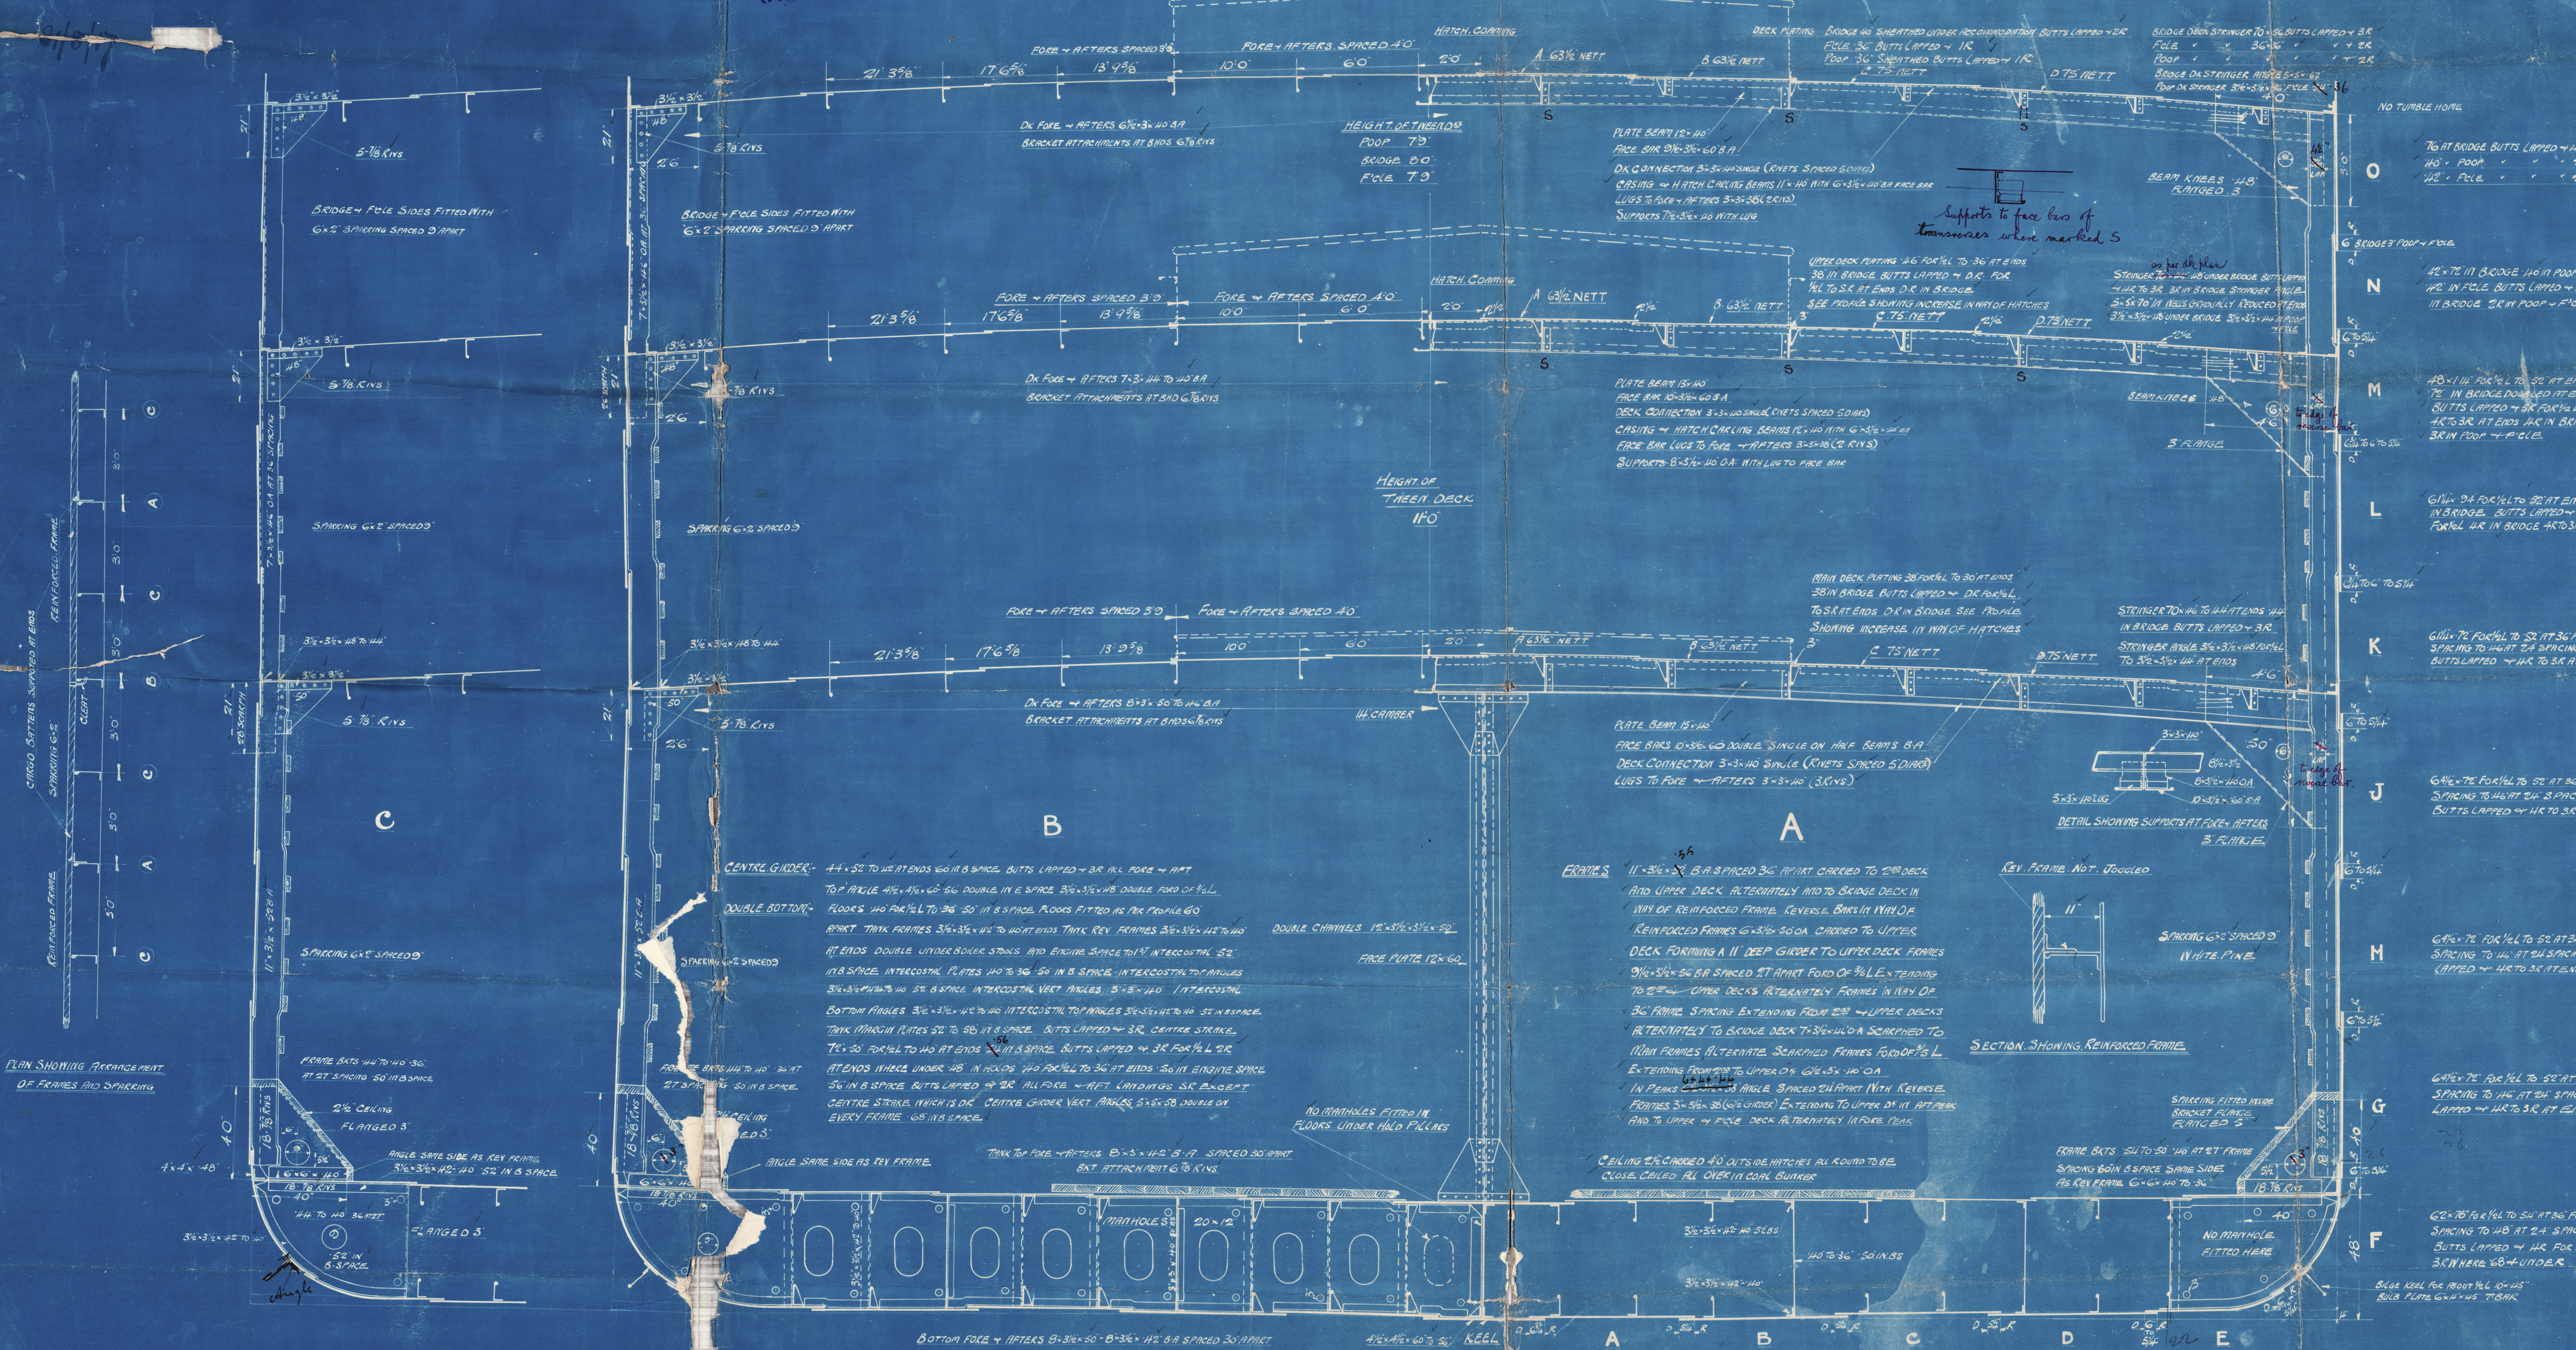

NUMERALS

| | |
|---|----------|
| 510 - 87 - TRANSVERSE N° | |
| L (LONG) - 367937 - LONGITUDINAL N° | |
| TANK TOP TO 2 ND DECK AT SIDE - 6.31 | |
| UNDER 16 WITH INCREASED BATS | |
| TANK TOP TO UPPER DECK AT SIDE 27.31 | |
| 2 ND DECK | CR 17.44 |
EQUIPMENT N°

| | |
|-----------------|--------|
| LONGITUDINAL N° | 367937 |
| POOP - F.C.E. | 500 |
| BRIDGE | 1524 |
| OTHER ERECTIONS | 356 |
| EQUIPMENT N° | 30173 |

EQUIPMENT

| | |
|------------------|---------------------------------|
| 1 BOMER ANCHOR | STOCK LESS 60 CENTS |
| 1 | 60 |
| 1 | 58 1/2 |
| 1 STREAM | E- STOCK 19 |
| 1 KEDGE | 8 |
| 270 FATHOMS | 2 1/2 STD CHAIN CABLE |
| 90 | 5 STEEL WIRE |
| 120 | 5 1/4 TONLINE |
| 2 OFF 90 FATHOMS | 3 MANILLA OR 2 1/4 S.W. HANKERS |
| 2 | 7 2 1/2 HANKERS |

RIVETING

| |
|--|
| FRAMES TO SHELL 5/16 DIAM AT 36" SPACING |
| KEY FRAMES 5/16 DIAM AT 36" |
| DK FORE + AFTERS 5/16 DIAM AT 36" |
| DK FORE + AFTERS BUTTS 5/16 DIAM EACH SIDE OF BUTT |
| STEM 10 1/2 x 2 1/4 |
| RIDDER POST 3 x 5 |
| PROPELLOR POST 10 1/2 x 8 |
| PROPELLOR BOSS PLATES 76 |

BRYN & GYLSSEN, LTD.
RIVER CLYDE SHIPBUILDING WORKS,
WHITEHEAD,
GLASGOW.


SECTION IN WAY OF REINFORCED FRAMES


(Amended)

Mooring Section


No 3

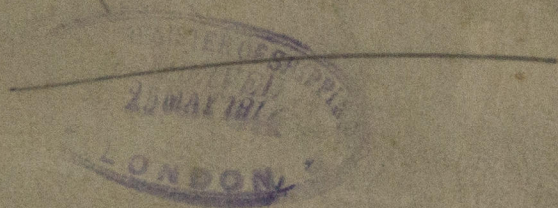

Board plan

Clan MacWhirter

GLASGOW REPORT No. 34924.

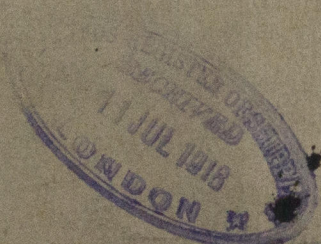

W158 - 0077



© 2020

Lloyd's Register
Foundation