

18.5.08.

S. S. N° 125.
MIDSHIP SECTION.

OF A

STEEL SCREW TRAWLER.

DIMS- 140'-0" x 24'-0" x 13'-6" MLD.

TO CLASS 100A1 LLOYDS FOR FISHING PURPOSES.

SCALE 1/2" = 1 FT.

EQUIPMENT N°-6488.


1 ANCHOR 70WTS. 3QR 7LB. STOCKLESS
1 " 5 3/4 " EX STOCK
1 " 3 1/4 " " "
120 FTMS. 1 1/16" STUB LINK CHAIN.
60 " 6" HAWSER
60 " 5" WARP

NUMERALS.	
HALF GIRTH	20.75
" BREADTH	12.00
DEPTH	14.00
1 ST N°	46.75
LENGTH	138.79
2 ND N°	6488.43



$\frac{L}{B} = 5.78$

$\frac{L}{D} = 9.91$

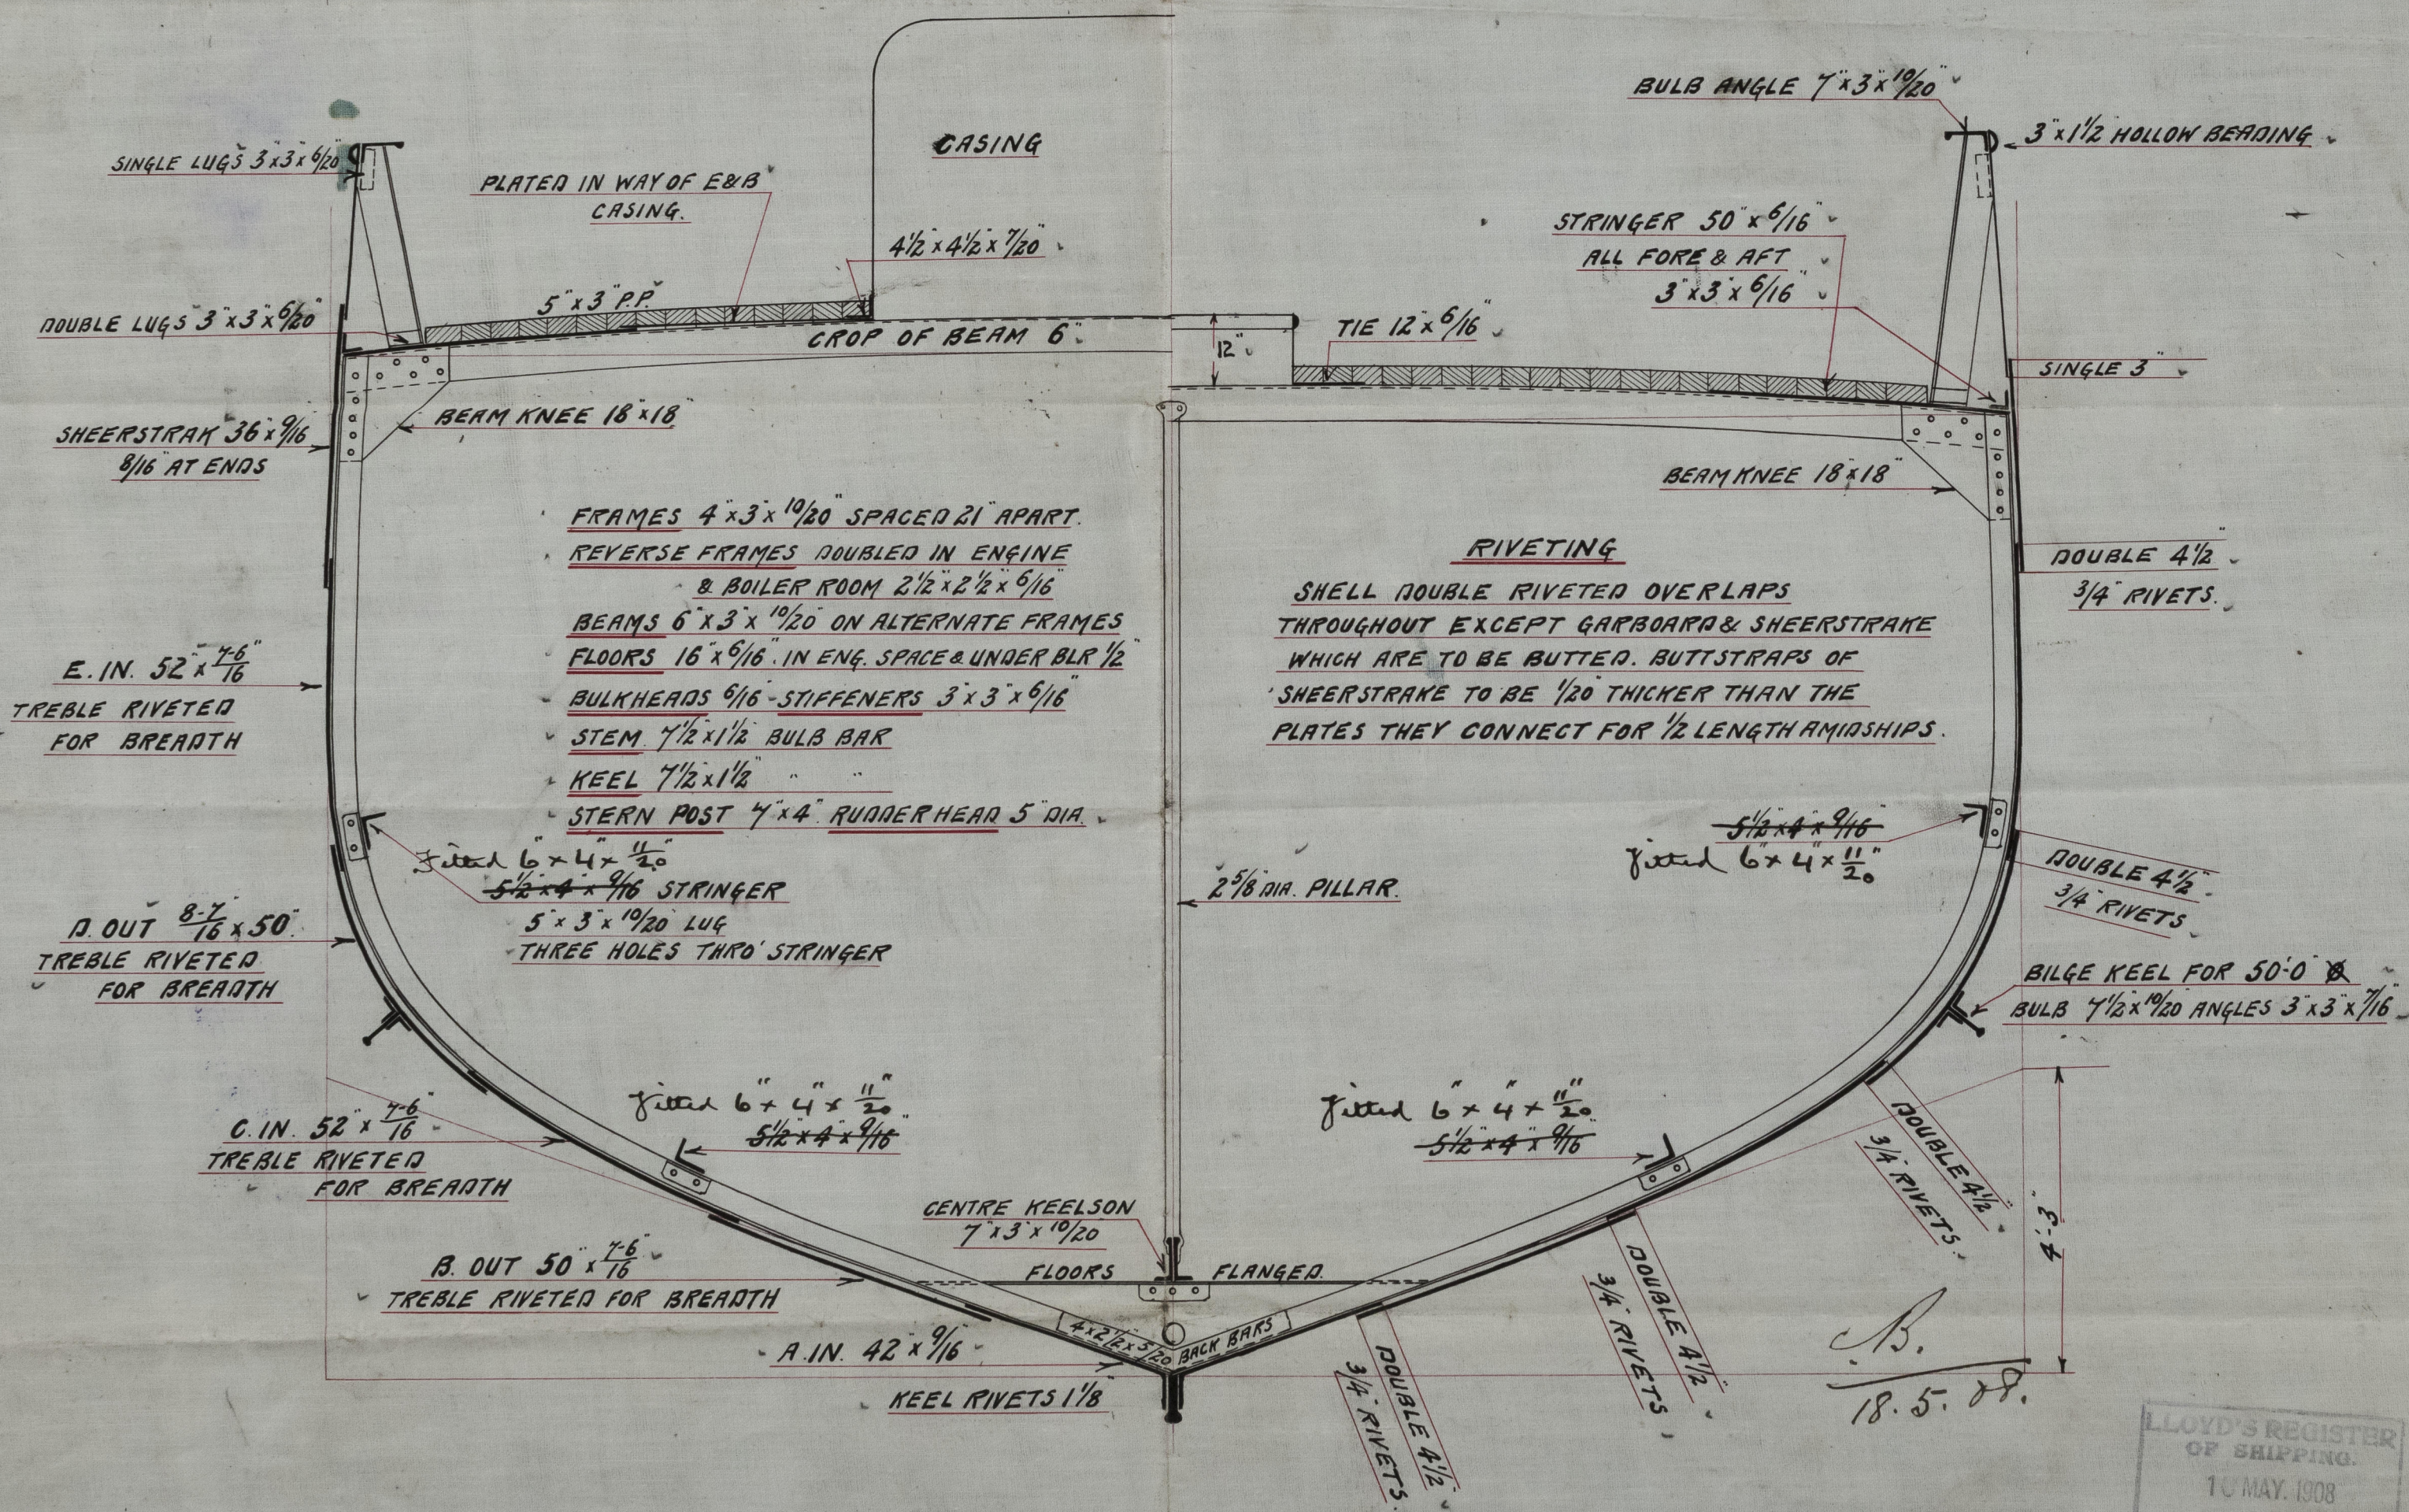

LLOYD'S REGISTER
OF SHIPPING.
10 MAY. 1908
HULL.

Midship Section
Goole S & B Co's

No 125

S/S River Dart.
Hull Rph No. 20,675.

RETAI

18.2.02



© 2021

Lloyd's Register
Foundation

W1580 6058