

**- S.T. No. 125. -**  
**PROFILE** SCALE 1/4" = 1 FT.


**DIMENSIONS**  
140'-0" BP x 24'-0" ML x 13'-6" ML

COAST GUARDIANSHIP & REPAIRING CO. LTD.  
SHIPBUILDERS & ENGINEERS  
15/5/08  
VICTORIA SHIPYARD, COLE

18-5-08

*Supported to  
Surveyors satisfaction.*

*Must be supported to  
Surveyors satisfaction.*

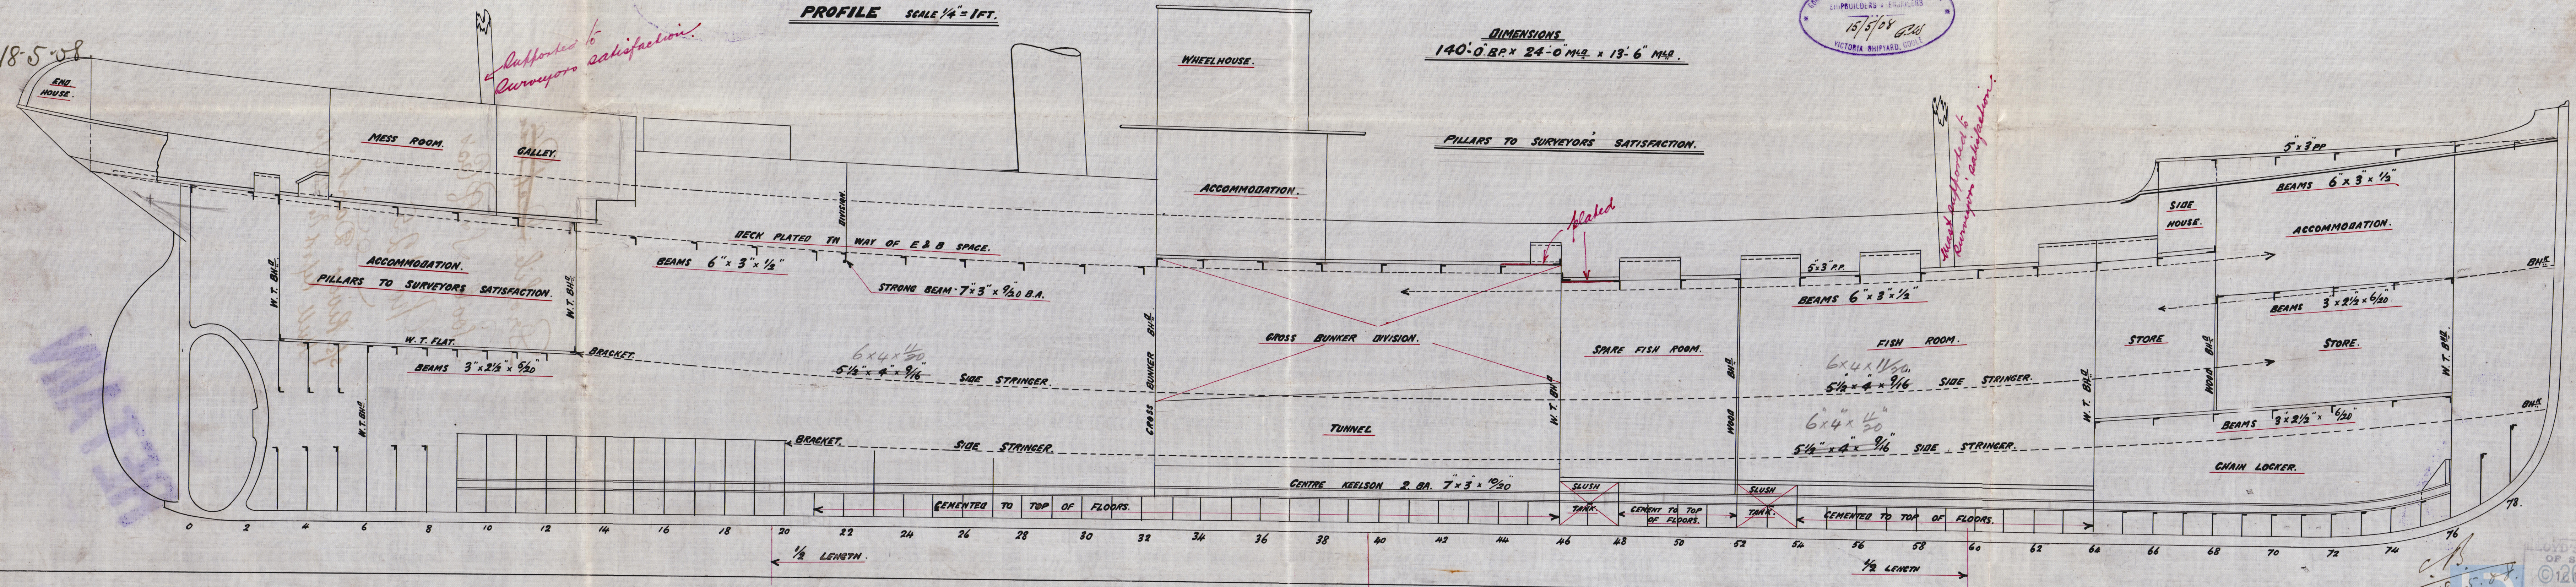



~~Profile & Deck Plan~~

Loob S & F Co's

No 125

of  
Sp River Dart.  
Hull Report No. 20675

RETAIN



© 2021

Lloyd's Register  
Foundation

W1580-0059