

26.9.08

WM SIMONS & CO LTD

LONDON WORKS

RENFREW.

TWIN SCREW PUMP HOPPER DREDGER N^o 485

TO CLASS A1 AT LLOYDS SPECIAL SURVEY.

SCALE 1/8 INCH = 1 FOOT.

PROPORTIONS.

L = 14.12.

B = 6.18.

NUMERALS

1/2 BREADTH = 22.5

1/2 GIRTH = 39.87

DEPTH = 19.68

82.051st NUMERAL

LENGTH = 278.33


22836.9765, 2nd NUMERAL.

DIMENSIONS.


LENGTH AS PER RULE. 278.33

BREADTH MOULDED. 45.0

DEPTH AS PER RULE. 19.68

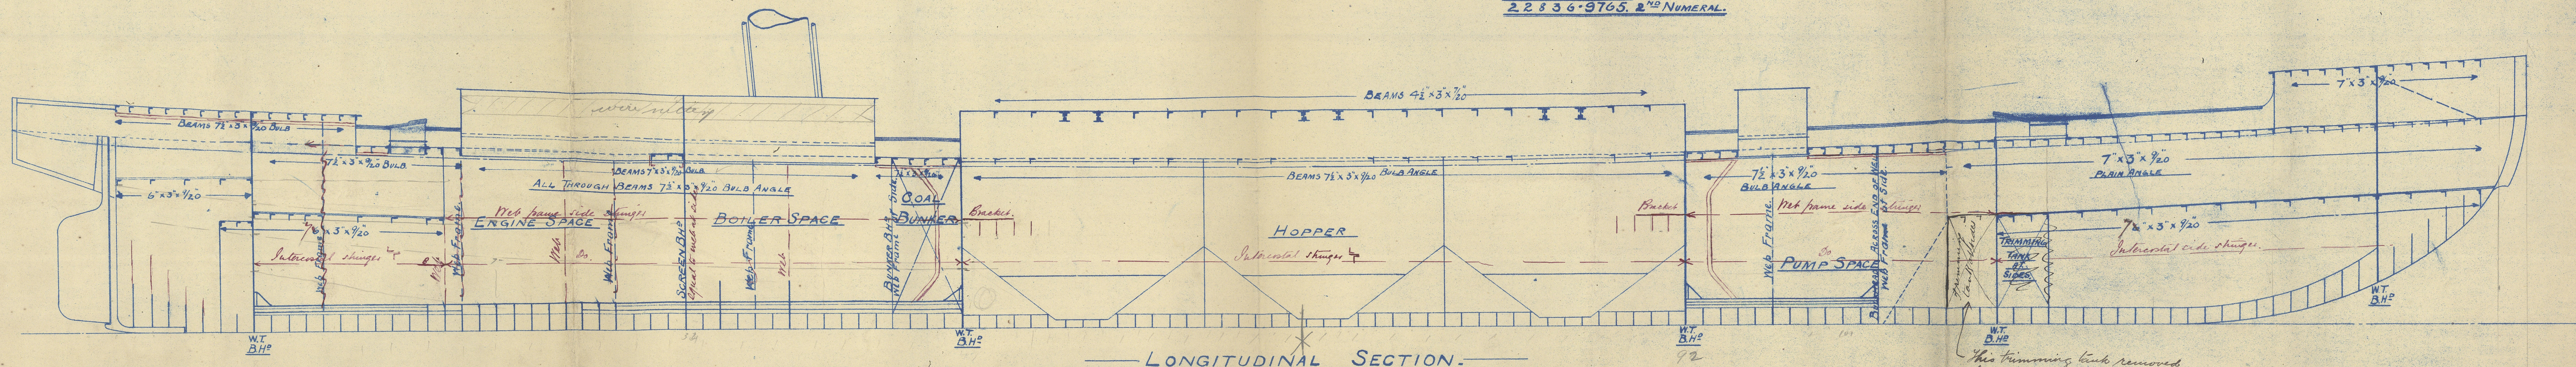

This trimming tank removed to make room for additional pumping machinery. (See separate sketch)
W. S. 11/11.

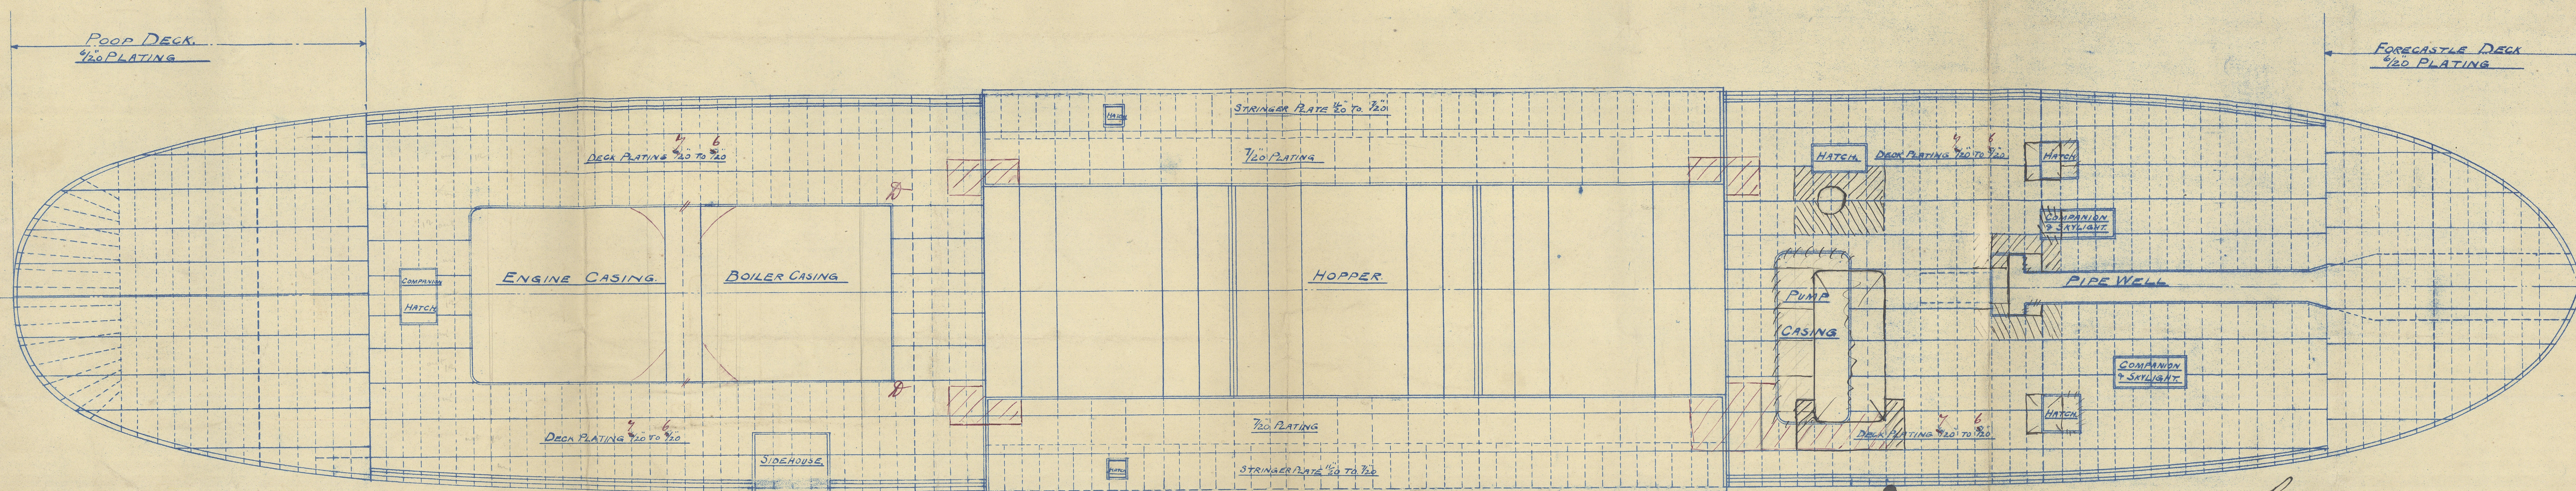

PLAN.

C.B.
26.9.08

Messrs W. Simon & Co


No 485

Profile & DR Plan.

"Sand Grouse"

GLASGOW Report No. 27918.

GLASGOW REPORT No. 29429.

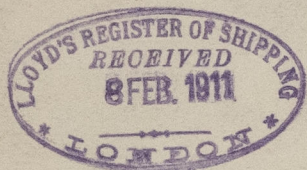

RETAIN



© 2021

Lloyd's Register
Foundation

W1581-0065