




Cargo-boat B<sup>3</sup>

To class 100 A 1 Speed-of-curve. Shell-deck

Scale  $\frac{1}{8}$  in. per foot

Actual scantlings

B<sup>3</sup> 221 9 June 1903

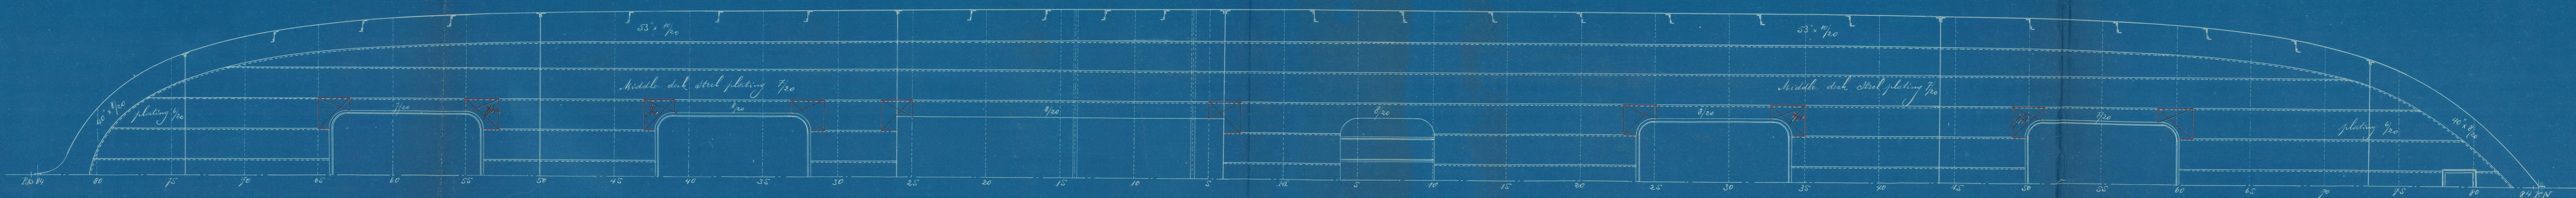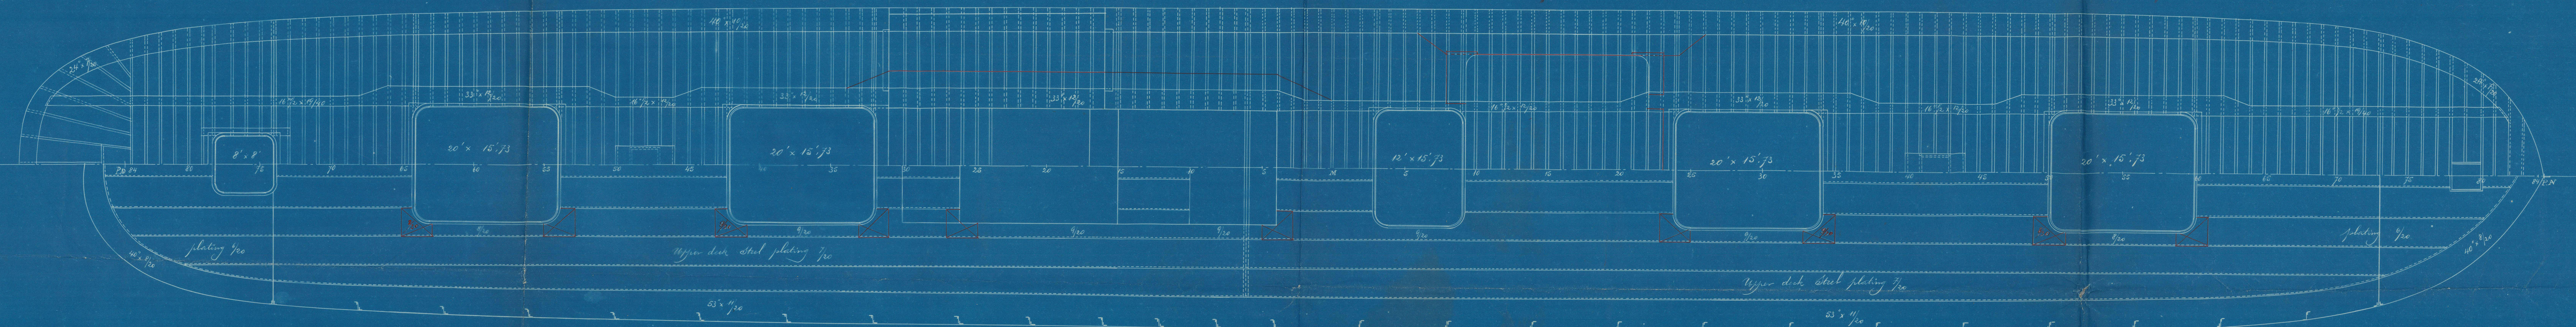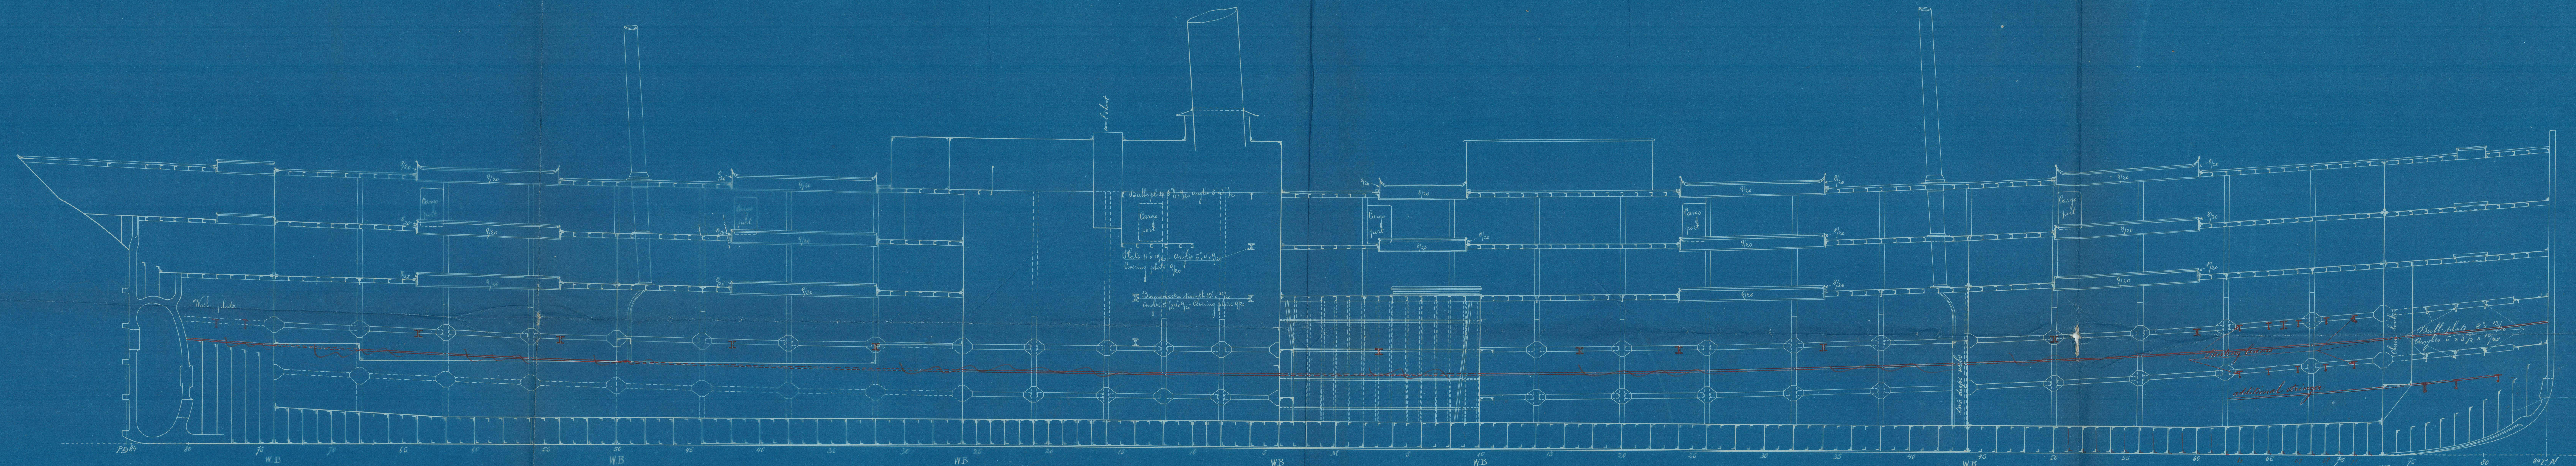



B 3  
Serione Longile


"Sicania"

Lgn 195<sup>a</sup>

RETAIN

P/D

W1585-0028

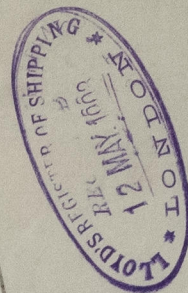

Sicania

W1585-0028



© 2020

Lloyd's Register  
Foundation