

## MIDSHIP SECTION

OF A


# STEEL SCREW TRAWLER

DIMS:- 116'-9" B.P. x 21'-0" x 13'-0" Mouth RD

TO CLASS 100 A.I. LLOYDS FOR FISHING PURPOSES

## FLUSH DECK NO ERECTIONS

SCALE 1/2" = 1 FOOT.
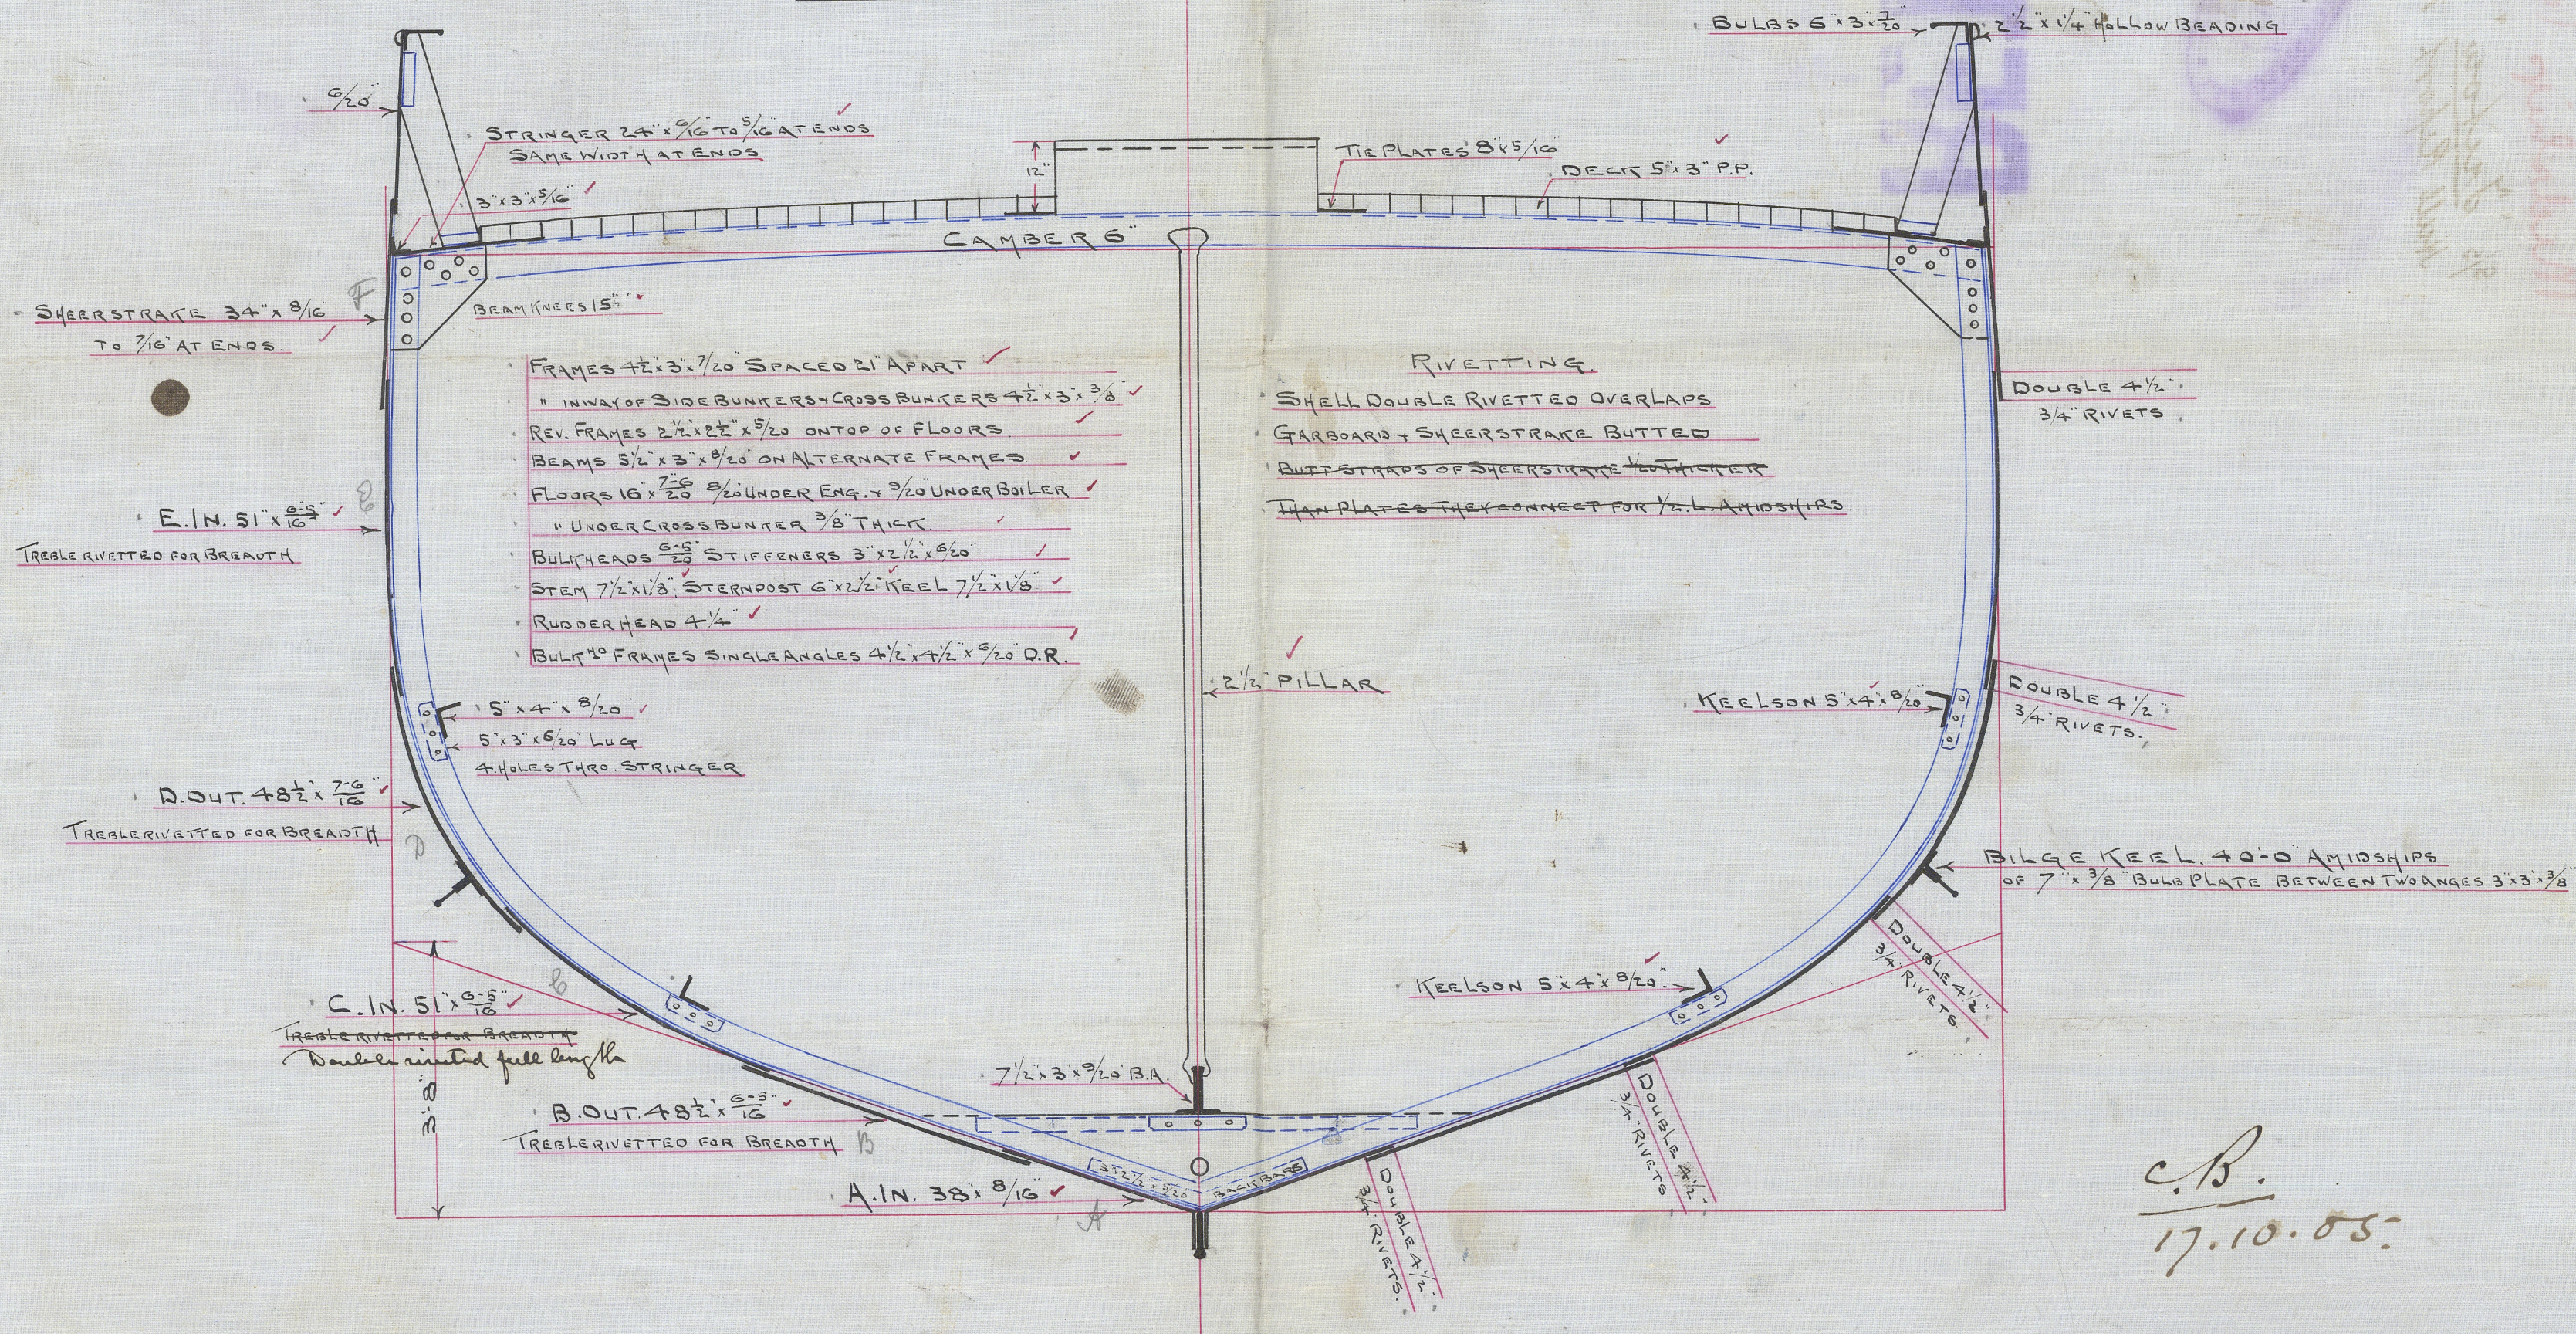
$$\frac{P}{r} = 5.38$$
$$\frac{L}{D} = 8.57.$$


C.B.  
17.10.55




Goolle S. & R. Co  
No 83.

Midship Section

s/s Triton

Hull Report No. 17663

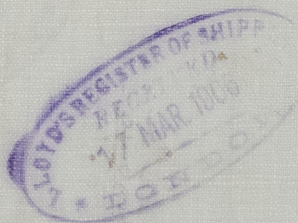

RETAIN



© 2020

Lloyd's Register  
Foundation

W1586-0262