


17.10.05


S.S. N° 83.  
ELEVATION.

DIMS.: 116'-9" BP. x 21'-6" x 13'-0" MLD

SCALE 1/4" = 1 FT.

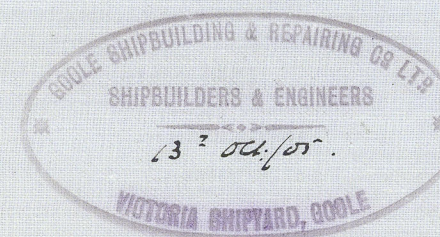

WATER

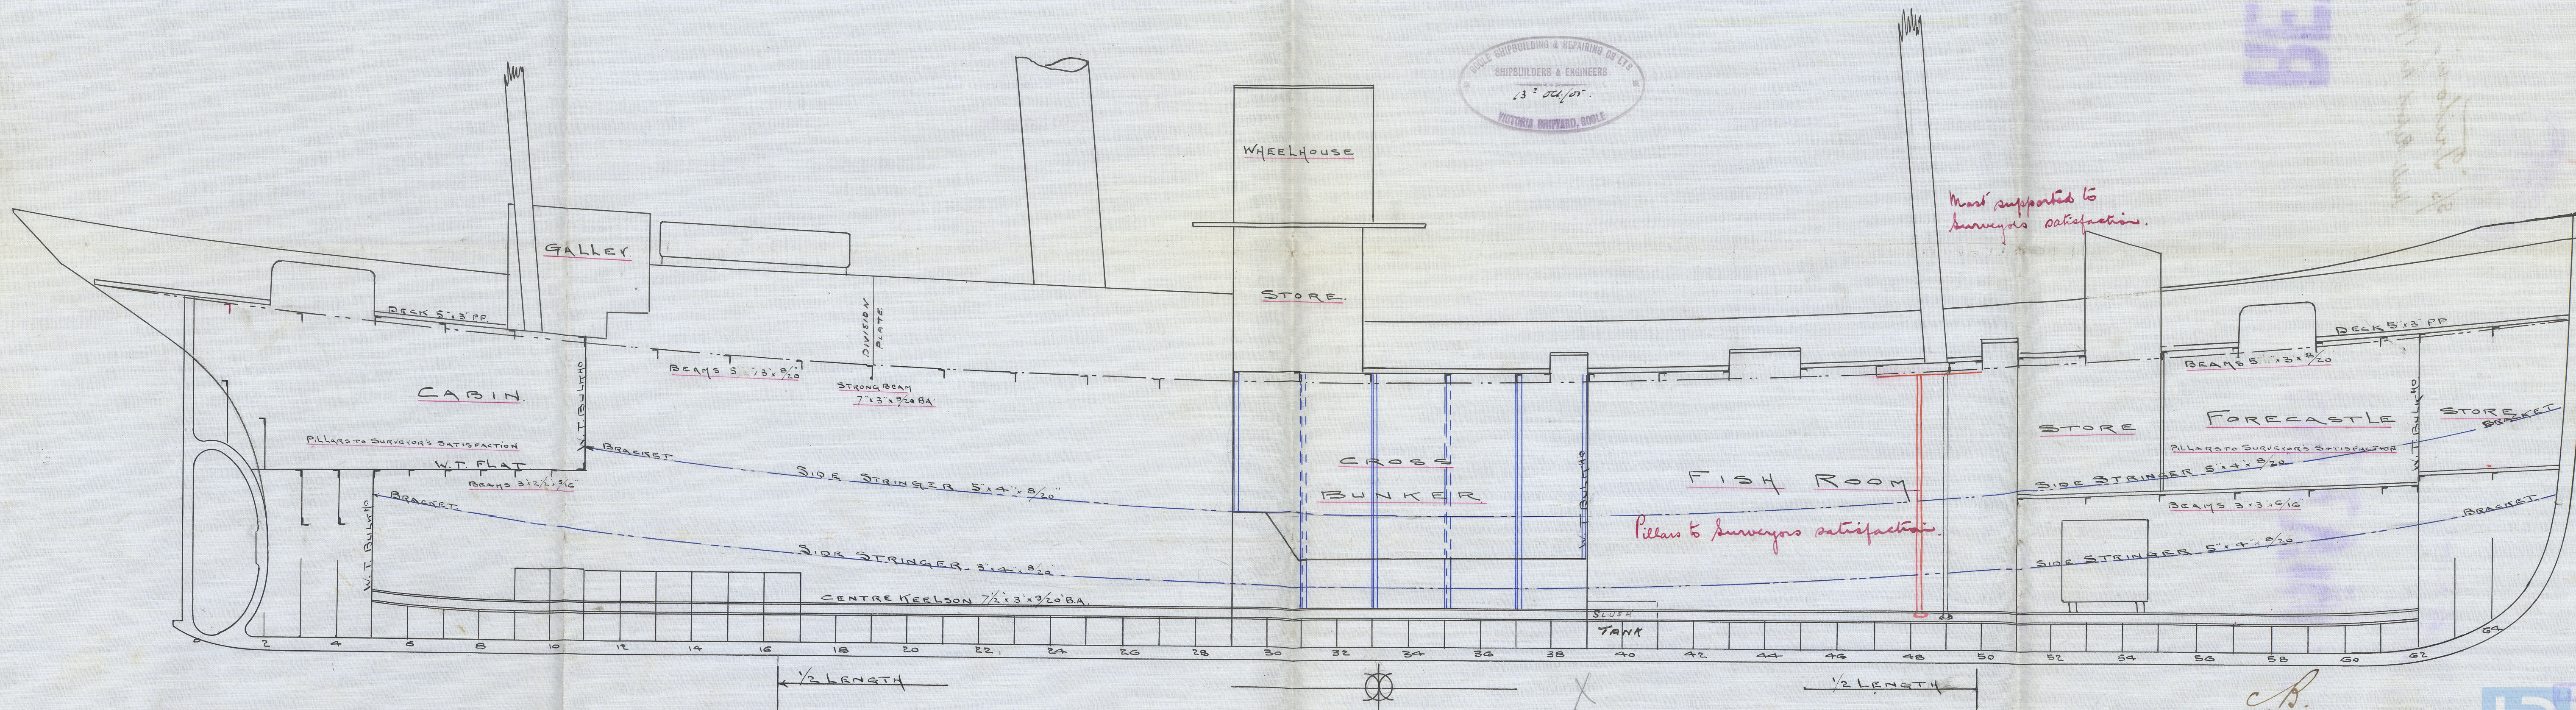

C.B.  
17.10.05.



Good S. & R. C:

17.83.

Profile 9

S/S 'Triton'

Hull Report No. 17663

RETAIN



© 2020

Lloyd's Register  
Foundation

W1586-0263