


12: 2: 06

Boiler No 1508

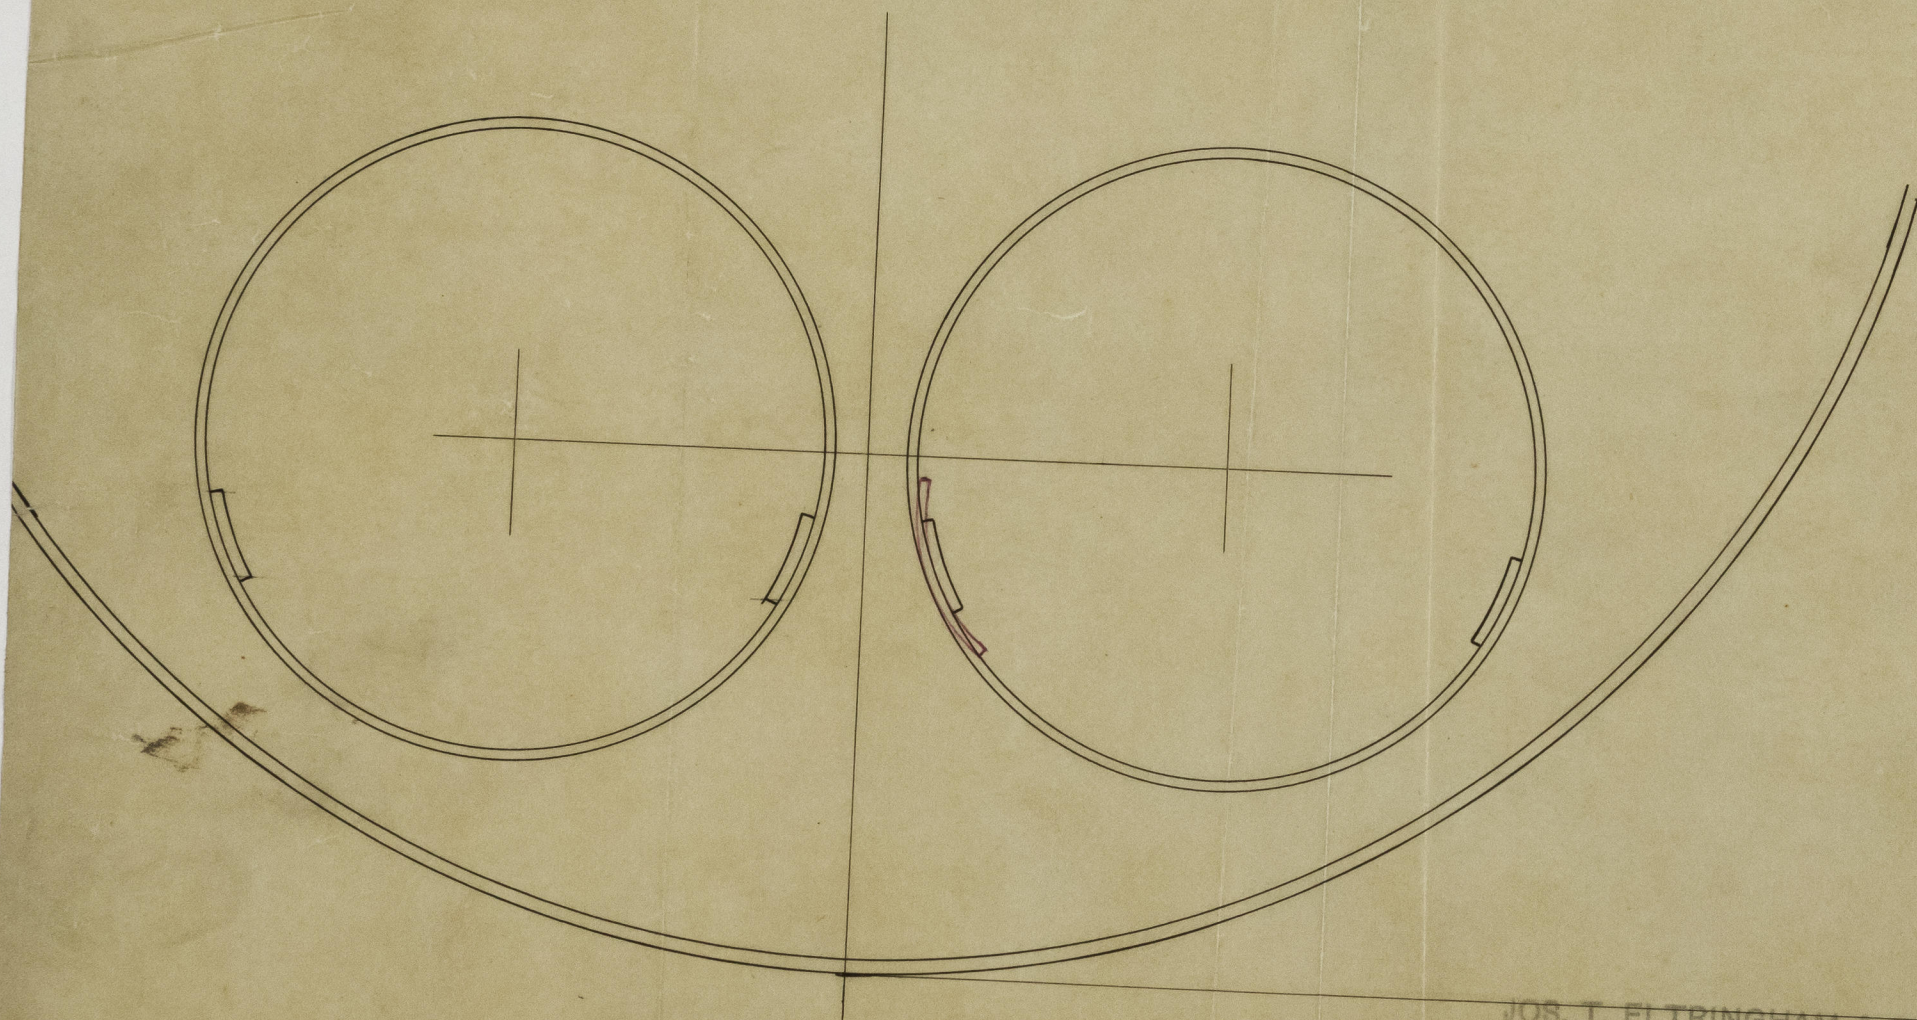


JOS. T. ELTRINGHAM & CO.,
SHIP AND BOILER BUILDERS,
SOUTH-SHIELDS.

DRAWING NO. 1078.

DATE 9.1.06.

State of repair
to furnace
March 1st 1908
Boiler No 1508
for Messrs. The North Shields Co
22 No 83
Working pressure 100 lbs

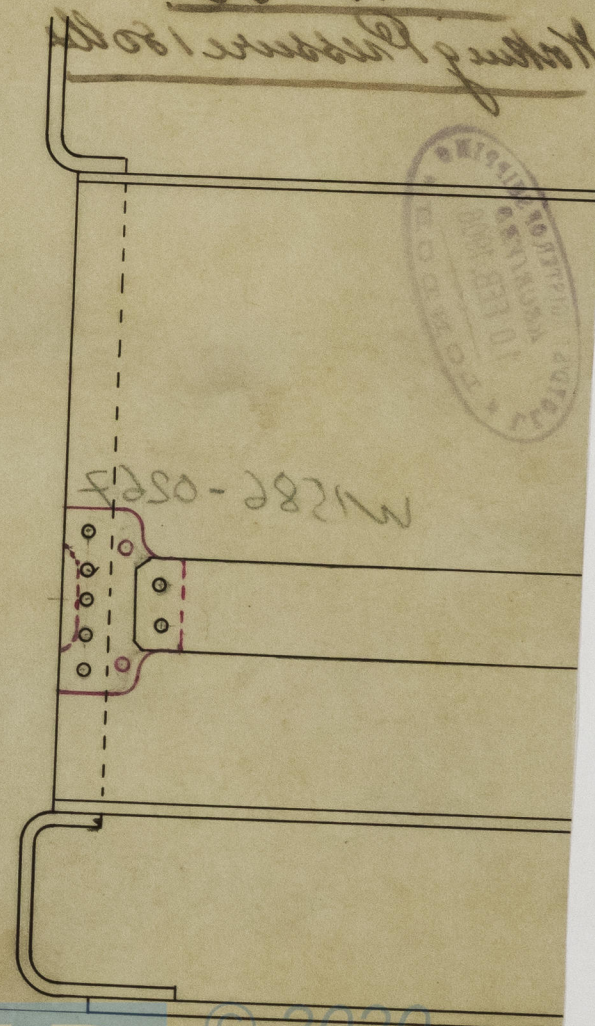

Sketch of repair
to Furnace.

Messrs J Eltringham & Co


Boiler No 1508

For Messrs The Coal & Iron Co

S.S. No 83


Working Pressure 180 lbs

8071 2/1 No 1208

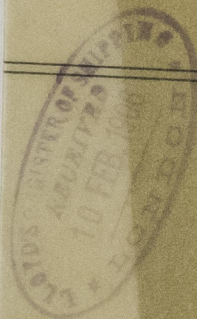

W1586-0267

JOSEPH T. ELTRINGHAM & CO
SHIP AND BOILER BUILDERS

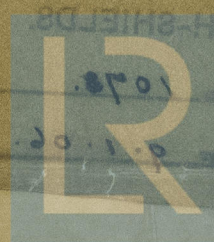

© 2020

Lloyd's Register
Foundation