

# N<sup>o</sup> 524

27.4.06.

## MIDSHIP SECTION

DIMENSIONS 13'-8" <sup>BD</sup> x 22'-1" <sup>M.D</sup> x 12'-10" <sup>M.D</sup> - 12'-0" <sup>HOLD</sup>

STEEL - CLASS 100A1 LLOYDS (FOR FISHING PURPOSES)



SCALE 1" = 1 FOOT.

$\frac{1}{2}$  GIRTH 20.16  
 $\frac{1}{2}$  BREADTH 11.04  
 DEPTH 13.33  
 44.53 ST No  
 130.437 LENGTH PER RULE  
 31171  
 22265  
 17812  
 133590  
 4453  
 580925021 2ND No

$\frac{L}{B} = 5.9$   $\frac{L}{D} = 9.7$

### EQUIPMENT

ONE ANCHOR  $5\frac{3}{4}$  CWTs EX STOCK  
 " "  $5\frac{1}{2}$  " "  
 " " 3 " "  
 105 FATHOMS  $1\frac{1}{16}$  CHAIN  
 60 " " 6" HAWSER  
 60 " " 5" WARP

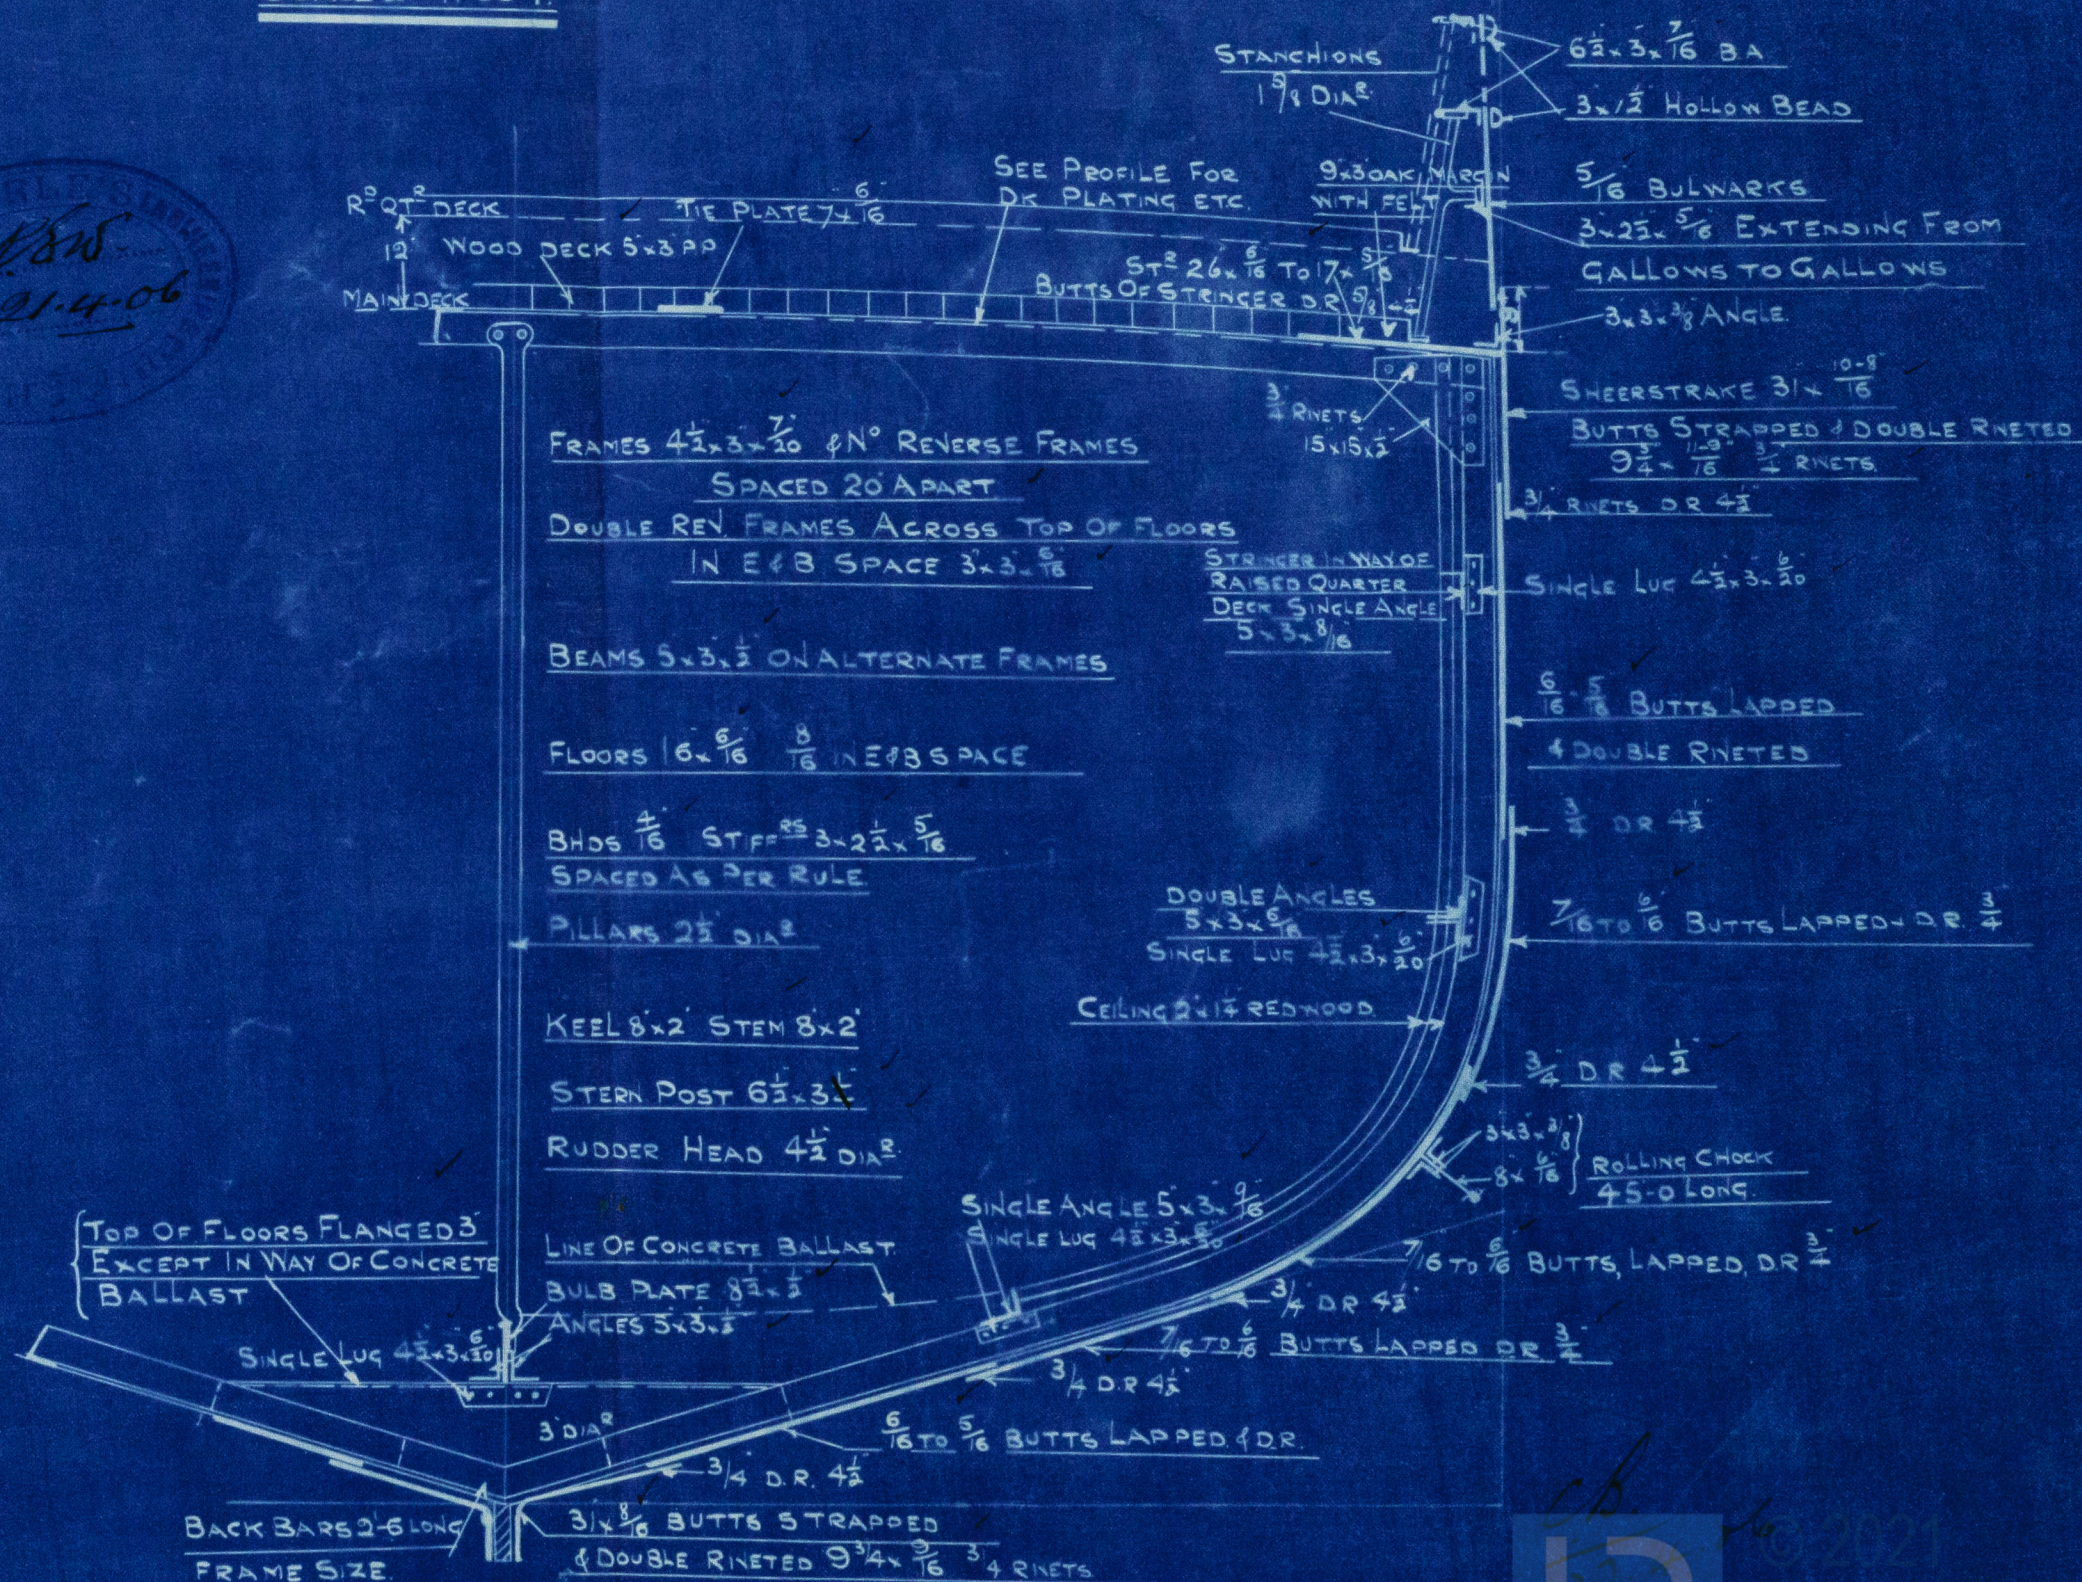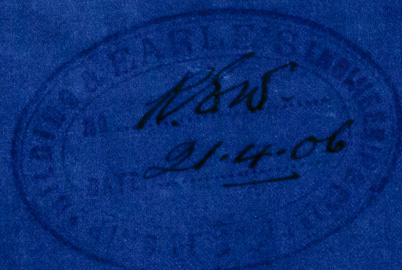

LLOYD'S REGISTER



Earles S. E. Co.

Nº 524

Duplicate of Nº 520

Midship Section.



s/s 'Spider'  
Hull Report No 18488

RETAIN

W1588-0104



© 2021

Lloyd's Register  
Foundation