


GOOLE SHIPBUILDING & REPAIRING CO. LTD.
SHIPBUILDERS & ENGINEERS
June 26 1908
J. W. F. W.
VICTORIA SHIPYARD, GOOLE


SCALE $\frac{1}{4}'' = 1\text{ FT.}$

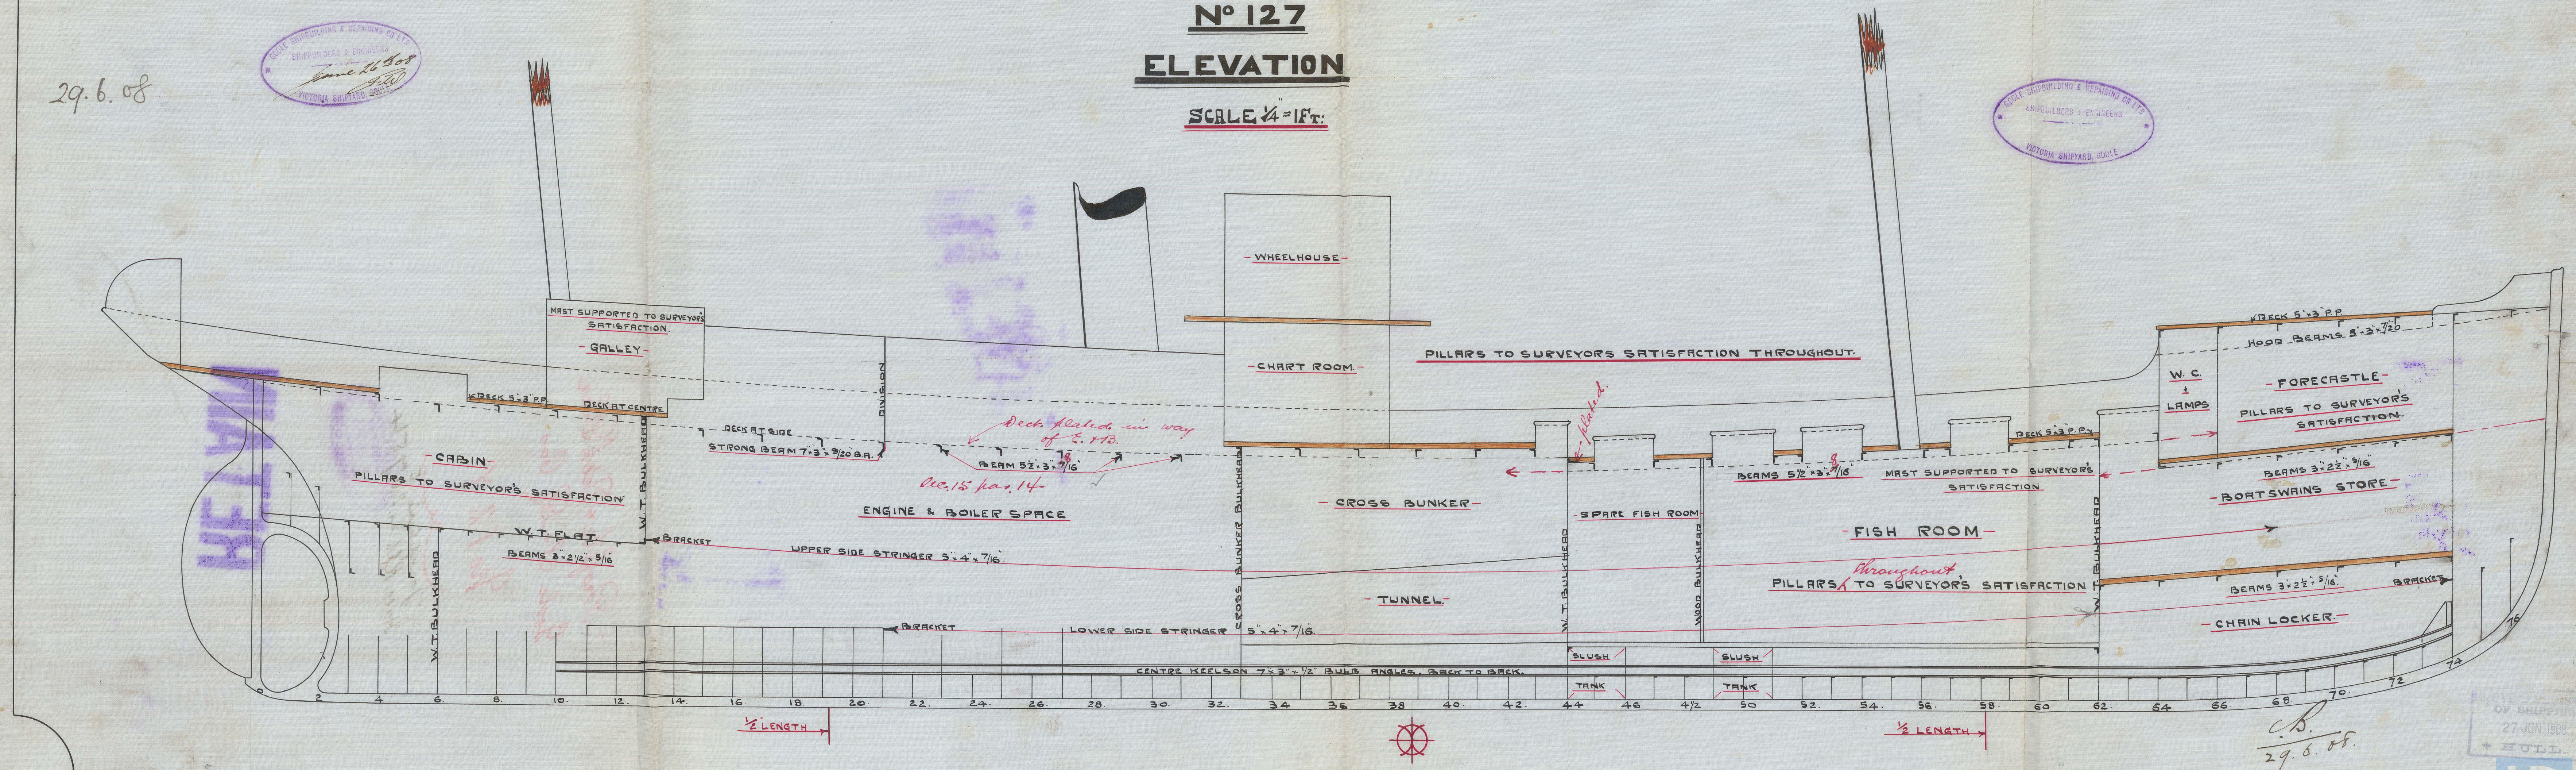

- Profile + Deck Plan
Goole S + D Cos

No 127

ee
S/S Josephine I
Hull Rph. No. 20754

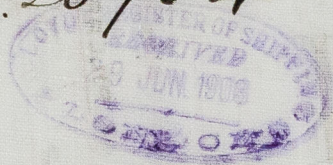

RETAIN



© 2021

Lloyd's Register
Foundation

W1588-0187

W1588-0187