

- № 127 -

-MIDSHIP SECTION.-

-STEEL SCREW TRAWLER.-

- DIMENSIONS 130'-0" B.P. x 23'-0" x 13'-0" MOULDED.

—TO CLASS 100A.I. LLOYDS—

SCALE $\frac{1}{2}" = 1 \text{ FOOT.}$

EQUIPMENT № 5848.

✓ 1 ANCHOR 5³/₄ CWT (EX STOCK) OR 7-0-21 STOCKLESS.


1 " 5 1/4 " " OR 6-2-7 "

✓ 1 " 3 " "

105 FATHOMS $1\frac{1}{16}$ " STUD LINK CHAIN

✓ 60 " 6" HAWSER

✓ 69 " S" WARP.

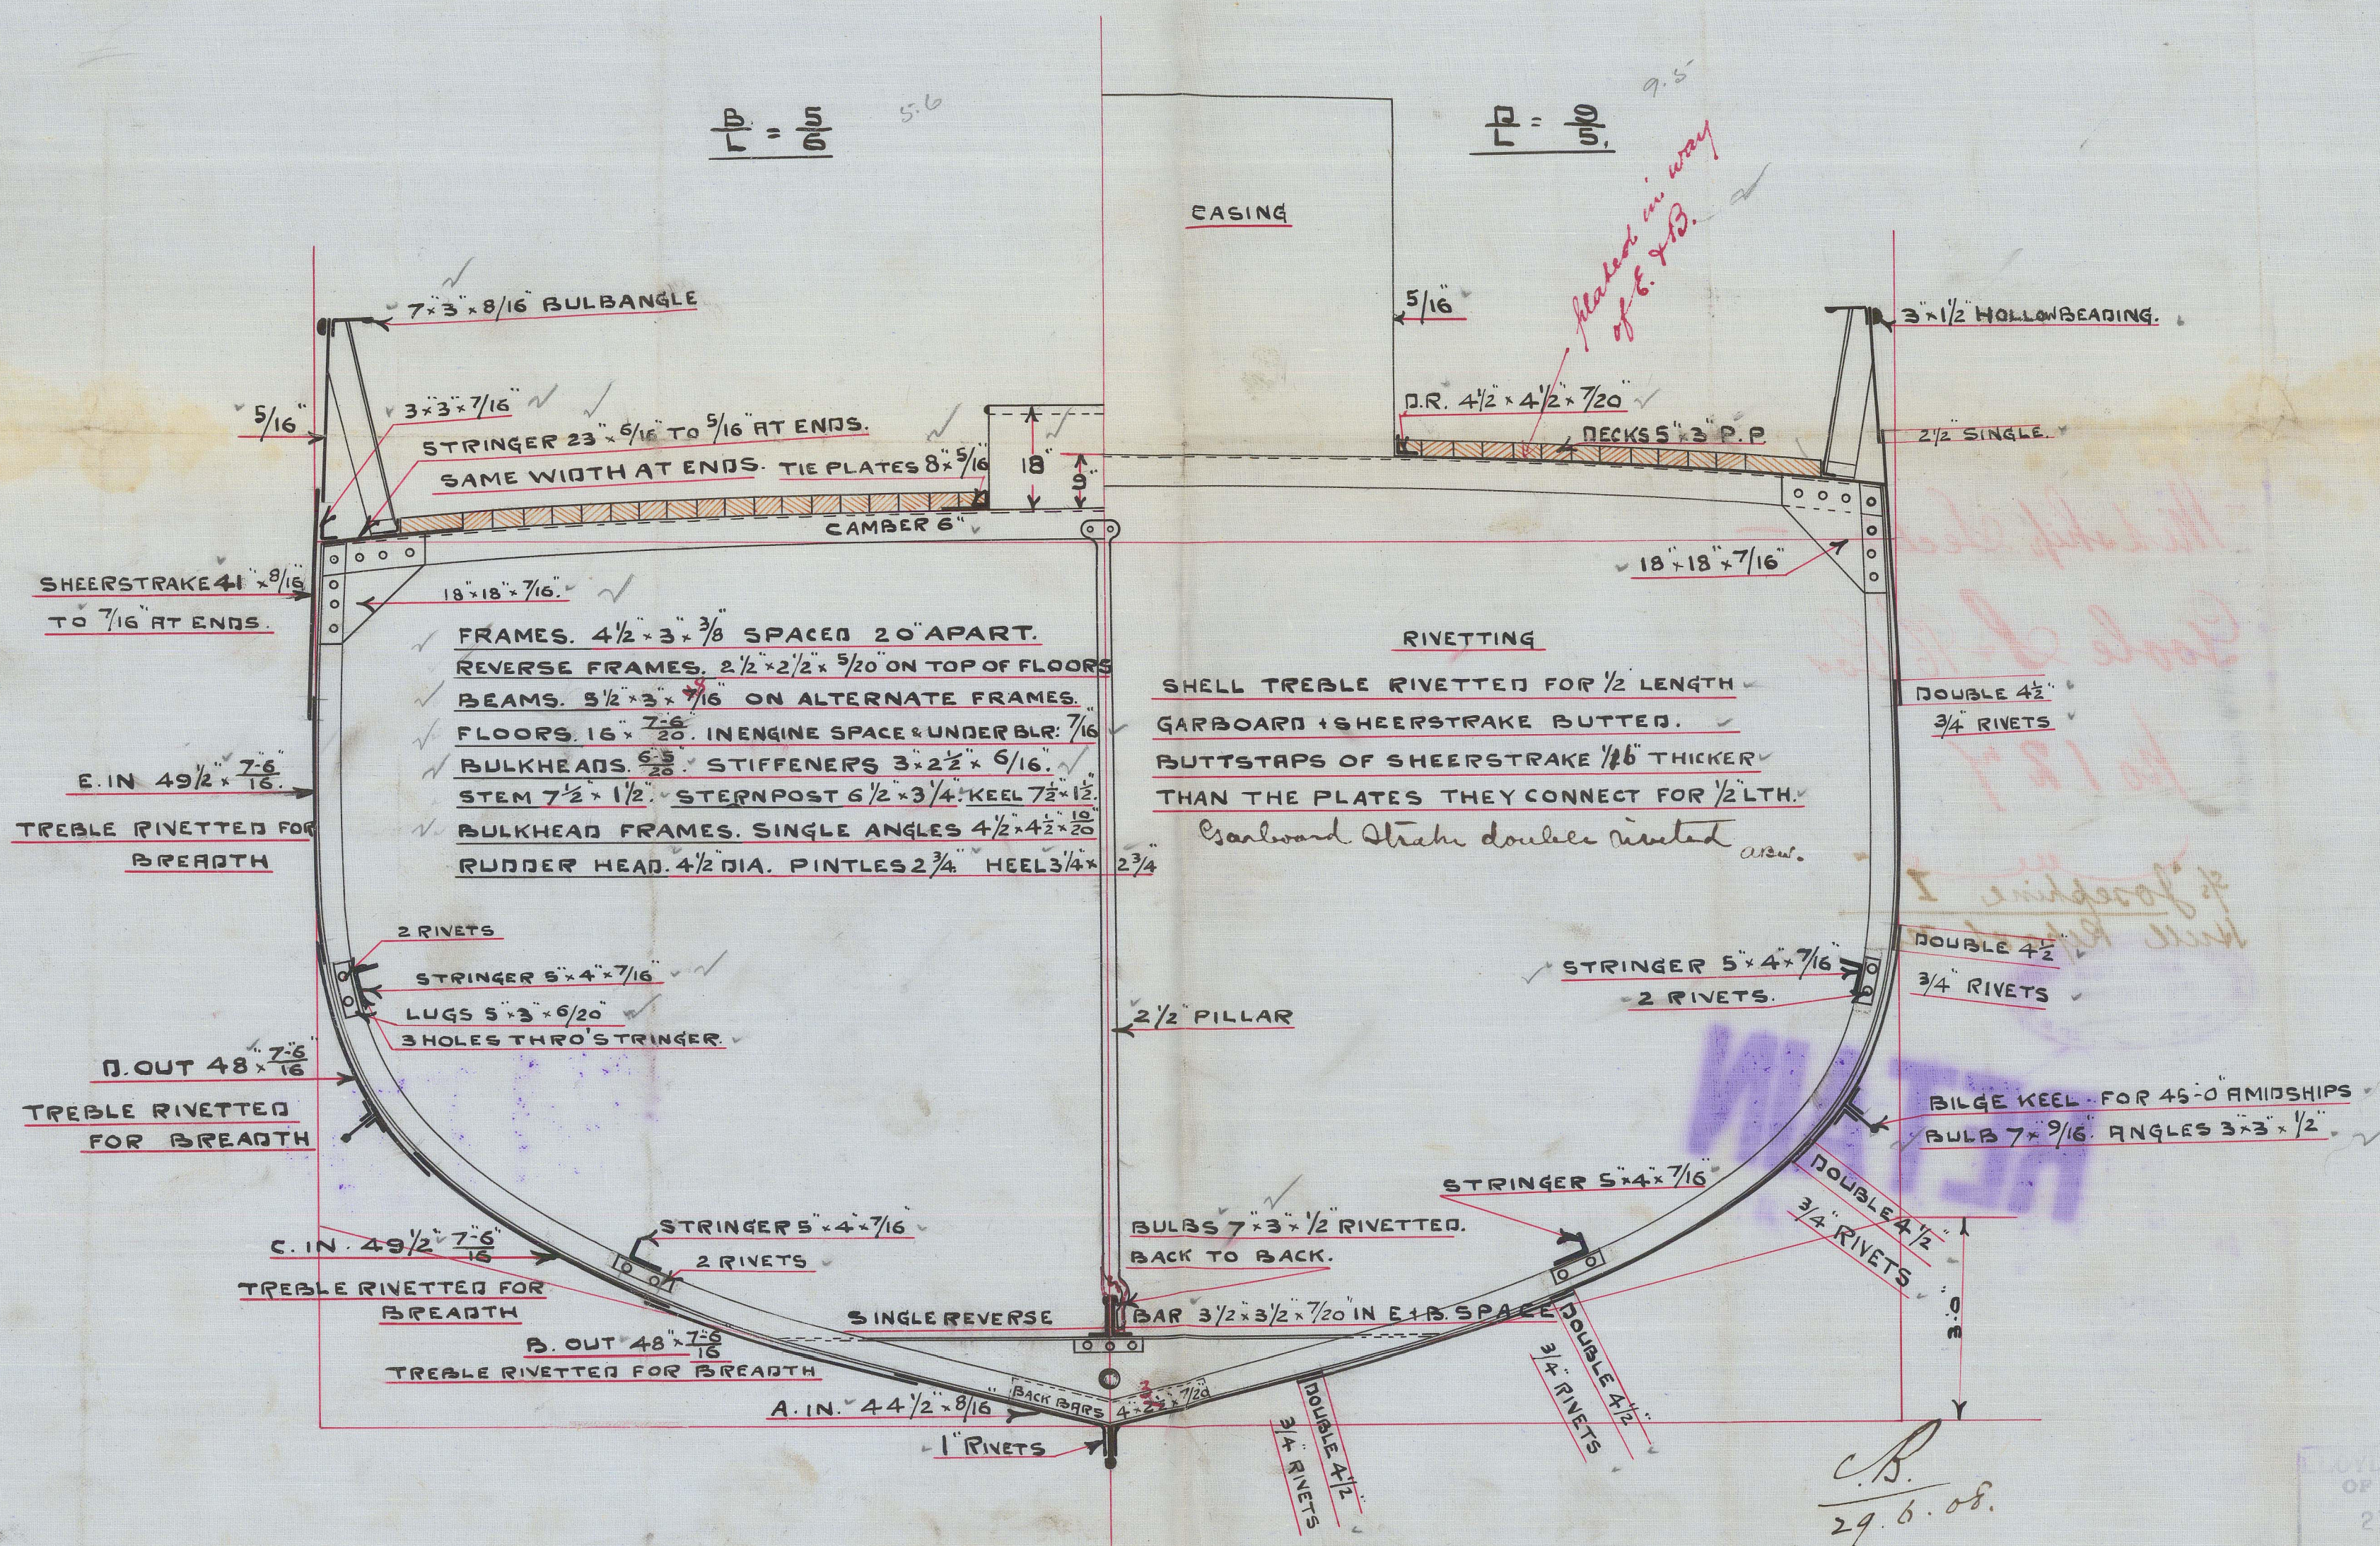

- Midship Section -

Goole S. & H. Co.

No 127

ms
s/s Josephine 1
Hull Report No

RETAIN



© 2021

Lloyd's Register
Foundation
W1588-0188