
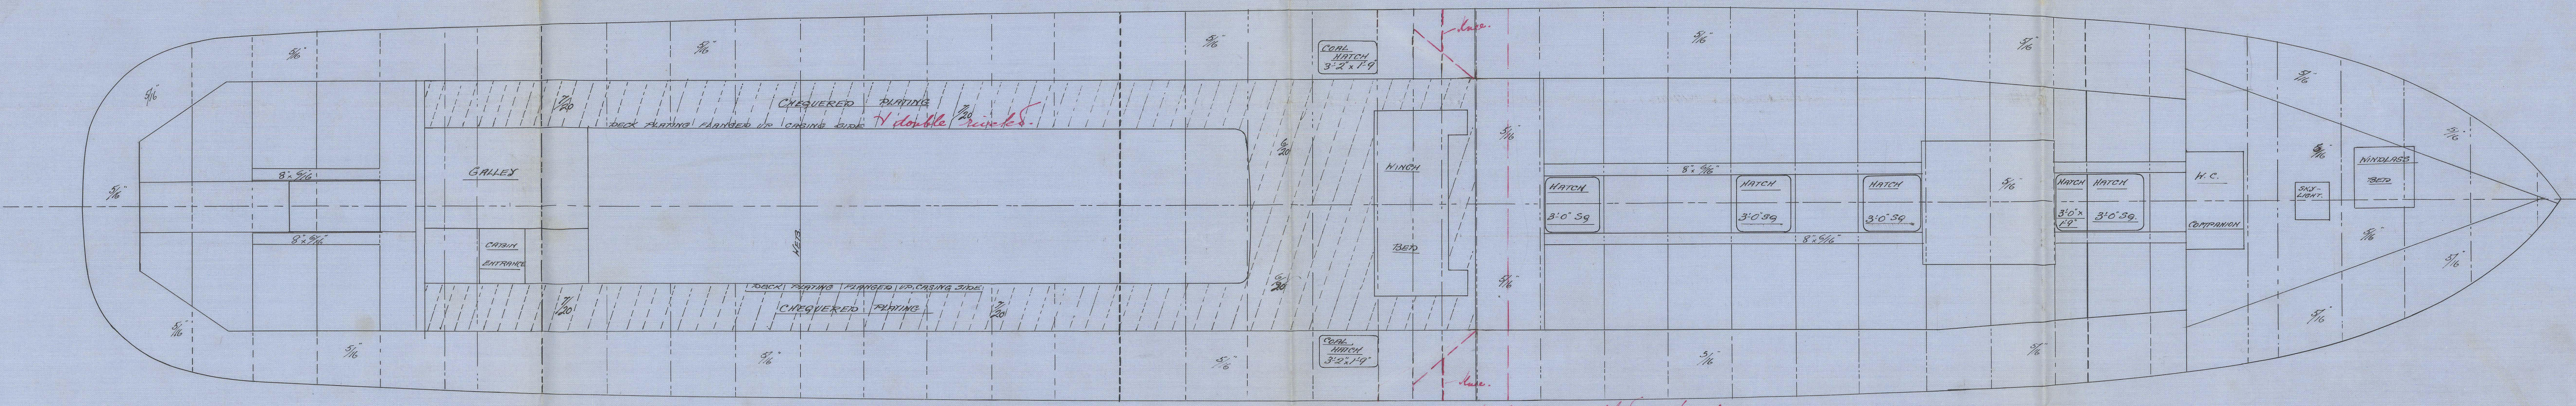


27.11.07

RETA

PROFILE & DECK PLAN  
Nº 426

SCALE  $\frac{1}{4}'' = 1 \text{ FOOT}$

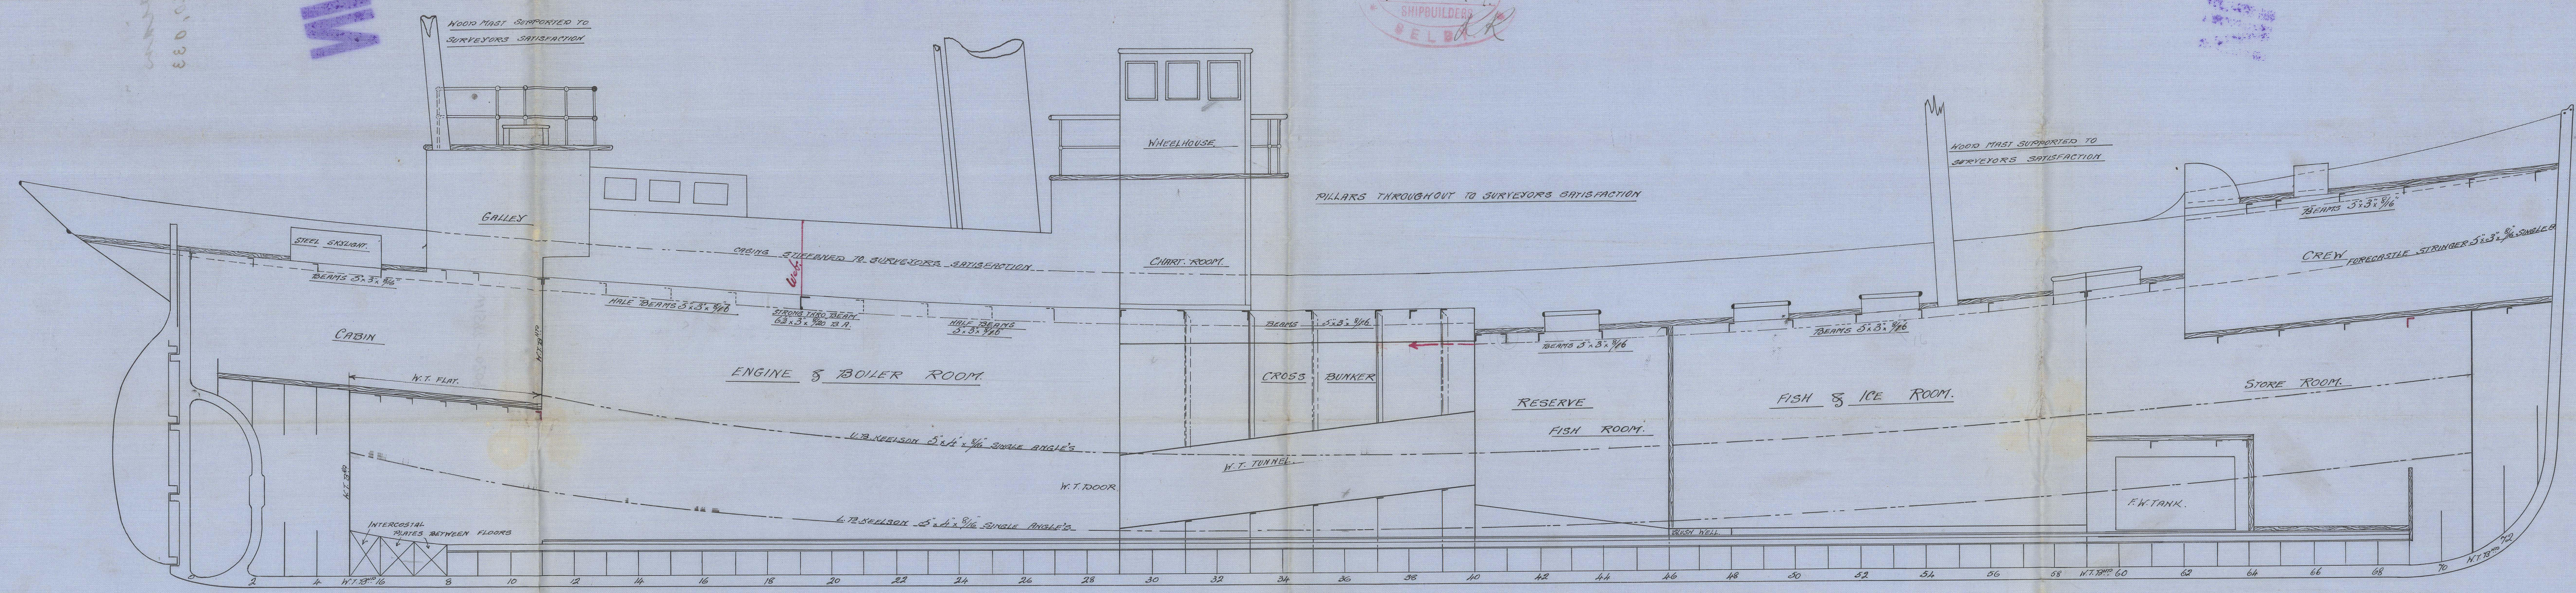


Main dk stringer scarfed 2 spaces.

C.B.  
27. 11. 07.

LLOYD'S REGISTER  
OF SHIPPING  
22 NOV. 1907  
+ HULL +




Cochran & Sons  
N<sup>o</sup> 426  
Profile & Deck plan

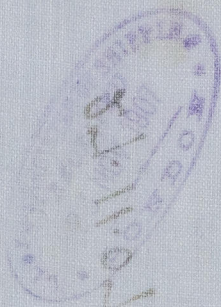

S/S Assyrian  
Hull Report No. 20,033

**RETAIN**

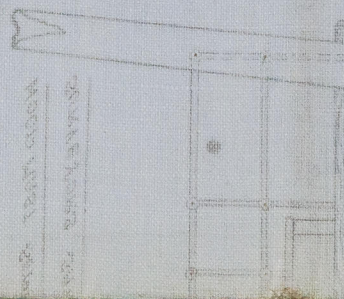

© 2021

Lloyd's Register  
Foundation

W1588-0209