


14.4.06
6.10.06

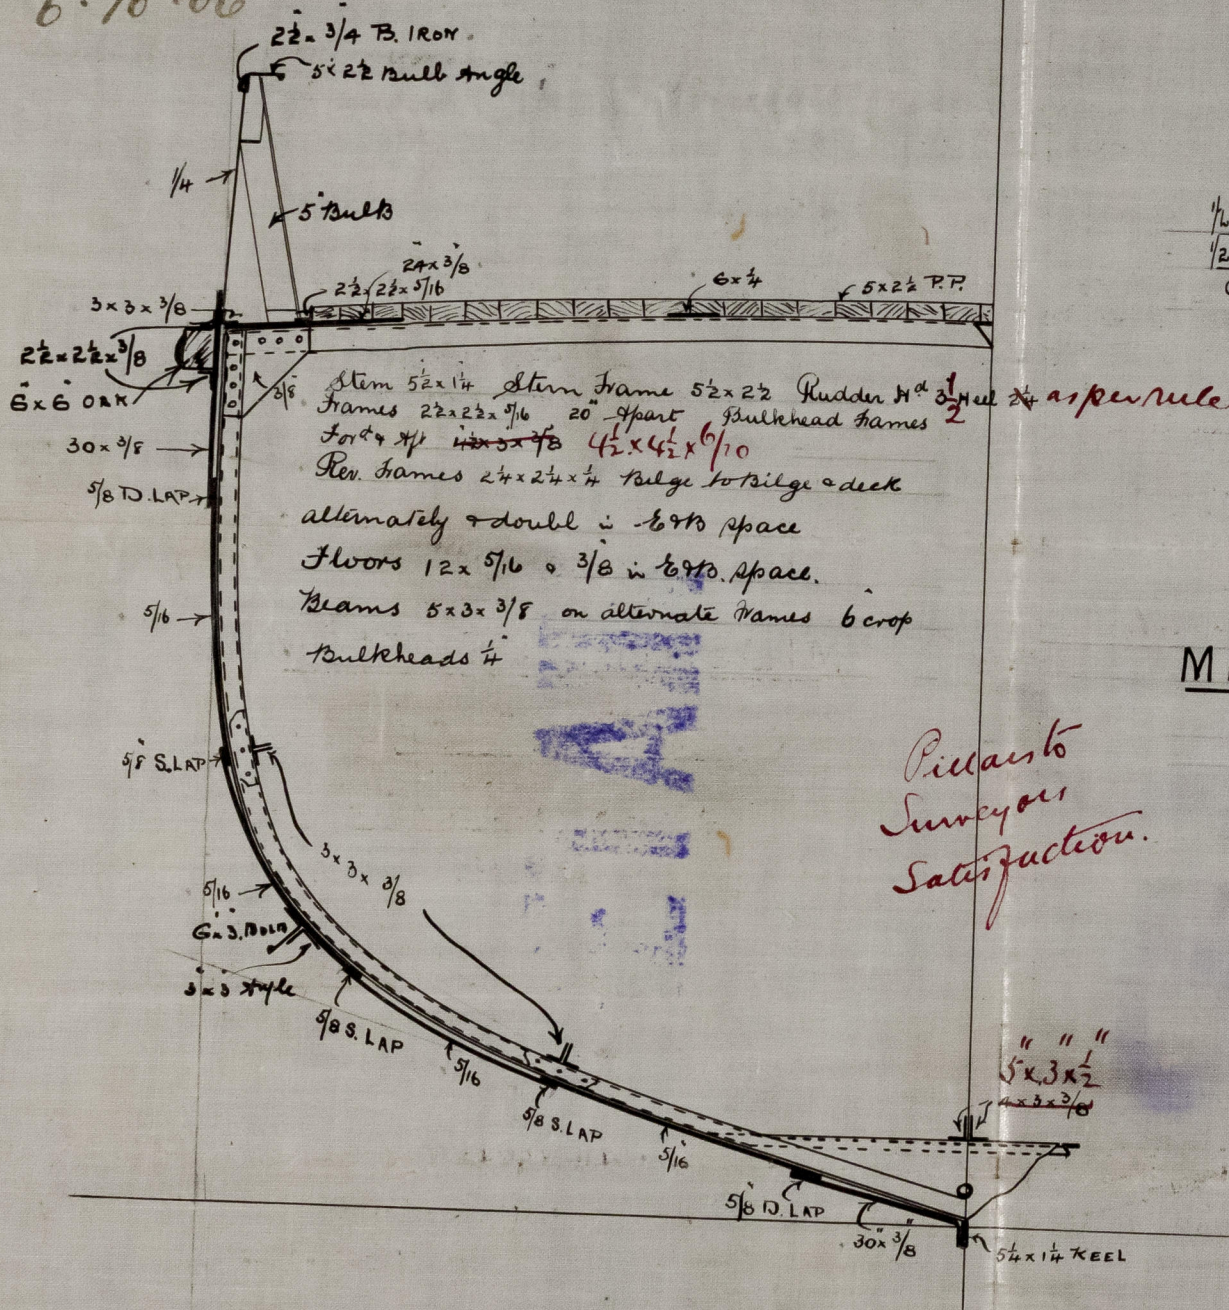

Surveyors
Satisfaction.*

$\frac{1}{2}$ Breadth	9.0	
$\frac{1}{2}$ Girth	15.75	
	10.37	
Depth	10.0	
35.12	34.75	1.37
	85.0	Breadth
	2953.75	2.0
	2985	

MIDSHIP SECTION

S. TUG N° 54

85.0 x 18.0 x 10.0
1/2 = 1 f 7.

CLASS A - FOR TOWING PURPOSES

W.H. WARREN

SHIPBUILDER
NEWHOLLAND

J.H.L.
14/4/06



© 2021

Lloyd's Register
Foundation

W1589 0126

W. H. Warren

N. 54.

Midship Section

Skull Report No. 18847

s/s Spurn

Pumping Room
RETAIN

W1884-0126



© 2021

Lloyd's Register
Foundation