

— MIDSHIP SECTION. —

— DIMS: 110'-0" BP x 21'-6" x 12'-6" ML —

— SCALE 1/2" = 1 FOOT. —

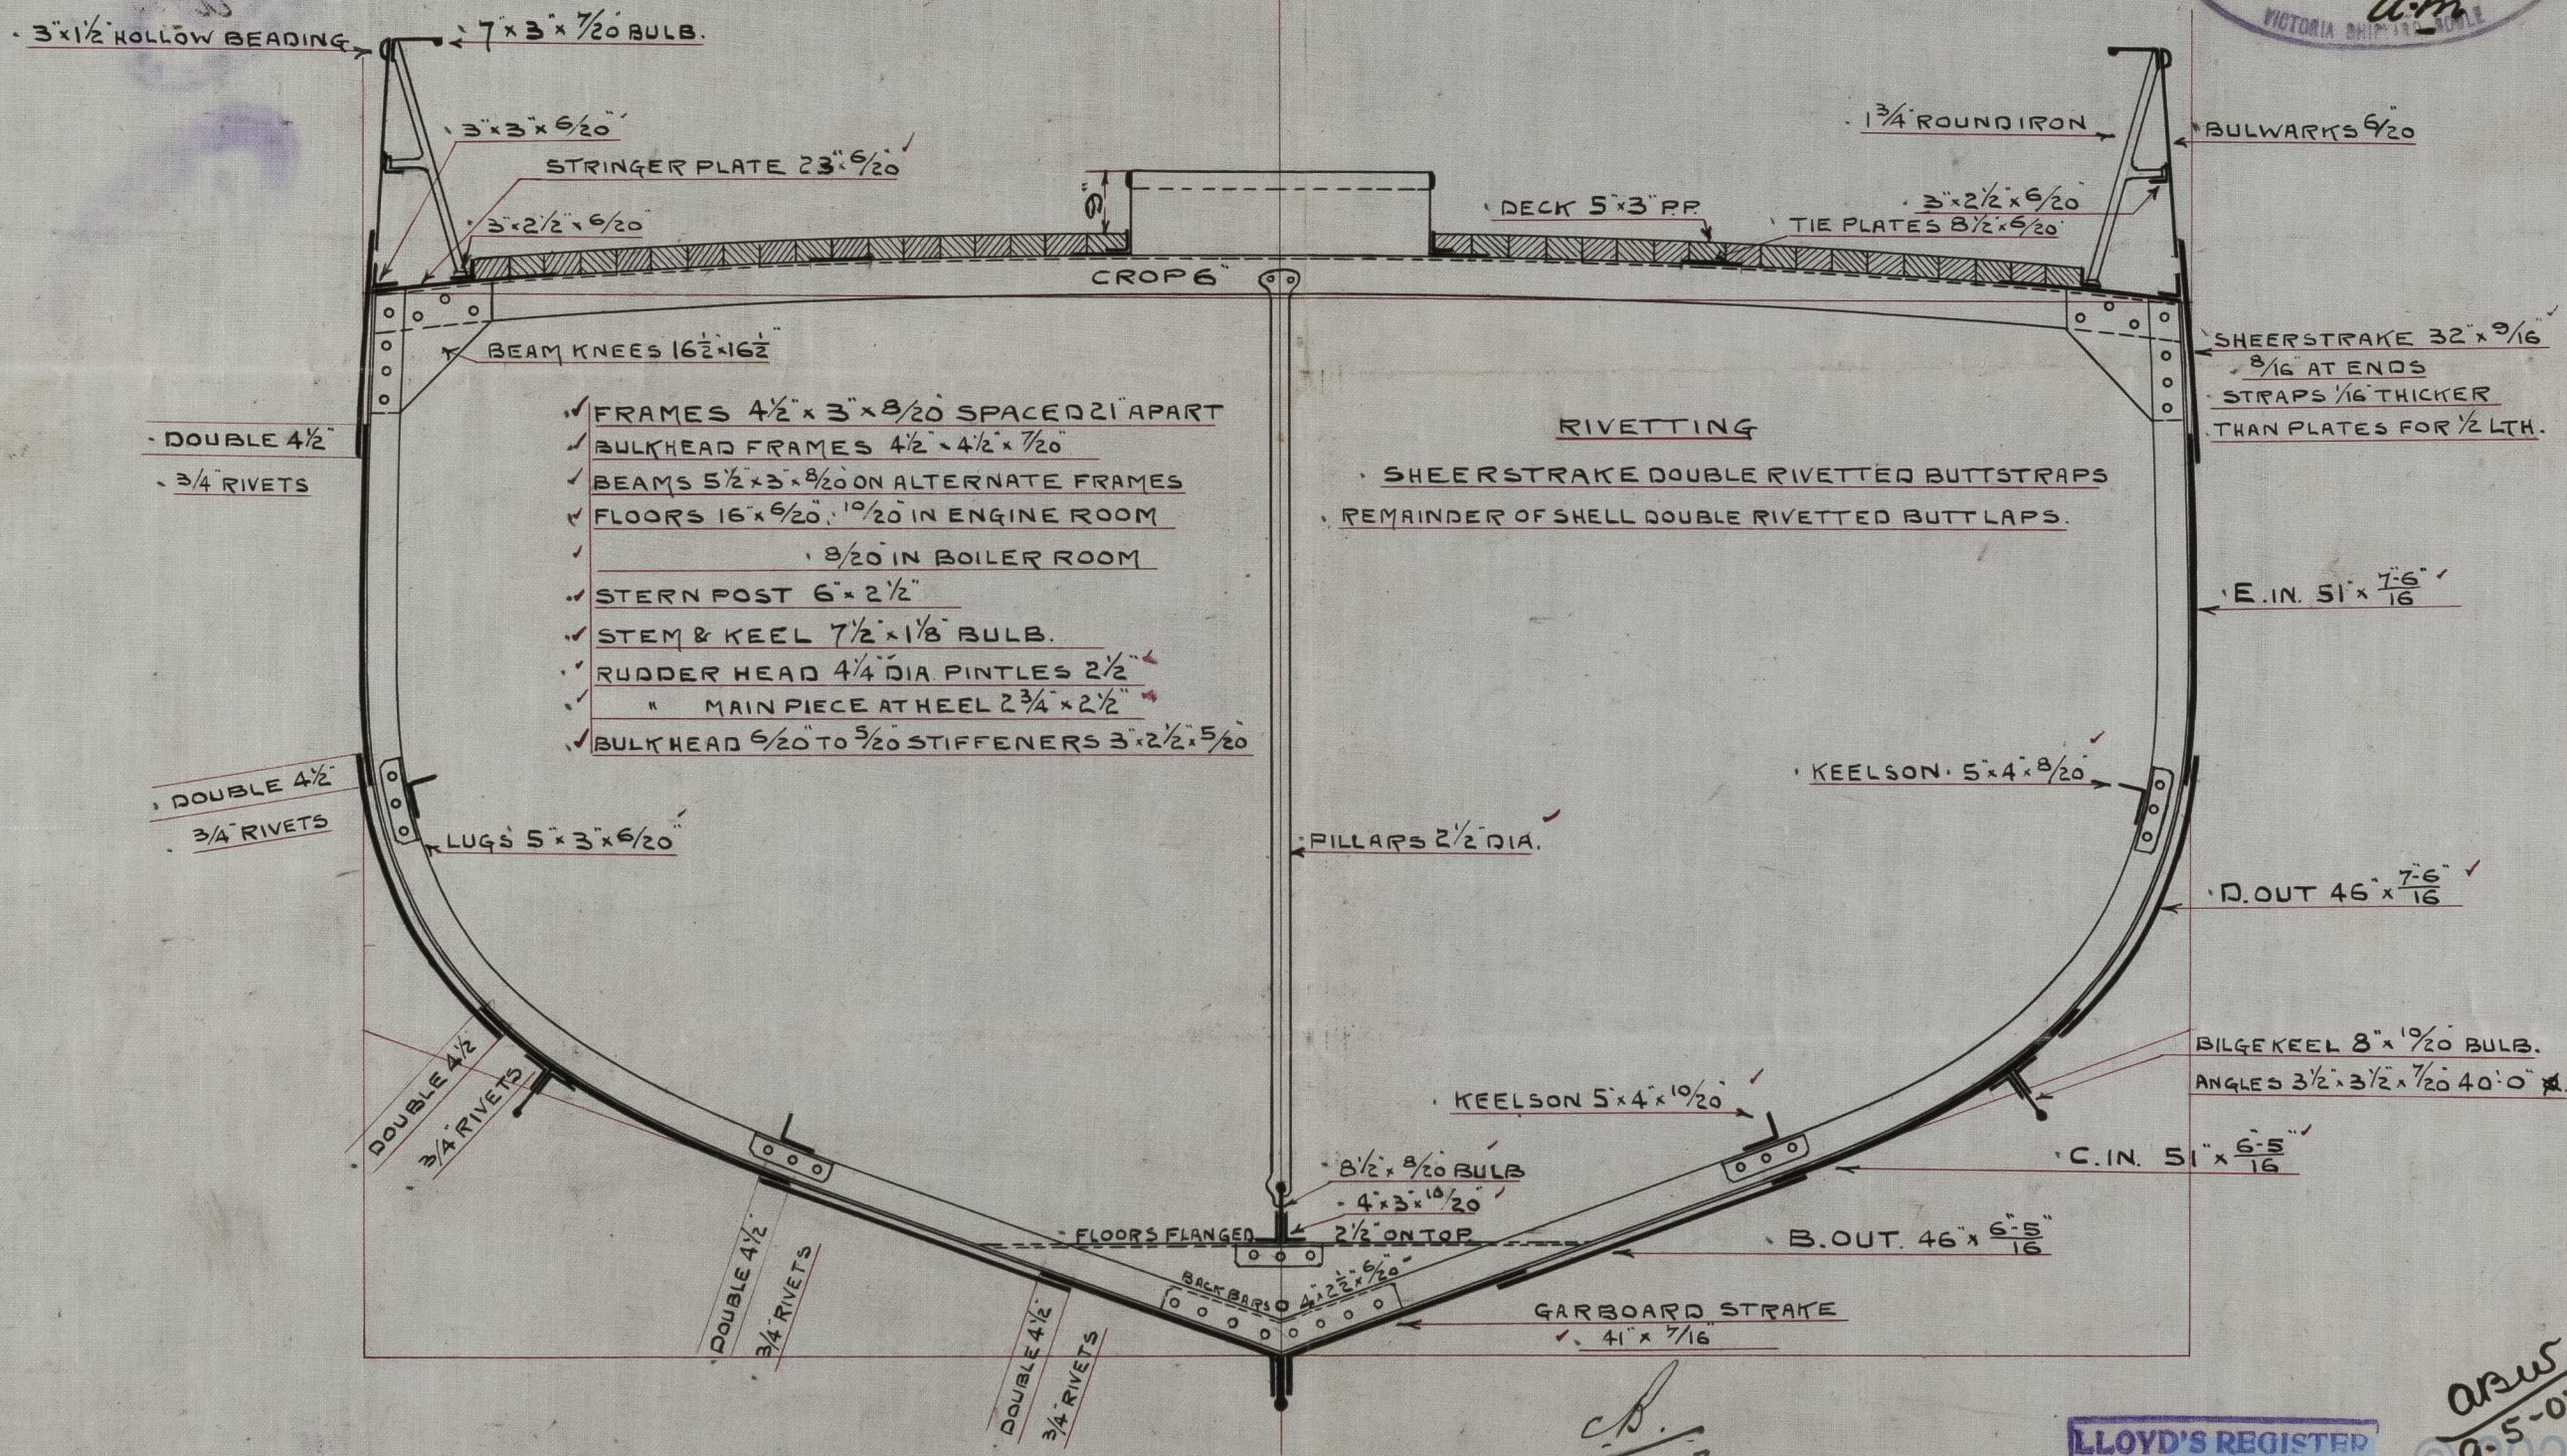
— TO CLASS 100 A.I. AT LLOYDS. —

— EQUIPMENT N° 4671 —

✓	1	ANCHOR ---	4 ³ / ₄ CWTs.	EX STOCK
✓	1	"	4 ¹ / ₄	" " "
✓	1	"	2 ¹ / ₂	" " "
✓	30 FTMS	15 ¹ / ₁₆	STUD LINK CHAIN.	
✓	60 "	5 ¹ / ₂	HAWSER	
✓	60 "	4	WARP	

11.5.07 NUMERALS.

1/2 GIRTH	19.16
DEPTH	13.00
1/2 BREADTH	10.75
1ST NO	42.31
LENGTH	108.875
2ND NO	4671.826

$$\frac{L}{B} = 5.06$$
$$-\frac{L}{D} = 8.37$$


LLOYD'S REGISTER
OF SHIPPING
9 MAY. 1907
+ FULL +

ans
9-5-07

Lloyd's Register
Foundation
W11596-0098

Goole S. & R. Co.
Midship Section.
Nos 99. 101. 106. 7. 8. 9. 10. + 11.

RETAIN

s/s Tern Hull Rpt No. 19510

Redcap	-	-	-	19530
Buzzard	-	-	-	19680.
Puffin	-	-	-	19726
Millet	-	-	-	19775
Mastwing	-	-	-	19967
Pintail	-	-	-	20.018
Towhee	-	-	-	20.180



© 2021

Lloyd's Register
Foundation