

-DIMENSIONS

LENGTH B.P. - 65'-0"
BREADTH M.L.D. - 15'-0"
DEPTH M.L.D. - 8'-6"

No 106. CLASS 100A. For Towing Purposes

SCALE :- $\frac{3}{4}'' = 1 \text{ FOOT.}$

$\kappa^{\text{of}}_{\cdot} 23.5 + 1527$

—EQUIPMENT.—

ANCHOR $2\frac{1}{2}$ CWT EX STOCK


1 " $1\frac{1}{2}$ " " "

60 FATHOMS $\frac{3}{4}$ " STUD LINK CABLE

60 " 5" COIR ROPE

60 " $2\frac{1}{2}$ " "

$\frac{1}{2}$ BREATH = 7.5
 $\frac{1}{2}$ GIRTH = 13.75
 DEPTH = $\frac{8.83}{30.08} \text{ IN}^0$
 $\frac{64.083}{1927.61664} \text{ 2}^{\text{ND}} \text{ IN}^0$

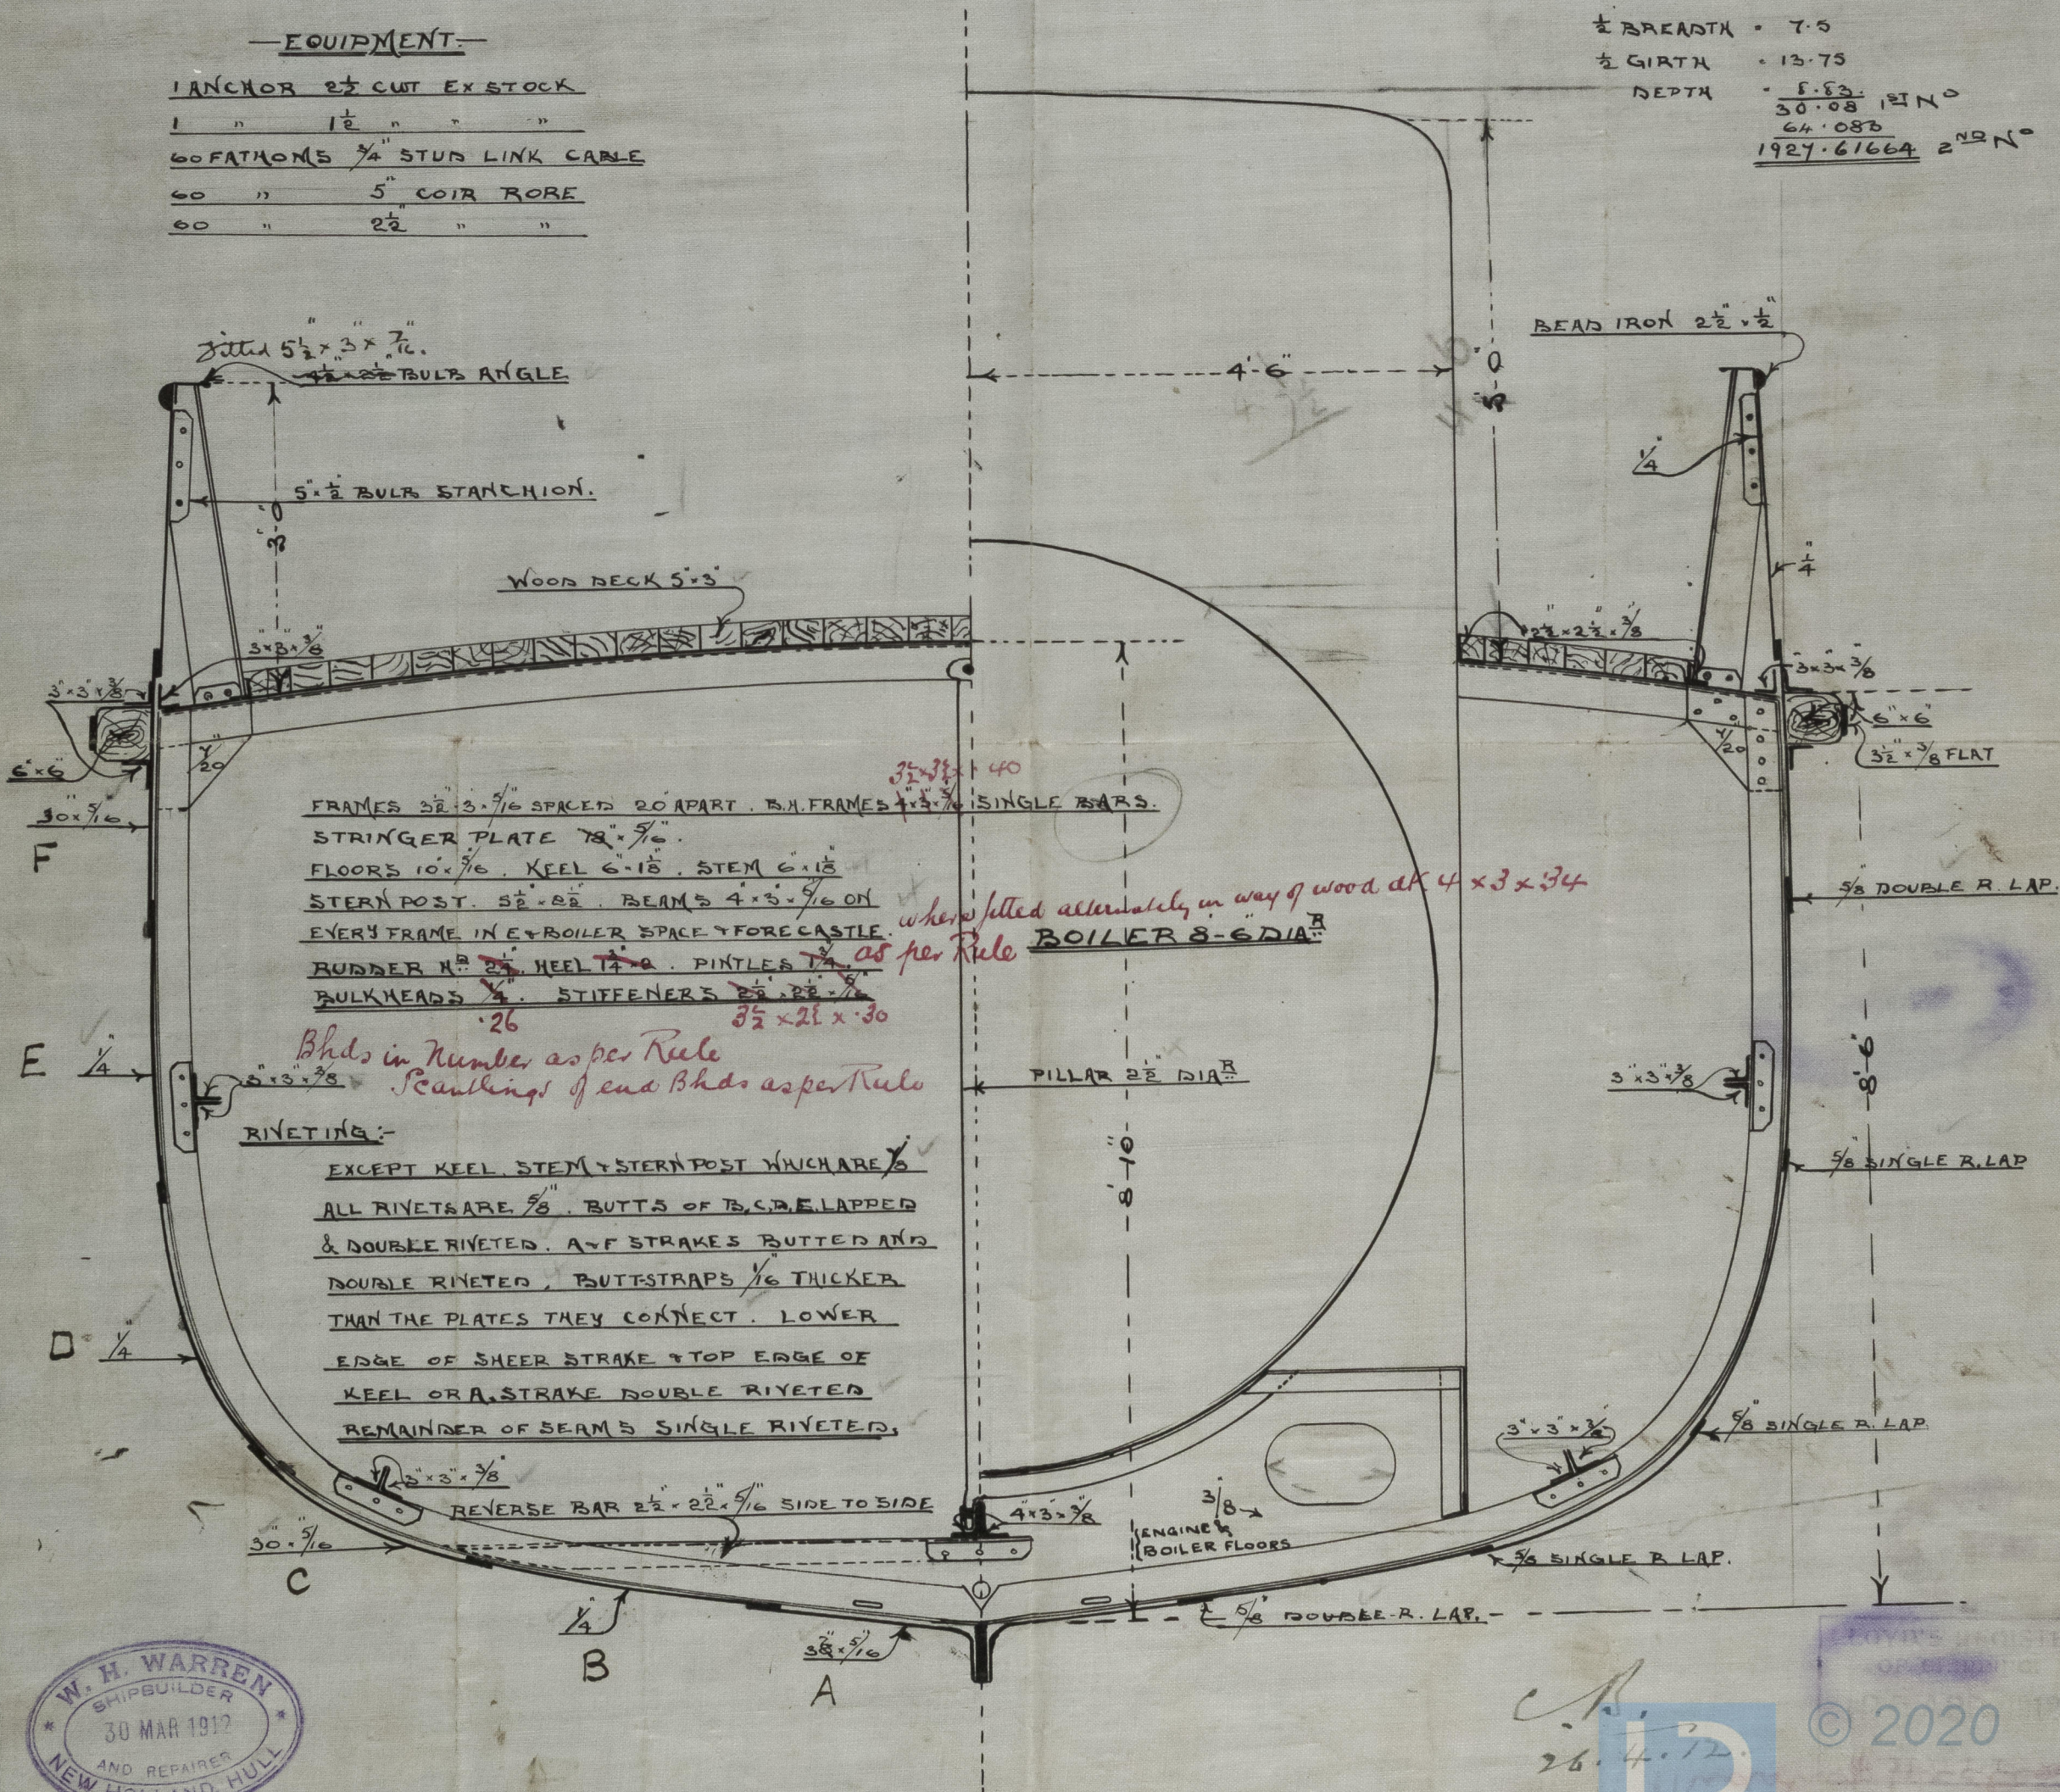

Lloyd's Register
Foundation

W1599-0035

W. H. Warren
No 106

Midship Section.

J. Talbot

Steel Rpt No 26974



© 2020

Lloyd's Register
Foundation
W1599-0035

