



22.5.06
12.11.06
(111, 112) 2.3.07.
113.
114. 16:10:07
115 24:10:07

Passenger and Cargo Steamer. -


Shor-deck Rule - +100A, Lloyd's.

356' x 44' x 25' 10"

107, 108, 111, 112 + 113. 114, 115.

Longitudinal Section. -

- Scale: 1/8" = 1'. -

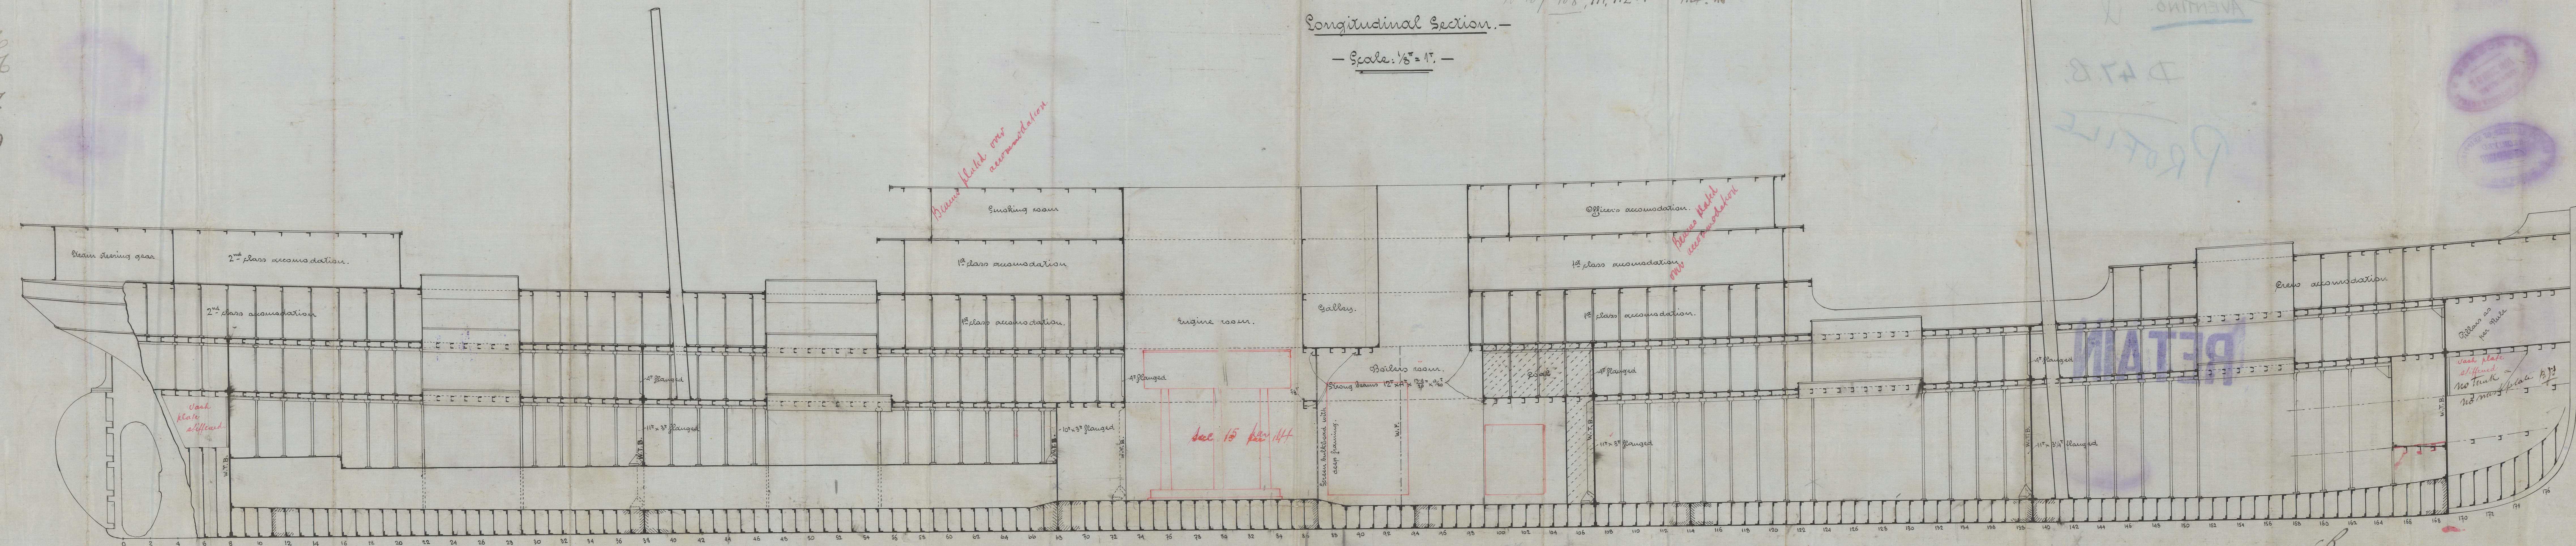

From Port
to Starboard
107, 108, 111, 112 + 113. 114, 115.

Now
Venture
D.A.B.
107, 108, 111, 112 + 113. 114, 115.

C.B.
22.5.06.

Gray

AVENTINO.

4

PROFILE

RETAIN