


107, 108, 111, 112 + 113 + 114 + 115


DIMENSIONS 356' x 44' x 25'10"

SCALE $\frac{1}{8}" = 1'$

BRIDGE DECK.

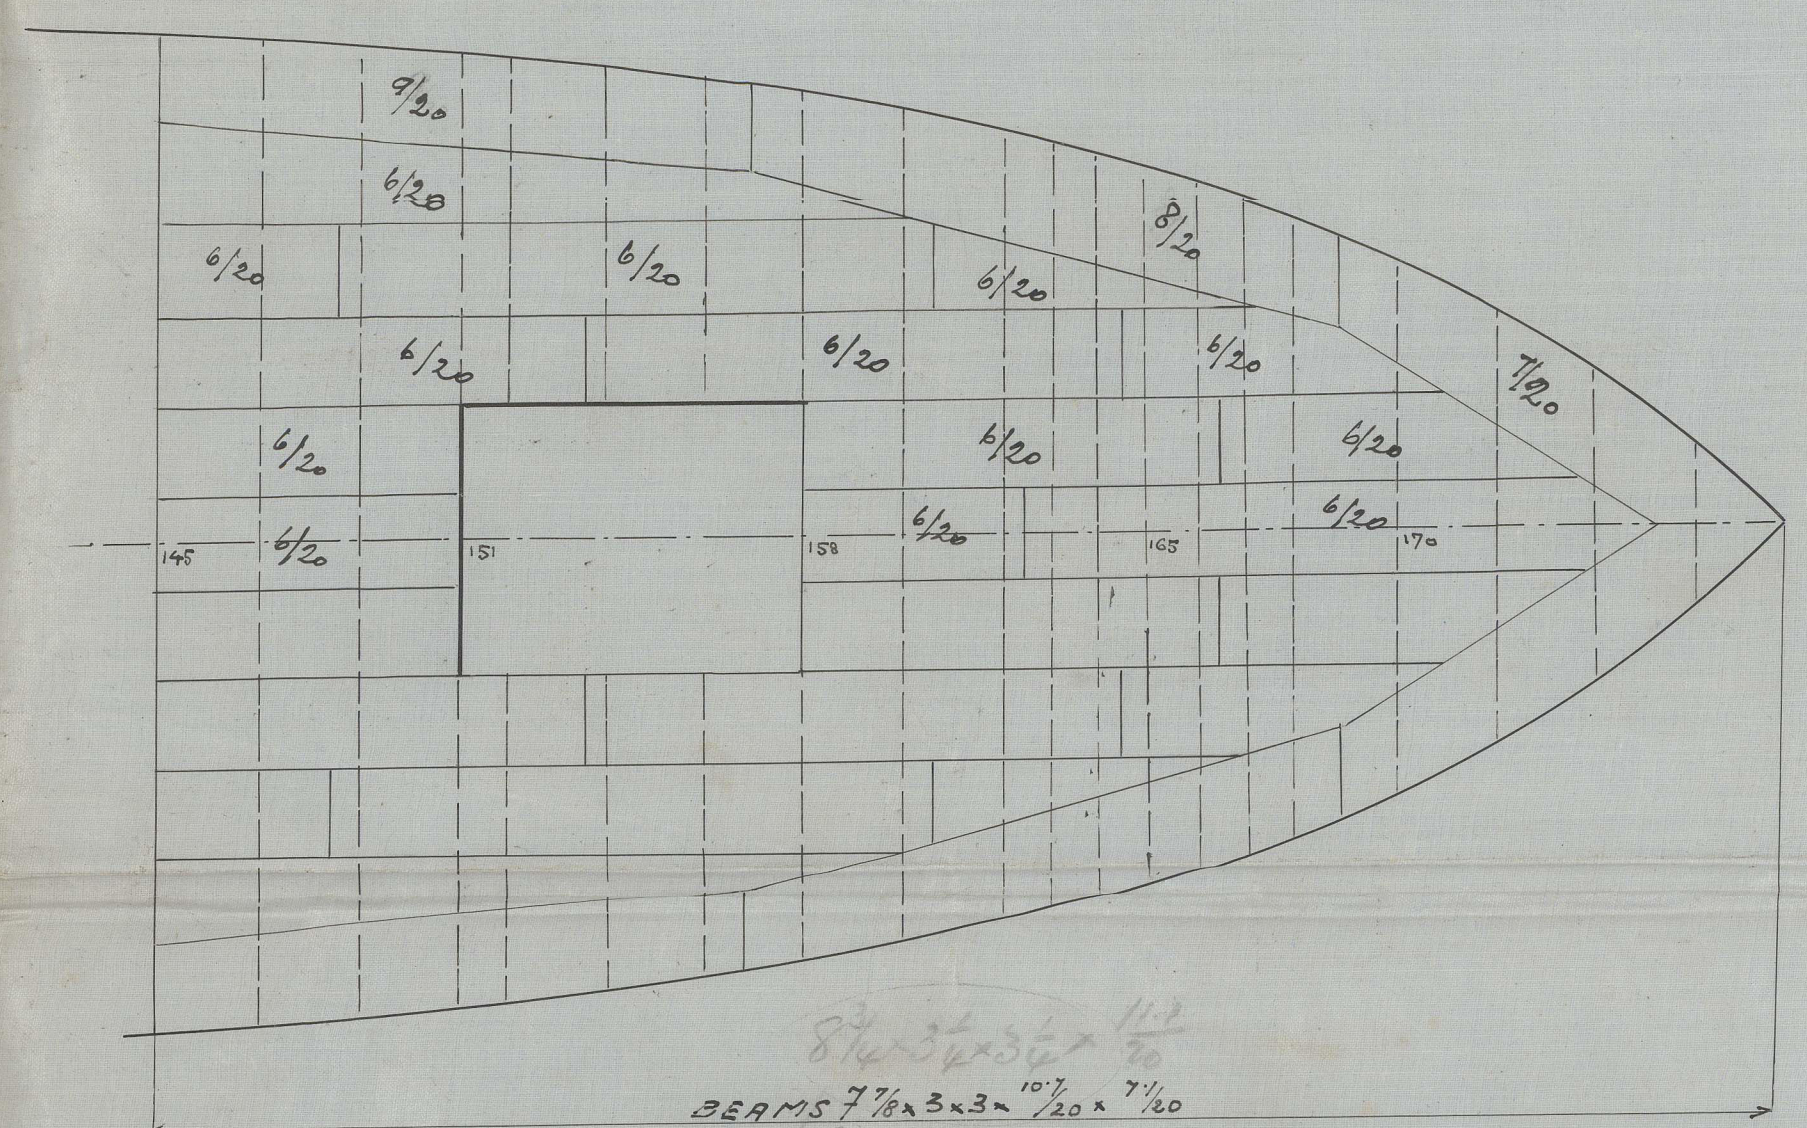


SPAR DECK

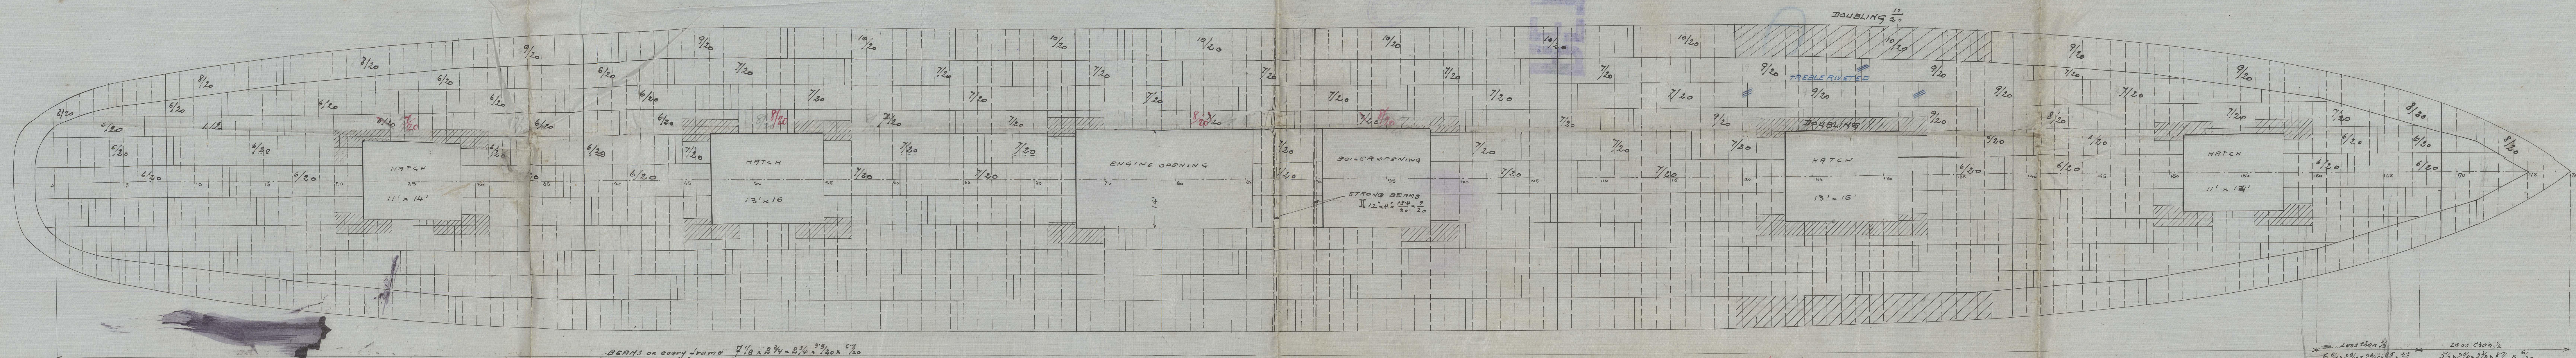

MAIN DECK

webs and fore and afters in hatches
asper Rules.

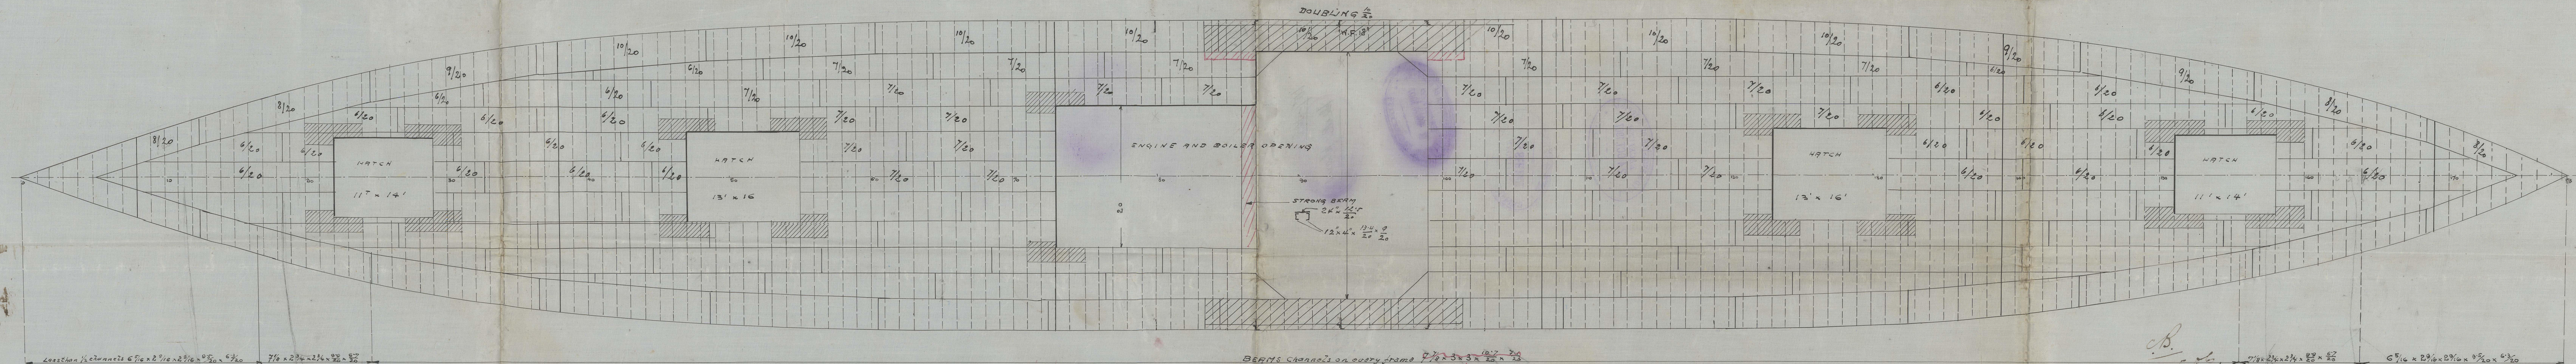

Palacky
Gray

Gray

© 2020

Lloyd's Register
Foundation

2/0

















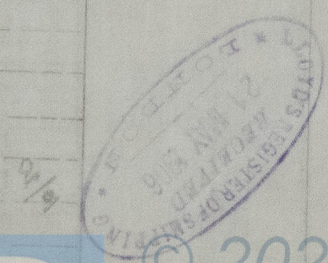

DKS

RETAIN



© 2020

Lloyd's Register
Foundation

W1599-0171