



Spandeck

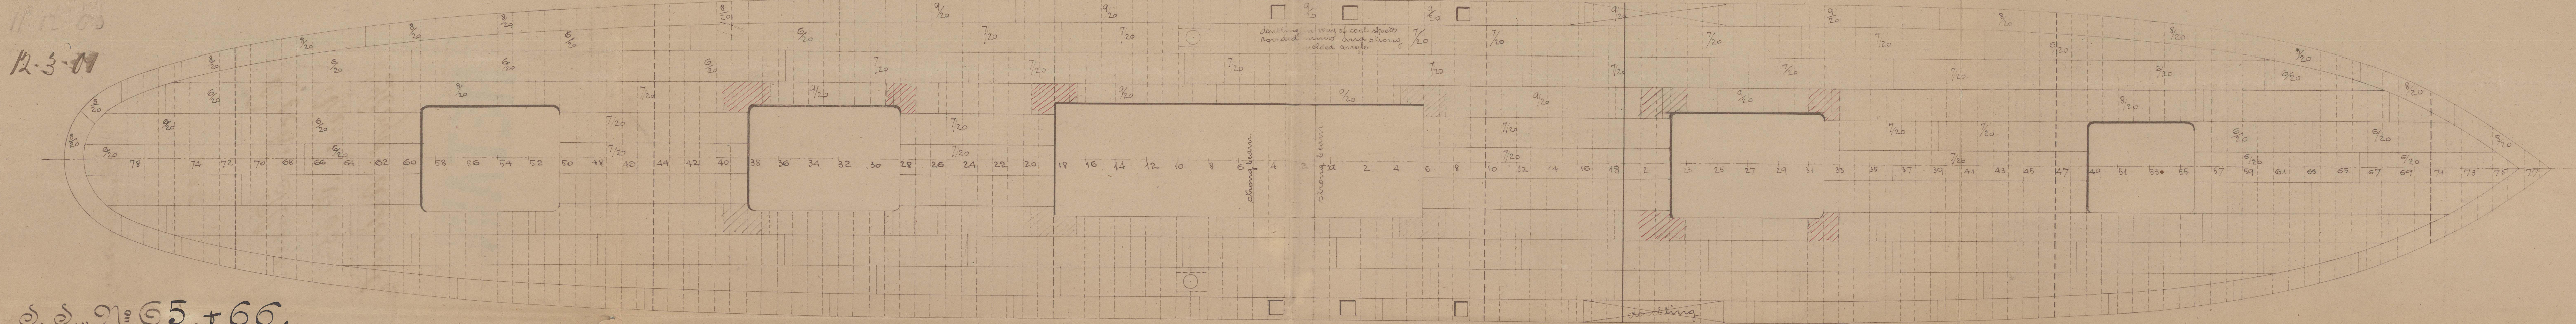

S. S. No 65 + 66.

Dimensions.
Length 345'0"
Breadth 42'3"
Depth to Sp. deck 24'3"
- Scale = 1" = 1'

Maindeck

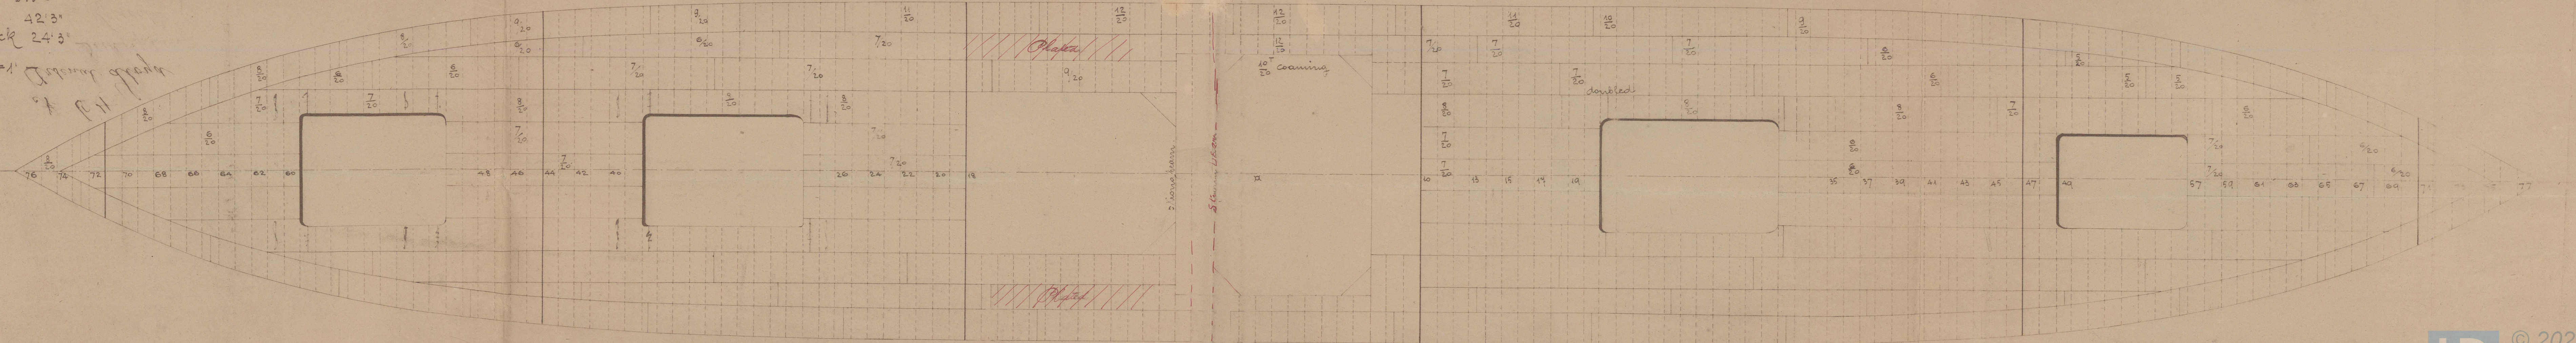

W1599-0210

No 2 C



*S.S. Bucovina &
Galiccia
Trieste Report*

*N. 692
418*

Deck Plan.

*Yard: N: 65+66
Lloyd: Arsenal.*

RETAIN



© 2020

Lloyd's Register
Foundation

W 599-0210