


SO 2963 B
Muller & Co. Donkey Boiler
(18963)
Donkey Boiler

Denny 1897
for
Austrian Lloyd Co. 1895-1896

165 lb working pressure


RETAIN

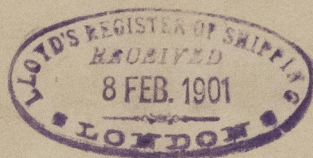

Glasgow Report No. 19218



S. S. Bucovina
Trieste Report
N. 692

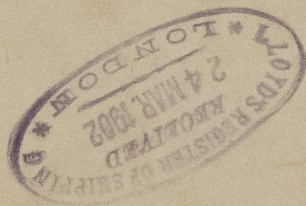

This drawing refers also
to the Glasgow Report N. 18937 which will be sent
to your office with the first
entry Report on the S. S.
Galicia sister ship

17/3/902

W1544-0214