


DIMENSIONS 340'-0" 44'-6" x 26'-0" MLD TO UPPER DK

SCALE $\frac{1}{2}'' = 1 \text{ FOOT}$.

15. 10. 06
19. 12. 06
21. 3. 07
26. 6. 07
13. 8. 07

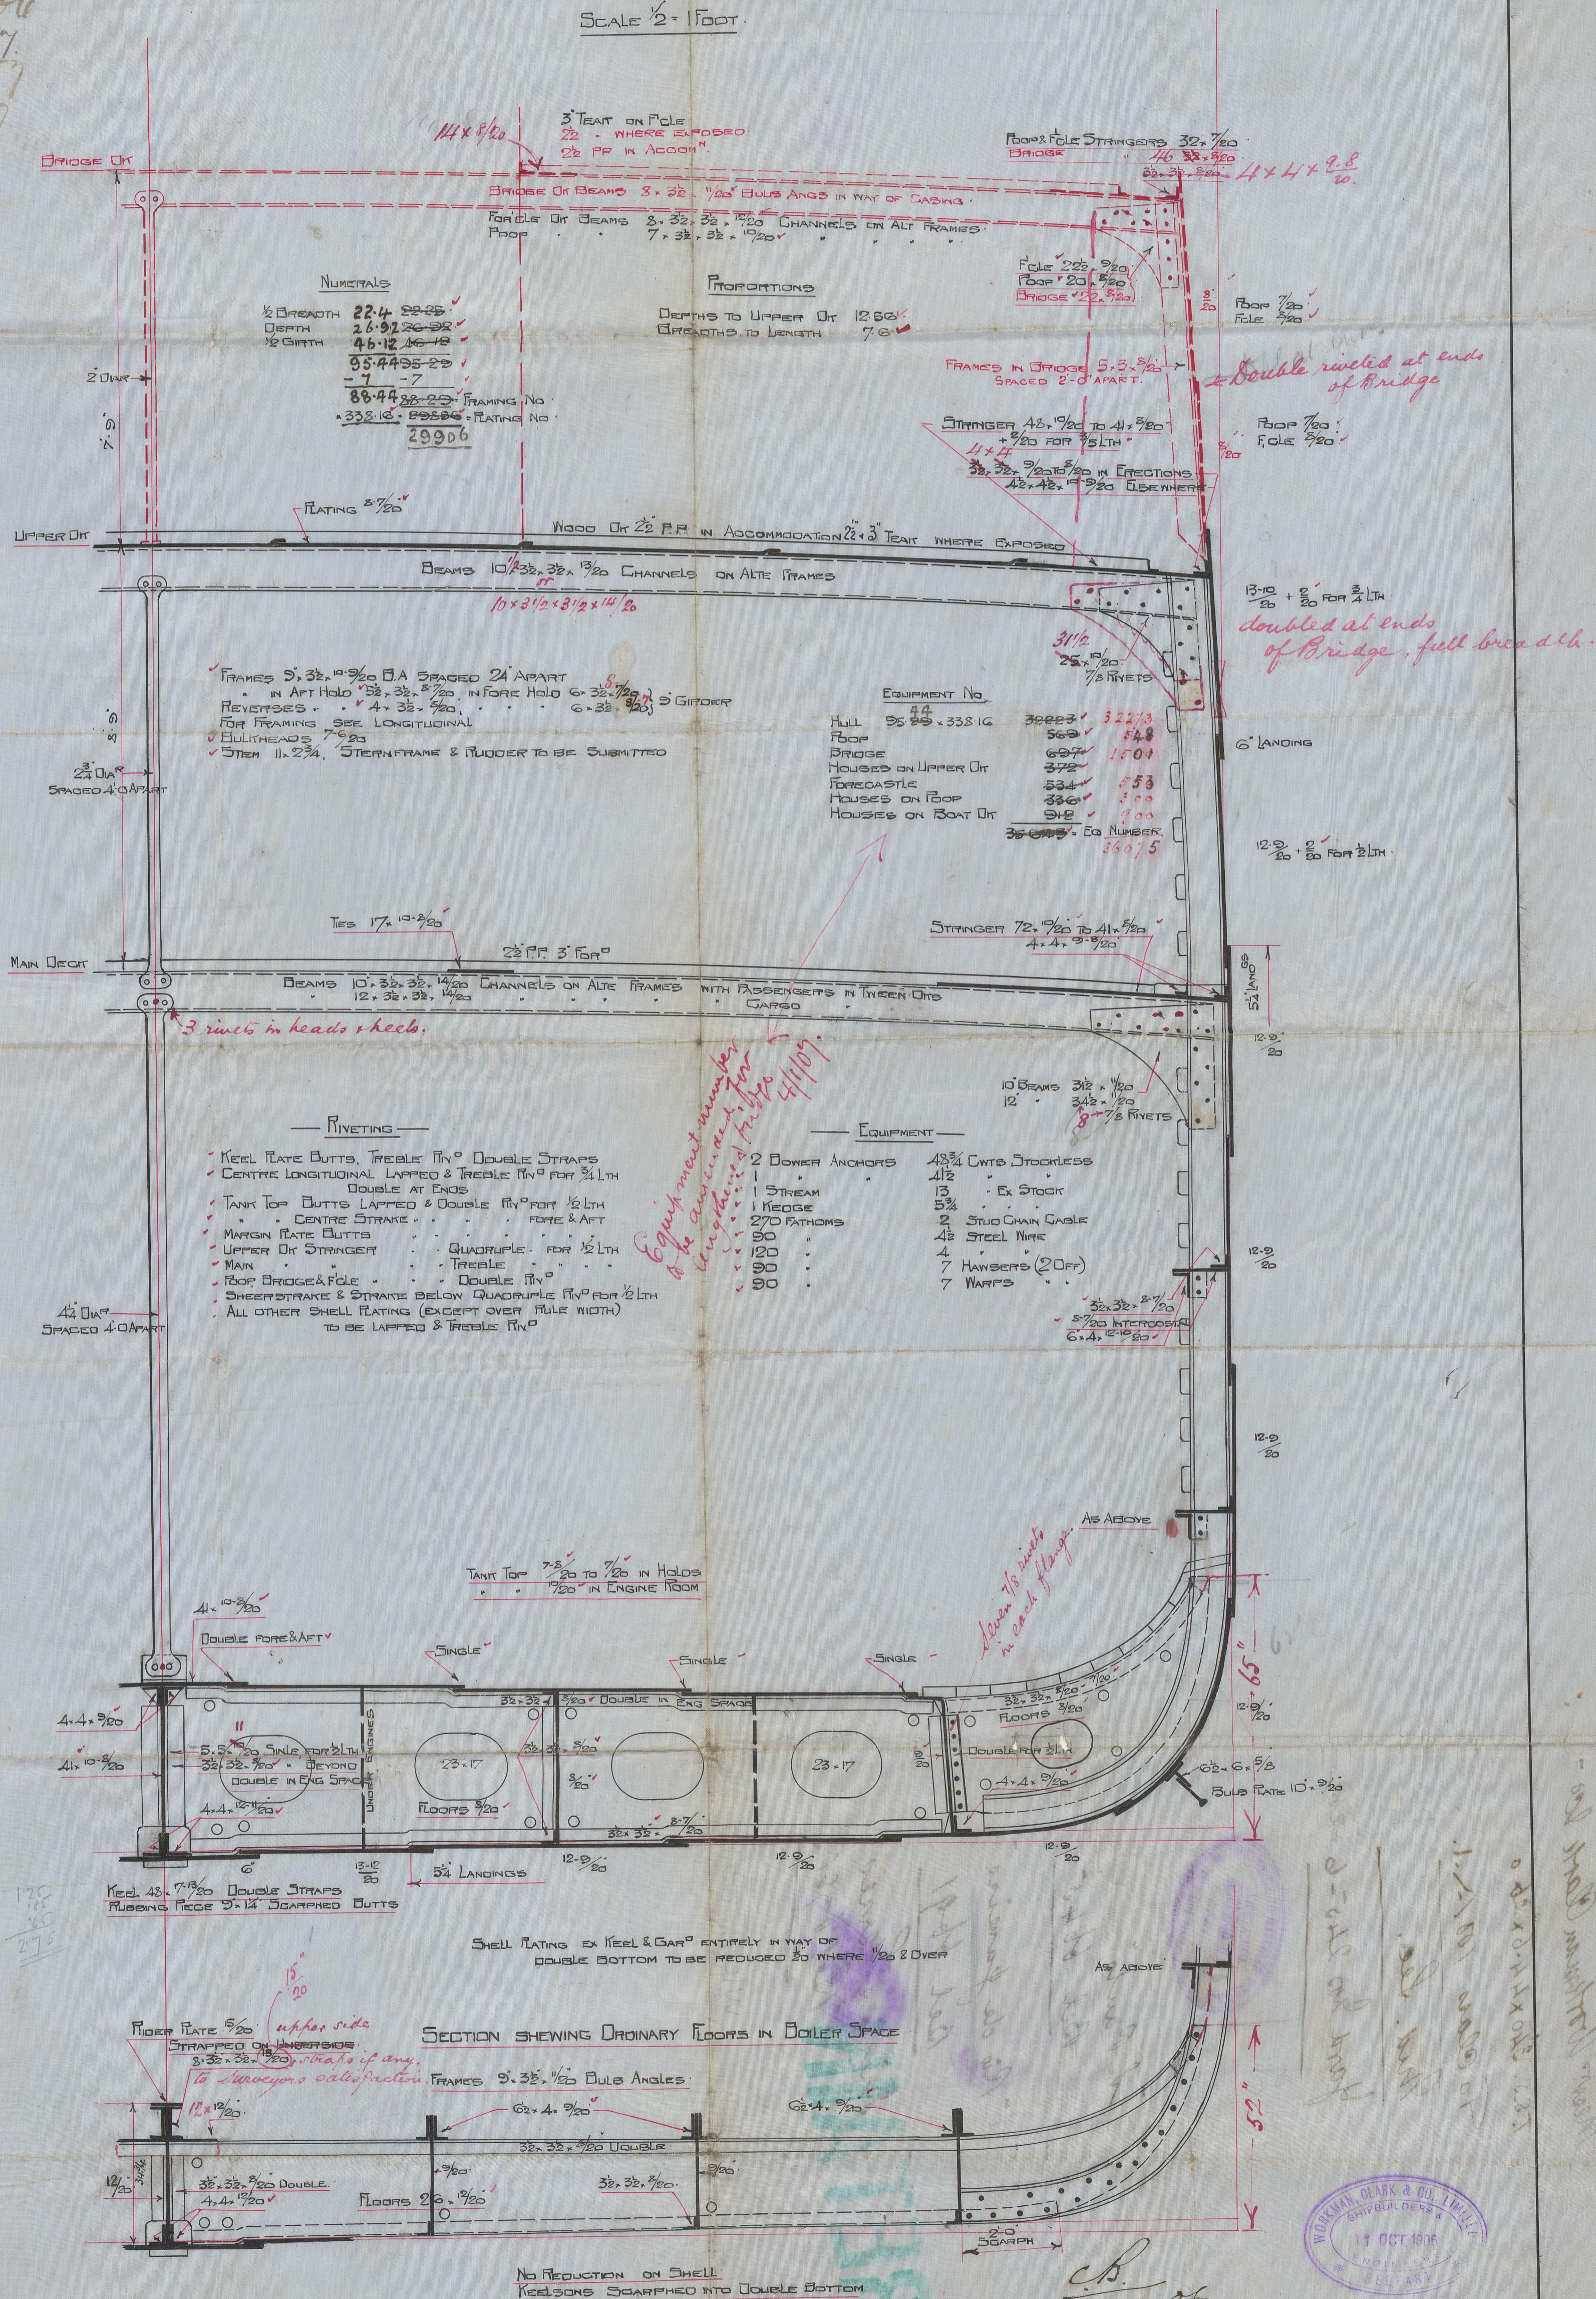

A circular purple ink stamp. The outer ring contains the text "WORKMAN, CLARK & CO., LIMITED" at the top and "BELFAST" at the bottom, separated by small decorative stars. Inside the ring, the text "SHIPBUILDERS &" is at the top and "ENGINEERS" is at the bottom. In the center of the stamp is the date "17 OCT. 1906".

Messrs Workman Clark & Co

T.S.S. 340 x 44.6 x 26 0

To Class 100/12.1.

Ind. Sec.

Gard nos 245-6 + 264.



S. Paulo

Bel 6645

"Rio de Janeiro"

Bel 6691

Minas Geraes

Bel 6781.

Lloyd's Register
Foundation

W1601-0020

"S. Paulo"
Bel 6645.



© 2021

Lloyd's Register
Foundation