

9.8.04
13.8.04

Longitudinal Section & Deck Plans.

S.S. No 530-1


Dim: 294' x 40'-4" Ez 40'-2" Mid x 27'-9" to Spar Dr.
20'-0" to Main Deck

To class 100 A1 at Lloyd's Spar Dr. Rule.

Scale 1/8" = one foot.



Fore & Main Mast 2 poles in the round.
Batts lapped & 2 R. abn Deck, 2 R. below Dr.
Stems lapped & single rooted.

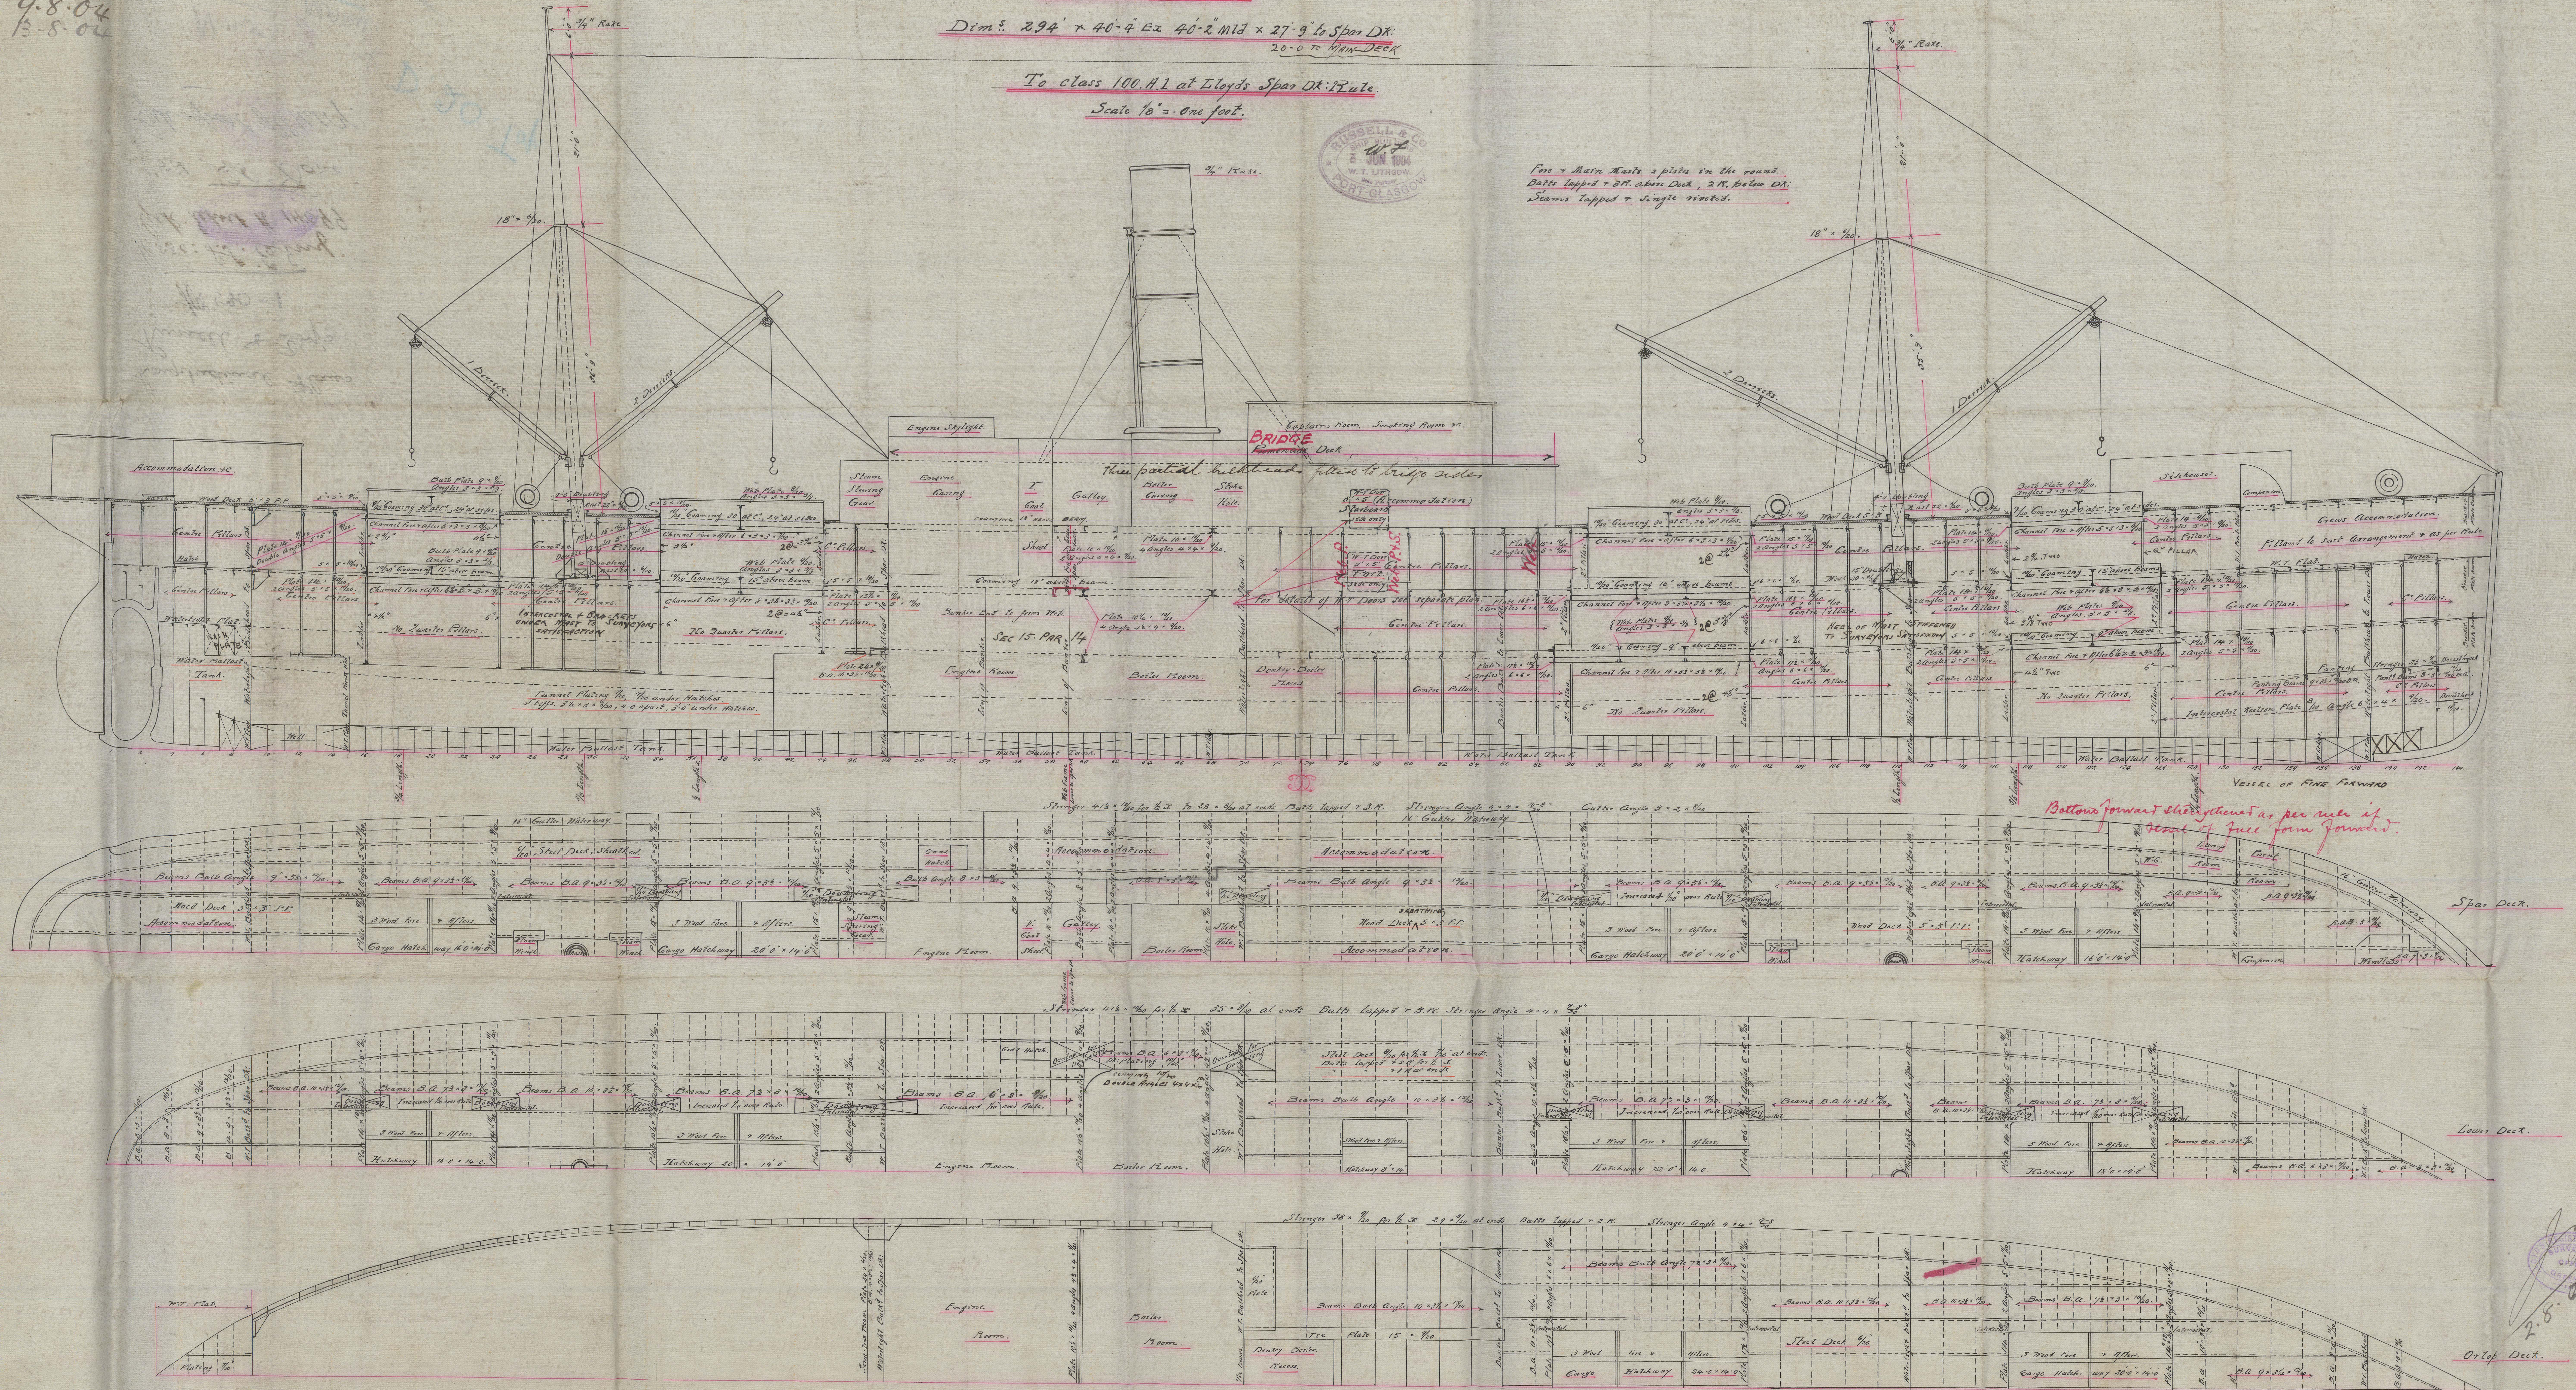

2.5.04
J.P.
9/10/04

Longitudinal Plans
Russell & Co's
No 530-1

No 530: P.S. Emy.
Grk report No 14099

No 521 P.S. "Dora"
Grk report No 14117.

Now
NIITAKA MARU

D. 20. Top

D 20. T.

RETAIN



© 2021

Lloyd's Register
Foundation

W1601-0147