

SCALE $\frac{1}{2}$ " IN. = 1' FOOT.

S.A. Beam

3 inches

Frame $5' \times 3' \times 8\frac{7}{20}'$


Inv. Frame $3\frac{1}{2}' \times 3' \times 8\frac{7}{20}'$

Sections of Deep Framing Asth

For scamlings of birds see
detail sketch. see General letters
13/8/04 + 16/8/04

Section of After Hold

Section of Fore Hold.

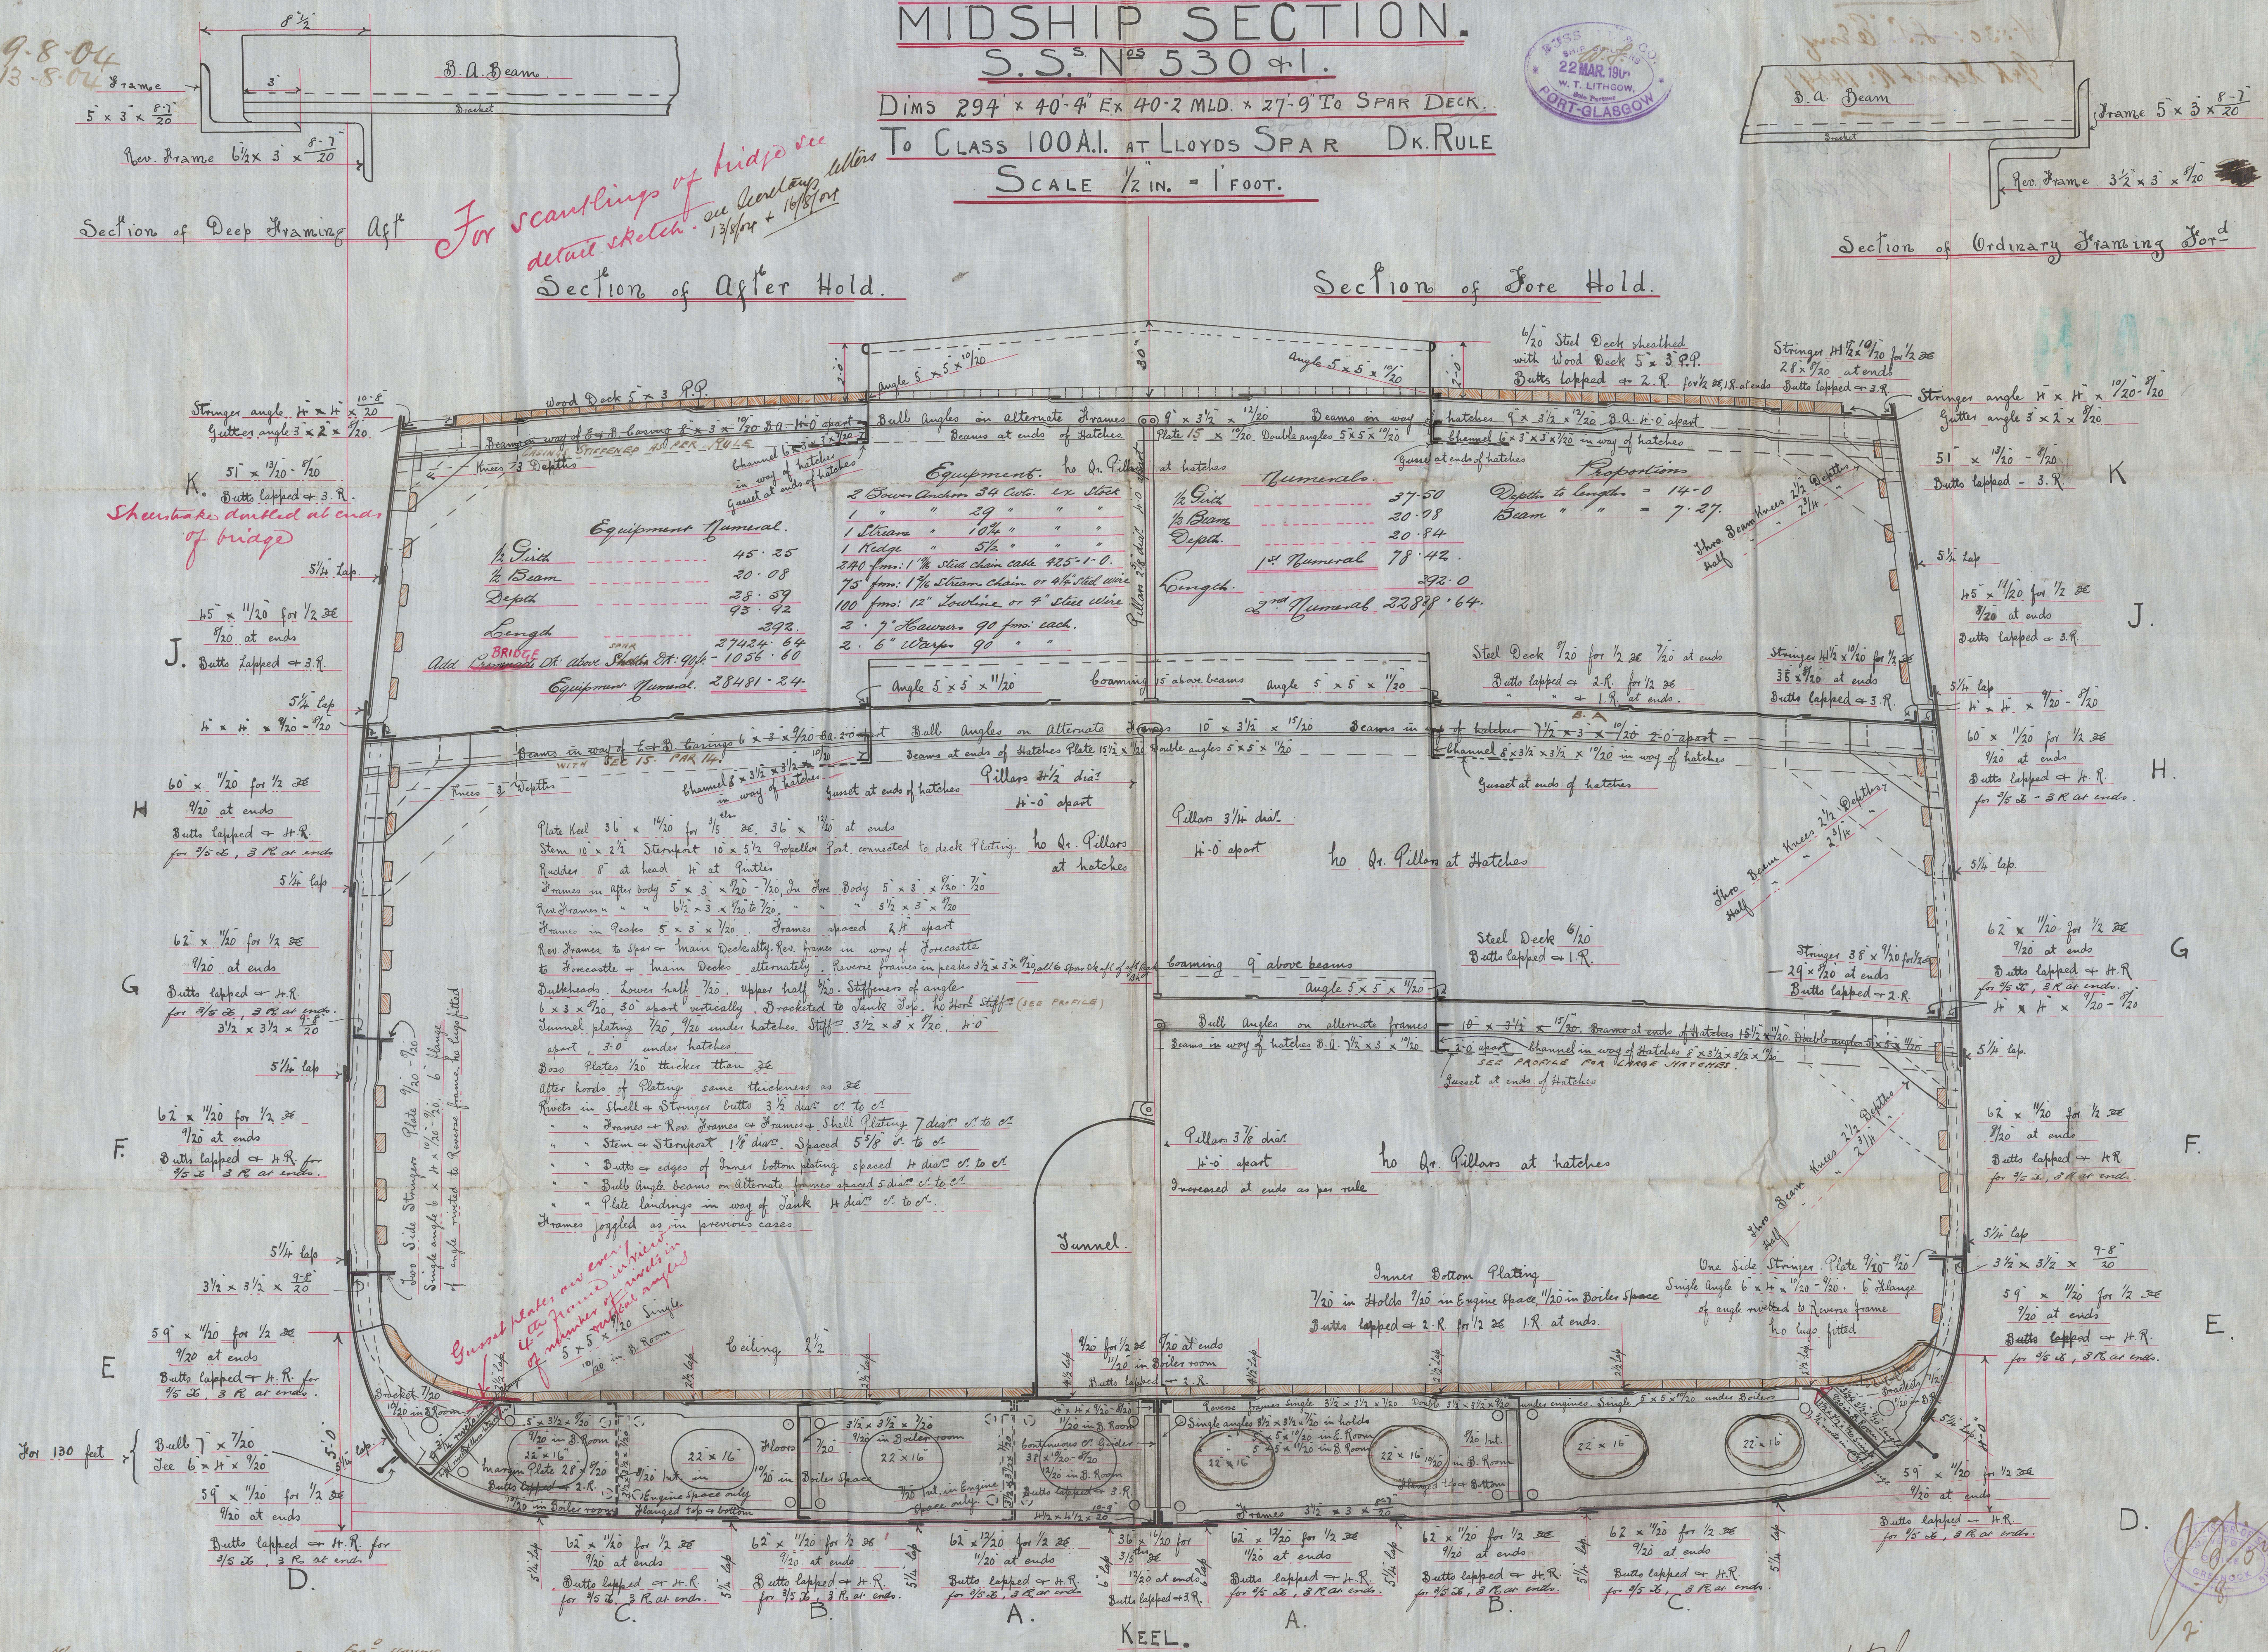

MODEL WILL BE OF VERY FINE FORM FOR^O HAVING
A TONNAGE COEF NOT EXCEEDING 75-

Inside of $\frac{1}{8}$ length Midships

Butto of Outside Strokes of Shell Plating where H_b wide or under to be 3 R.

" " Inside " " " " 5 ft " " " " 3 R.

J. A. L.
878704

Midship Section

Russell & Coys

N^o. 530-1

N^o. 530: L.S. Ermy.

Gen Report N^o. 14099

N^o. 531, L.S. Dora

Gen report N^o. 14117.

REMAIN



© 2021

Lloyd's Register
Foundation