



COYLON

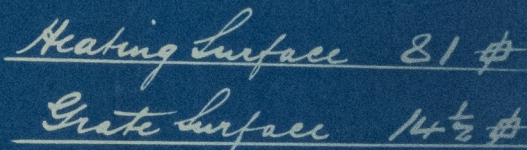

Vertical seams of shell double riveted $\frac{13}{16}$ holes $2\frac{3}{4}$ pitch
Circumferential " " single " $\frac{13}{16}$ " 3 " "

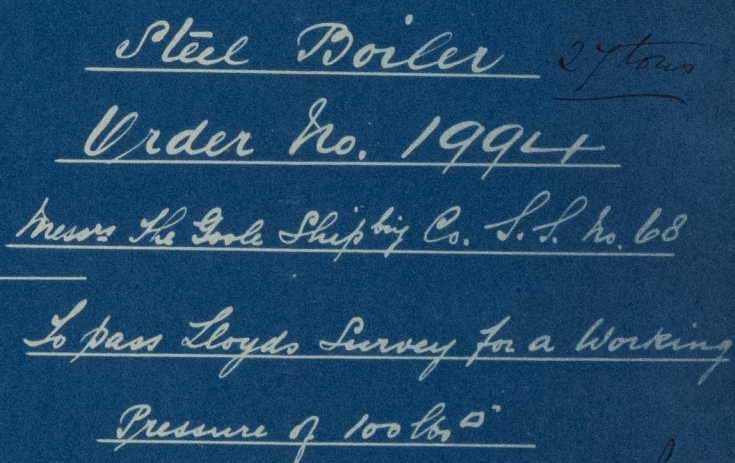

Scale 1" = 1 ft.


S. J. M.
17/2/05

J. Sudron & Co^{rs}


No 1994

Goble & B Co No 68th

100lb m.r.

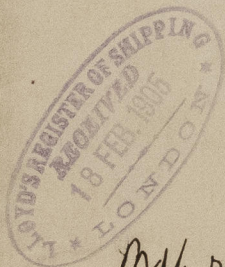

Made report No 4601

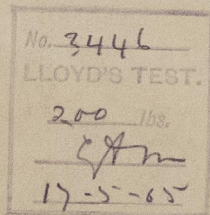

Sc. Sr. Lees

Hull Report No. 18284



W1602-0021

RETAIN

Sh



© 2021

Lloyd's Register
Foundation