

S.S. N° 68.

MIDSHIP SECTION

— OF A —
STEEL SCREW STEAMER.

DIMENSIONS: 165'-0" BP - 26'-0" - 13'-4 1/2" MLD

TO CLASS 100 A1 LLOYDS.

SCALE 1/2" = 1 FOOT

L/B = 6.30

L/D = 11.77

DISPL. COEFF. 73

EQUIPMENT N° = 8685-51.

R.O.D. = 2(87.5 x 3.75) + BRIDGE = 1.5(14.0 x 6.75) +

FORECASTLE = 1.5(22.0 x 7.5) + N° 842870 = 94449

2 BOWERS 12 1/2 CTS STOCKLESS

1 " 10 1/2 " "

1 STREAM 4 3/2 " EX STOCK

1 KEDGE 1 1/2 " "

175 165 Fm² 1/16" STUD CHAIN CABLE

60 " 2 3/4" STEEL WIRE



75 " 2 3/4" " "

90 " 6 5/8" HAWSER

23-3-04

18-1-06 NUMERALS

1/2 BREADTH	13' 00
1/2 GIRTH	24' 50
DEPTH	13' 92
	51' 42 1 st N°
LENGTH	163' 92
	8428' 76 2 nd N°

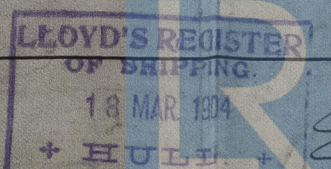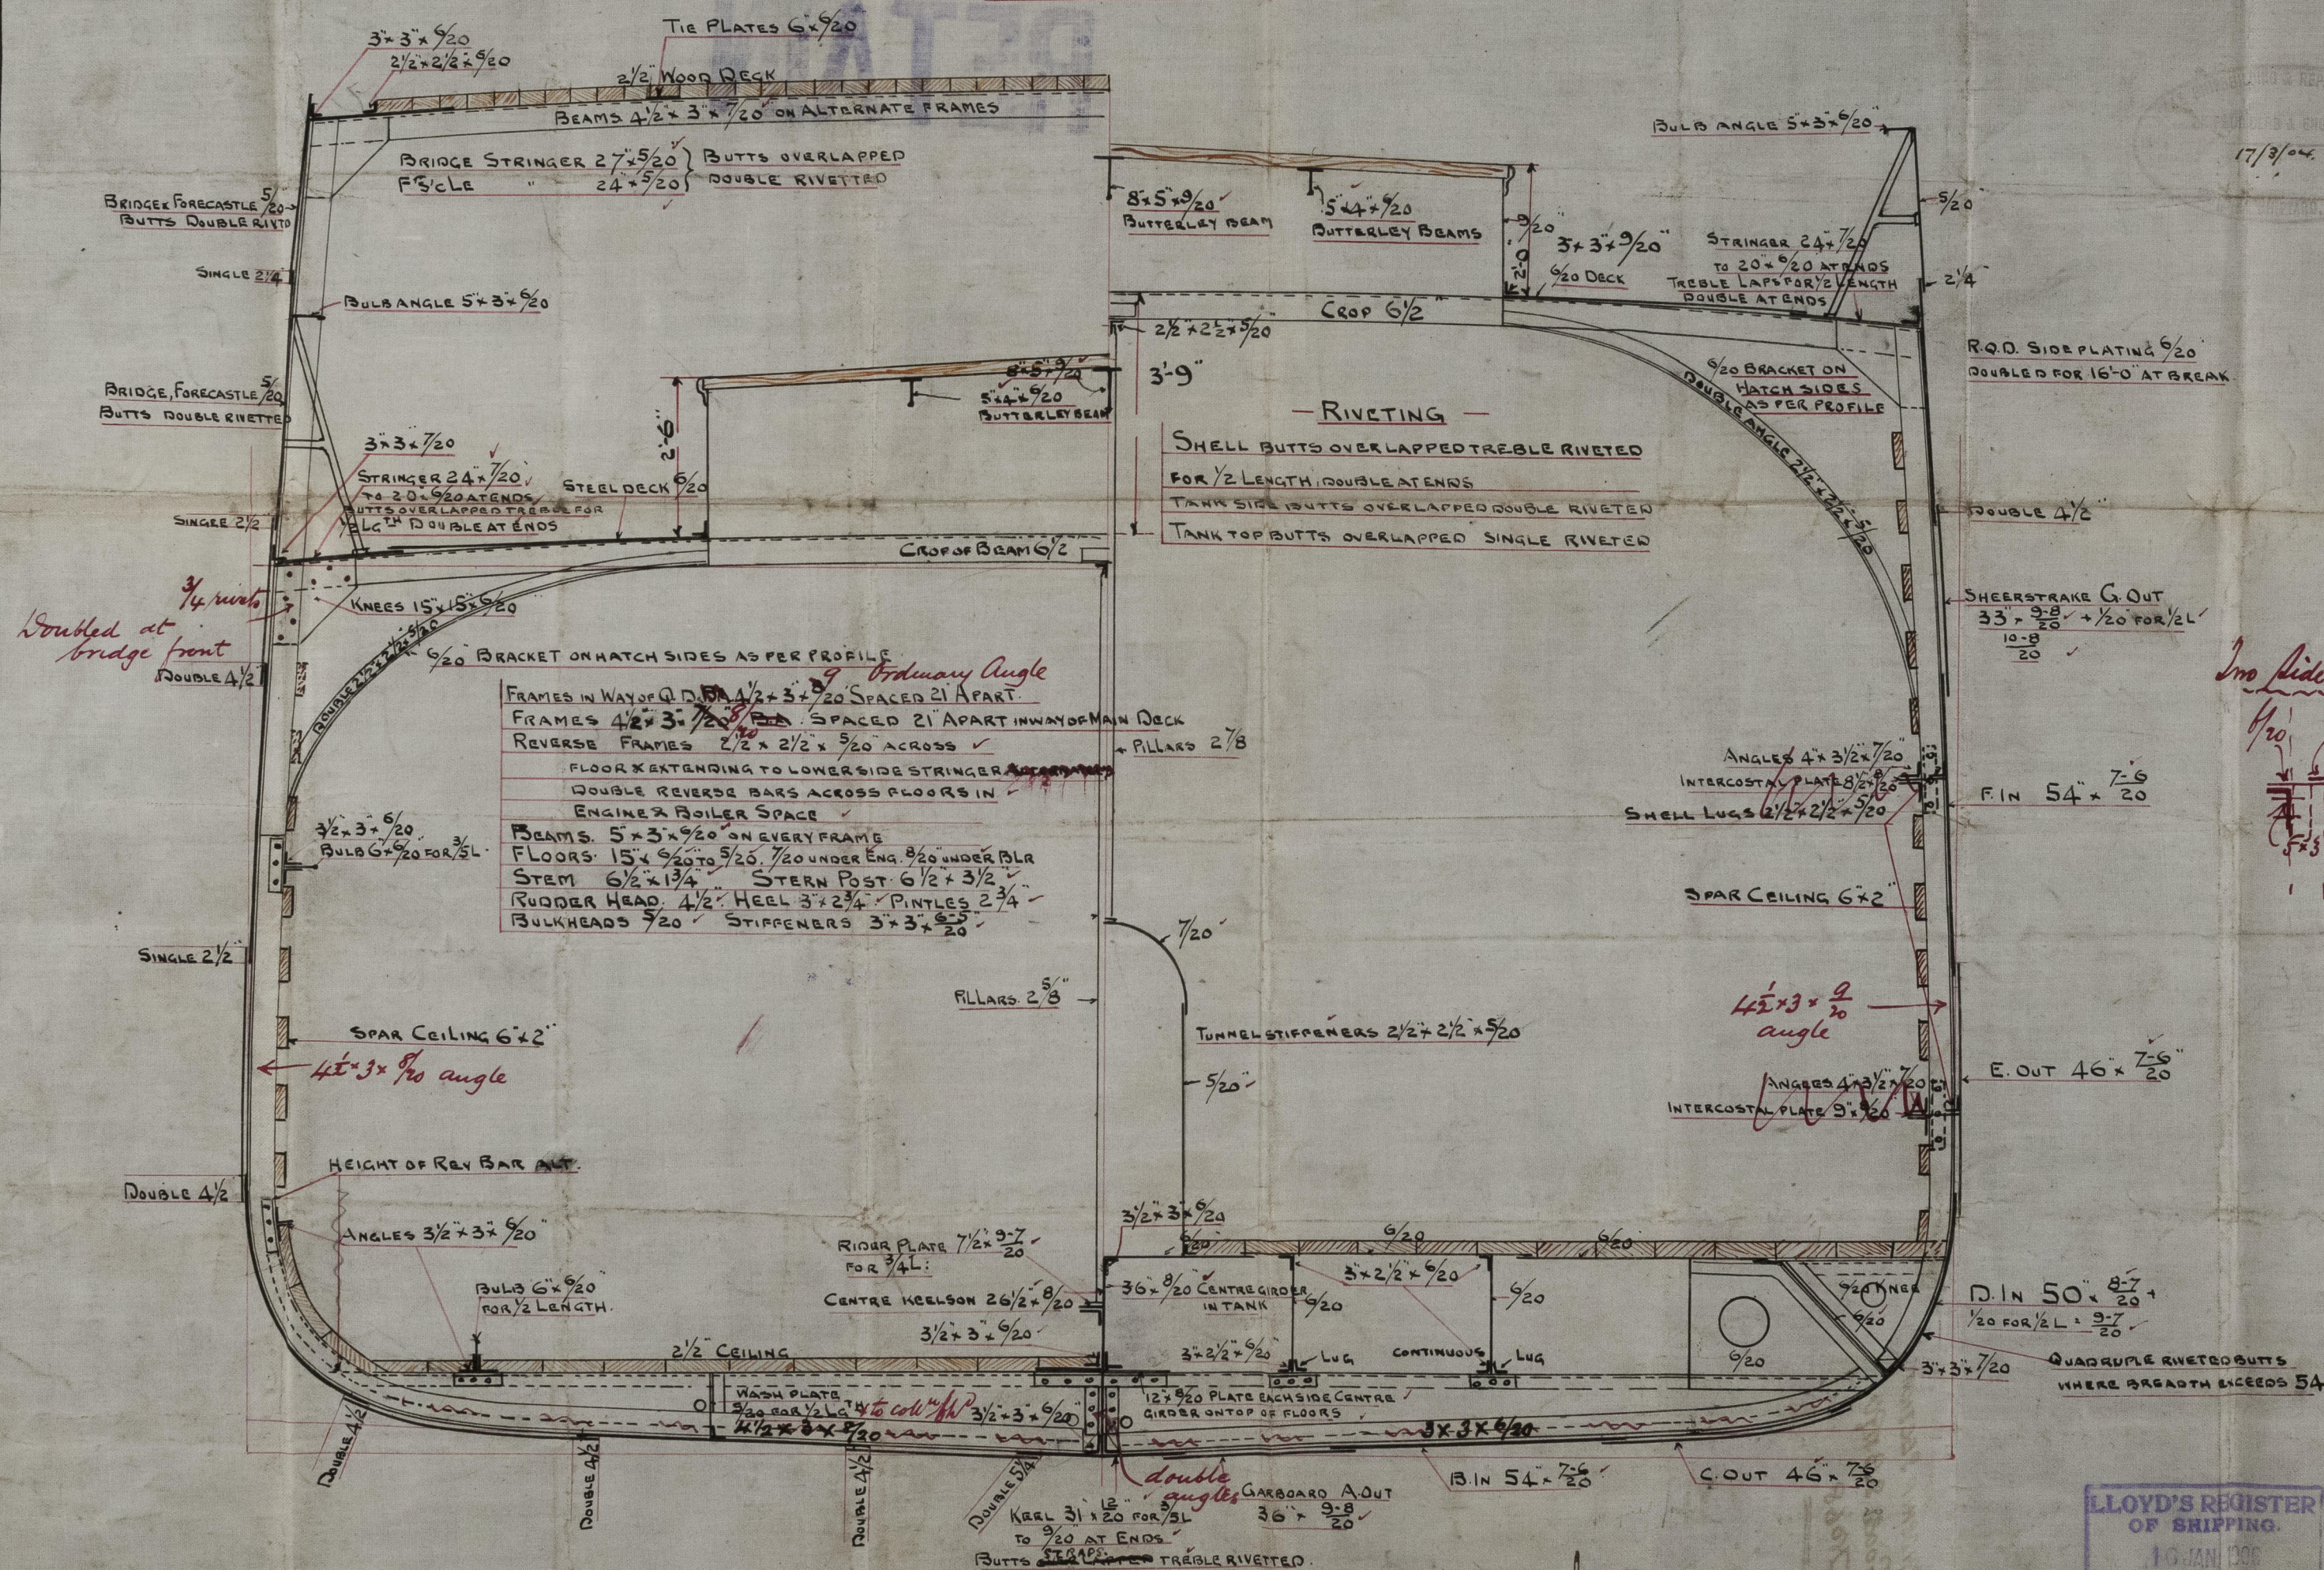

© 202


Lloyd's Register Foundation

W1602-0023

Gool S.R.C.
N-68

Midship Section


"Tees" S.S.

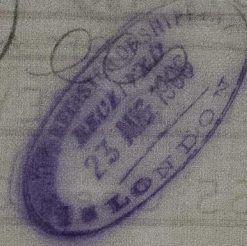

RETAIN

W1602-0023

MIDSHIP SECTION
Gool S.R.C.
N-68

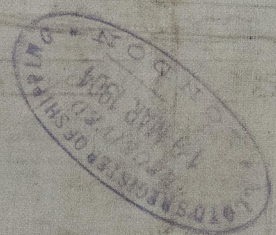

© 2021

Lloyd's Register
Foundation