


23.3.04  
18.1.06

WATER

17/04/04

S.S. No 68.  
PROFILE & DECK PLAN.  
DIM<sup>s</sup> 165'-0" x 26'-0" x 13'-5" ML<sup>d</sup>.  
SCALE 1/4" = 1 FOOT.

17/04/04

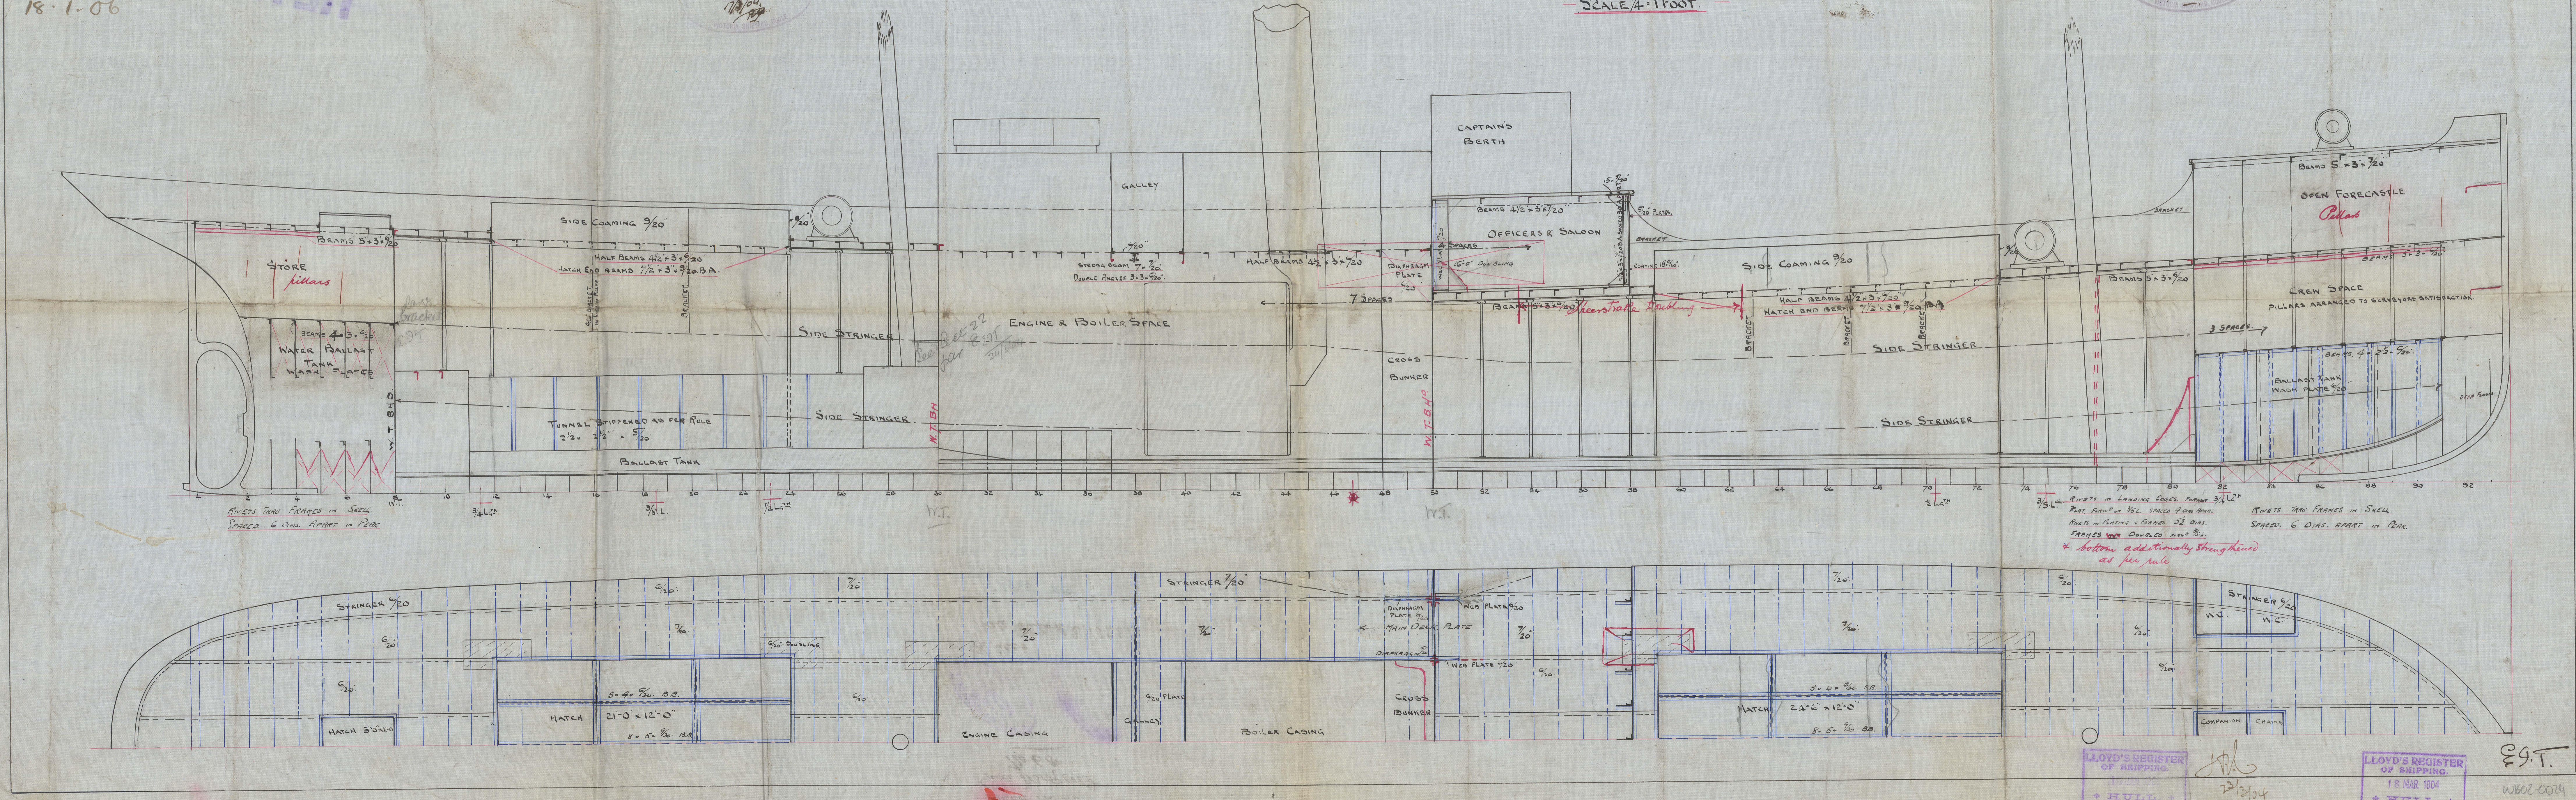

LLOYD'S REGISTER  
OF SHIPPING  
18 MAR 1904  
+ HULL +

LLOYD'S REGISTER  
OF SHIPPING  
18 MAR 1904  
+ HULL +

E9.T.

W1602-0024

PROFILE and  
DECK PLANS  
Date 1807 1824  
No 68



of Dec  
Hull Report No. 18284

W1602-004

RETAIN



© 2021

Lloyd's Register  
Foundation