
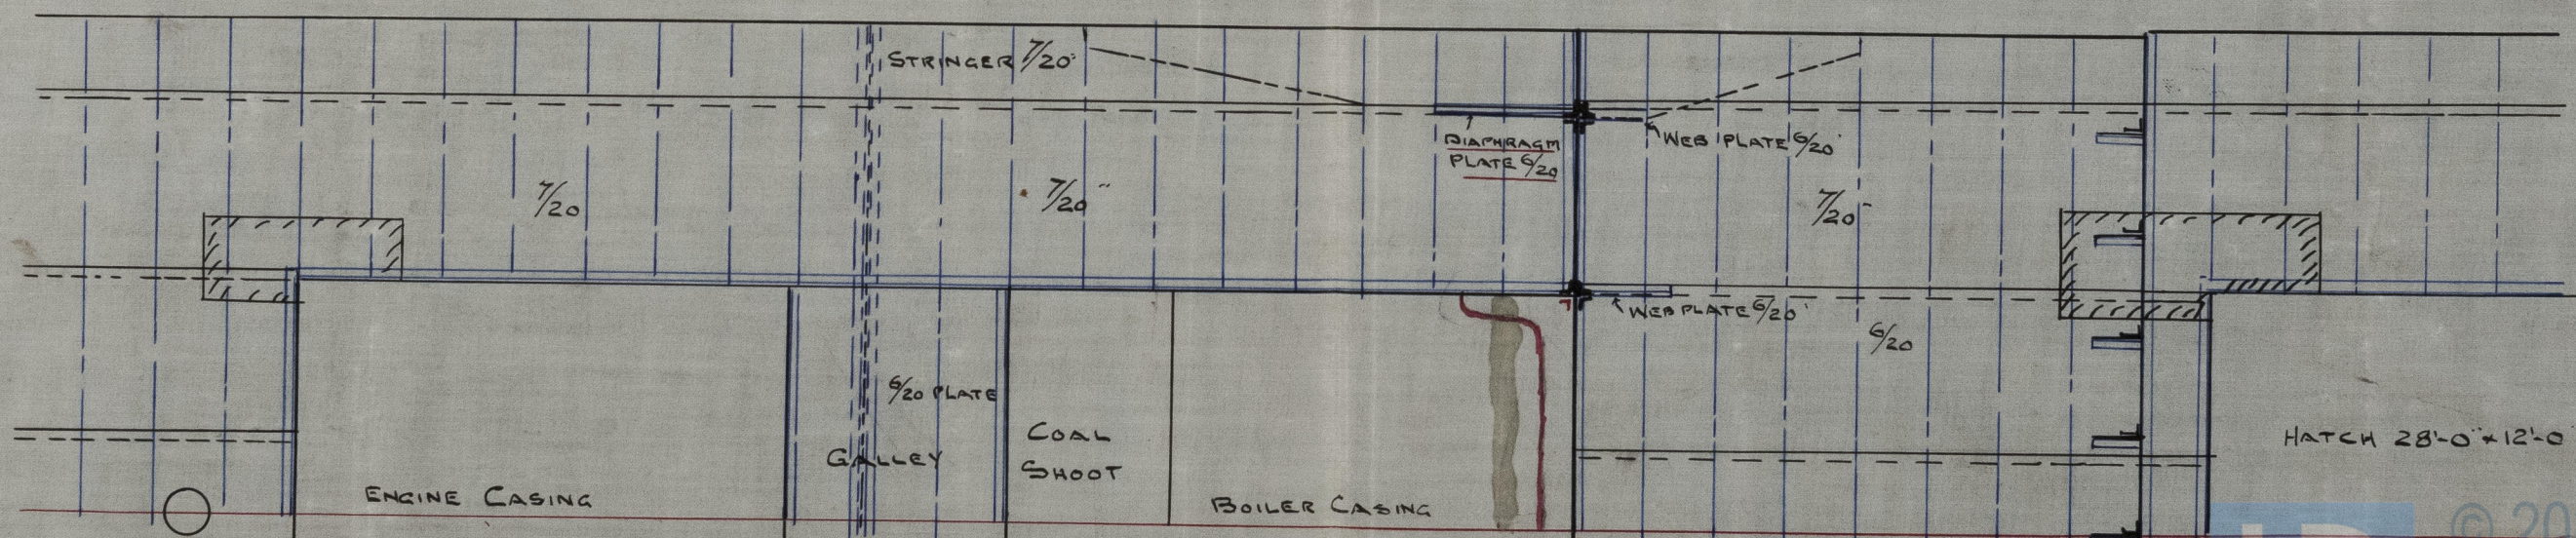



SCALE  $\frac{1}{4}" = 1 \text{ FOOT}$

15/1/06

18.7.06

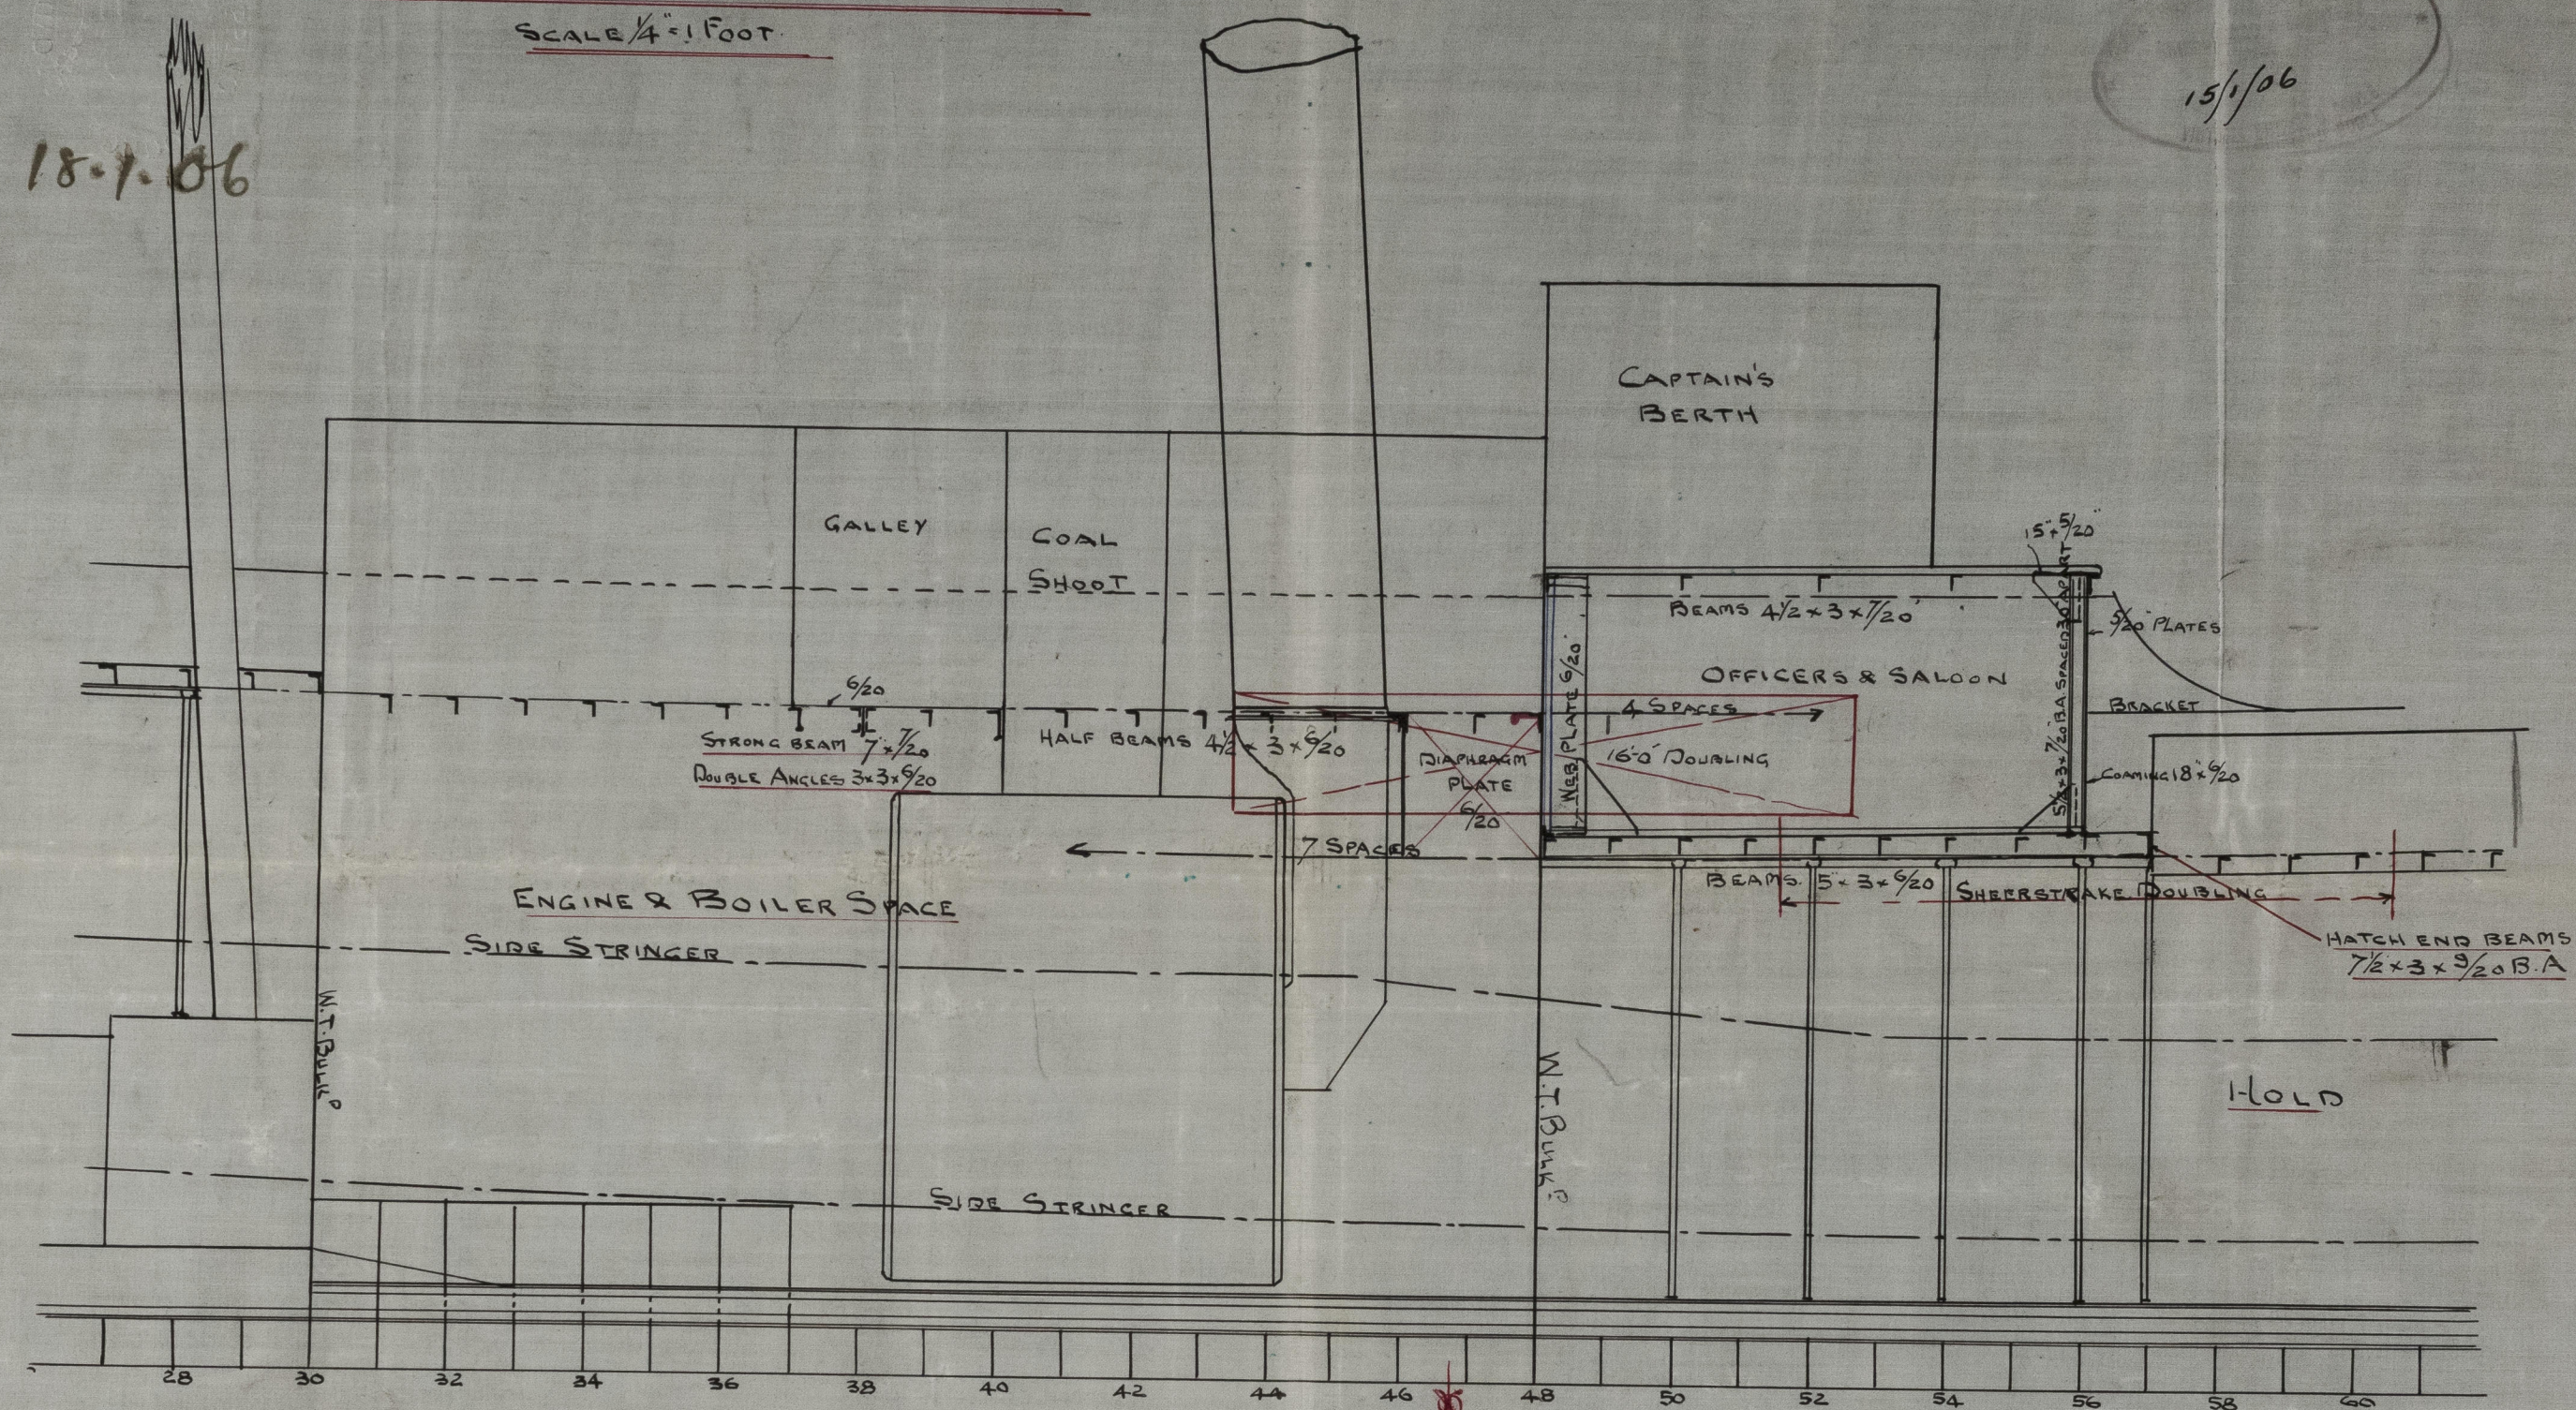

C.B.  
18.1.56

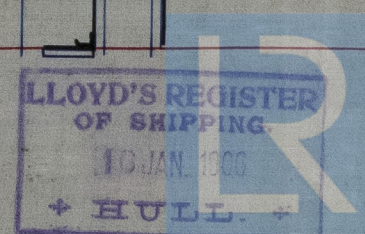

© 2021

Lloyd's Register  
Foundation

W1602-0025