


MIDSHIP SECTION OF SINGLE SCREW WOOD TUG & CARGO LAUNCH.

SCALE 1" = 1 FOOT.

LENGTH 60'-0", B.P. 56'-0", BEAM 14'-0", DEPTH M^{LD} 6'-6".

43.14

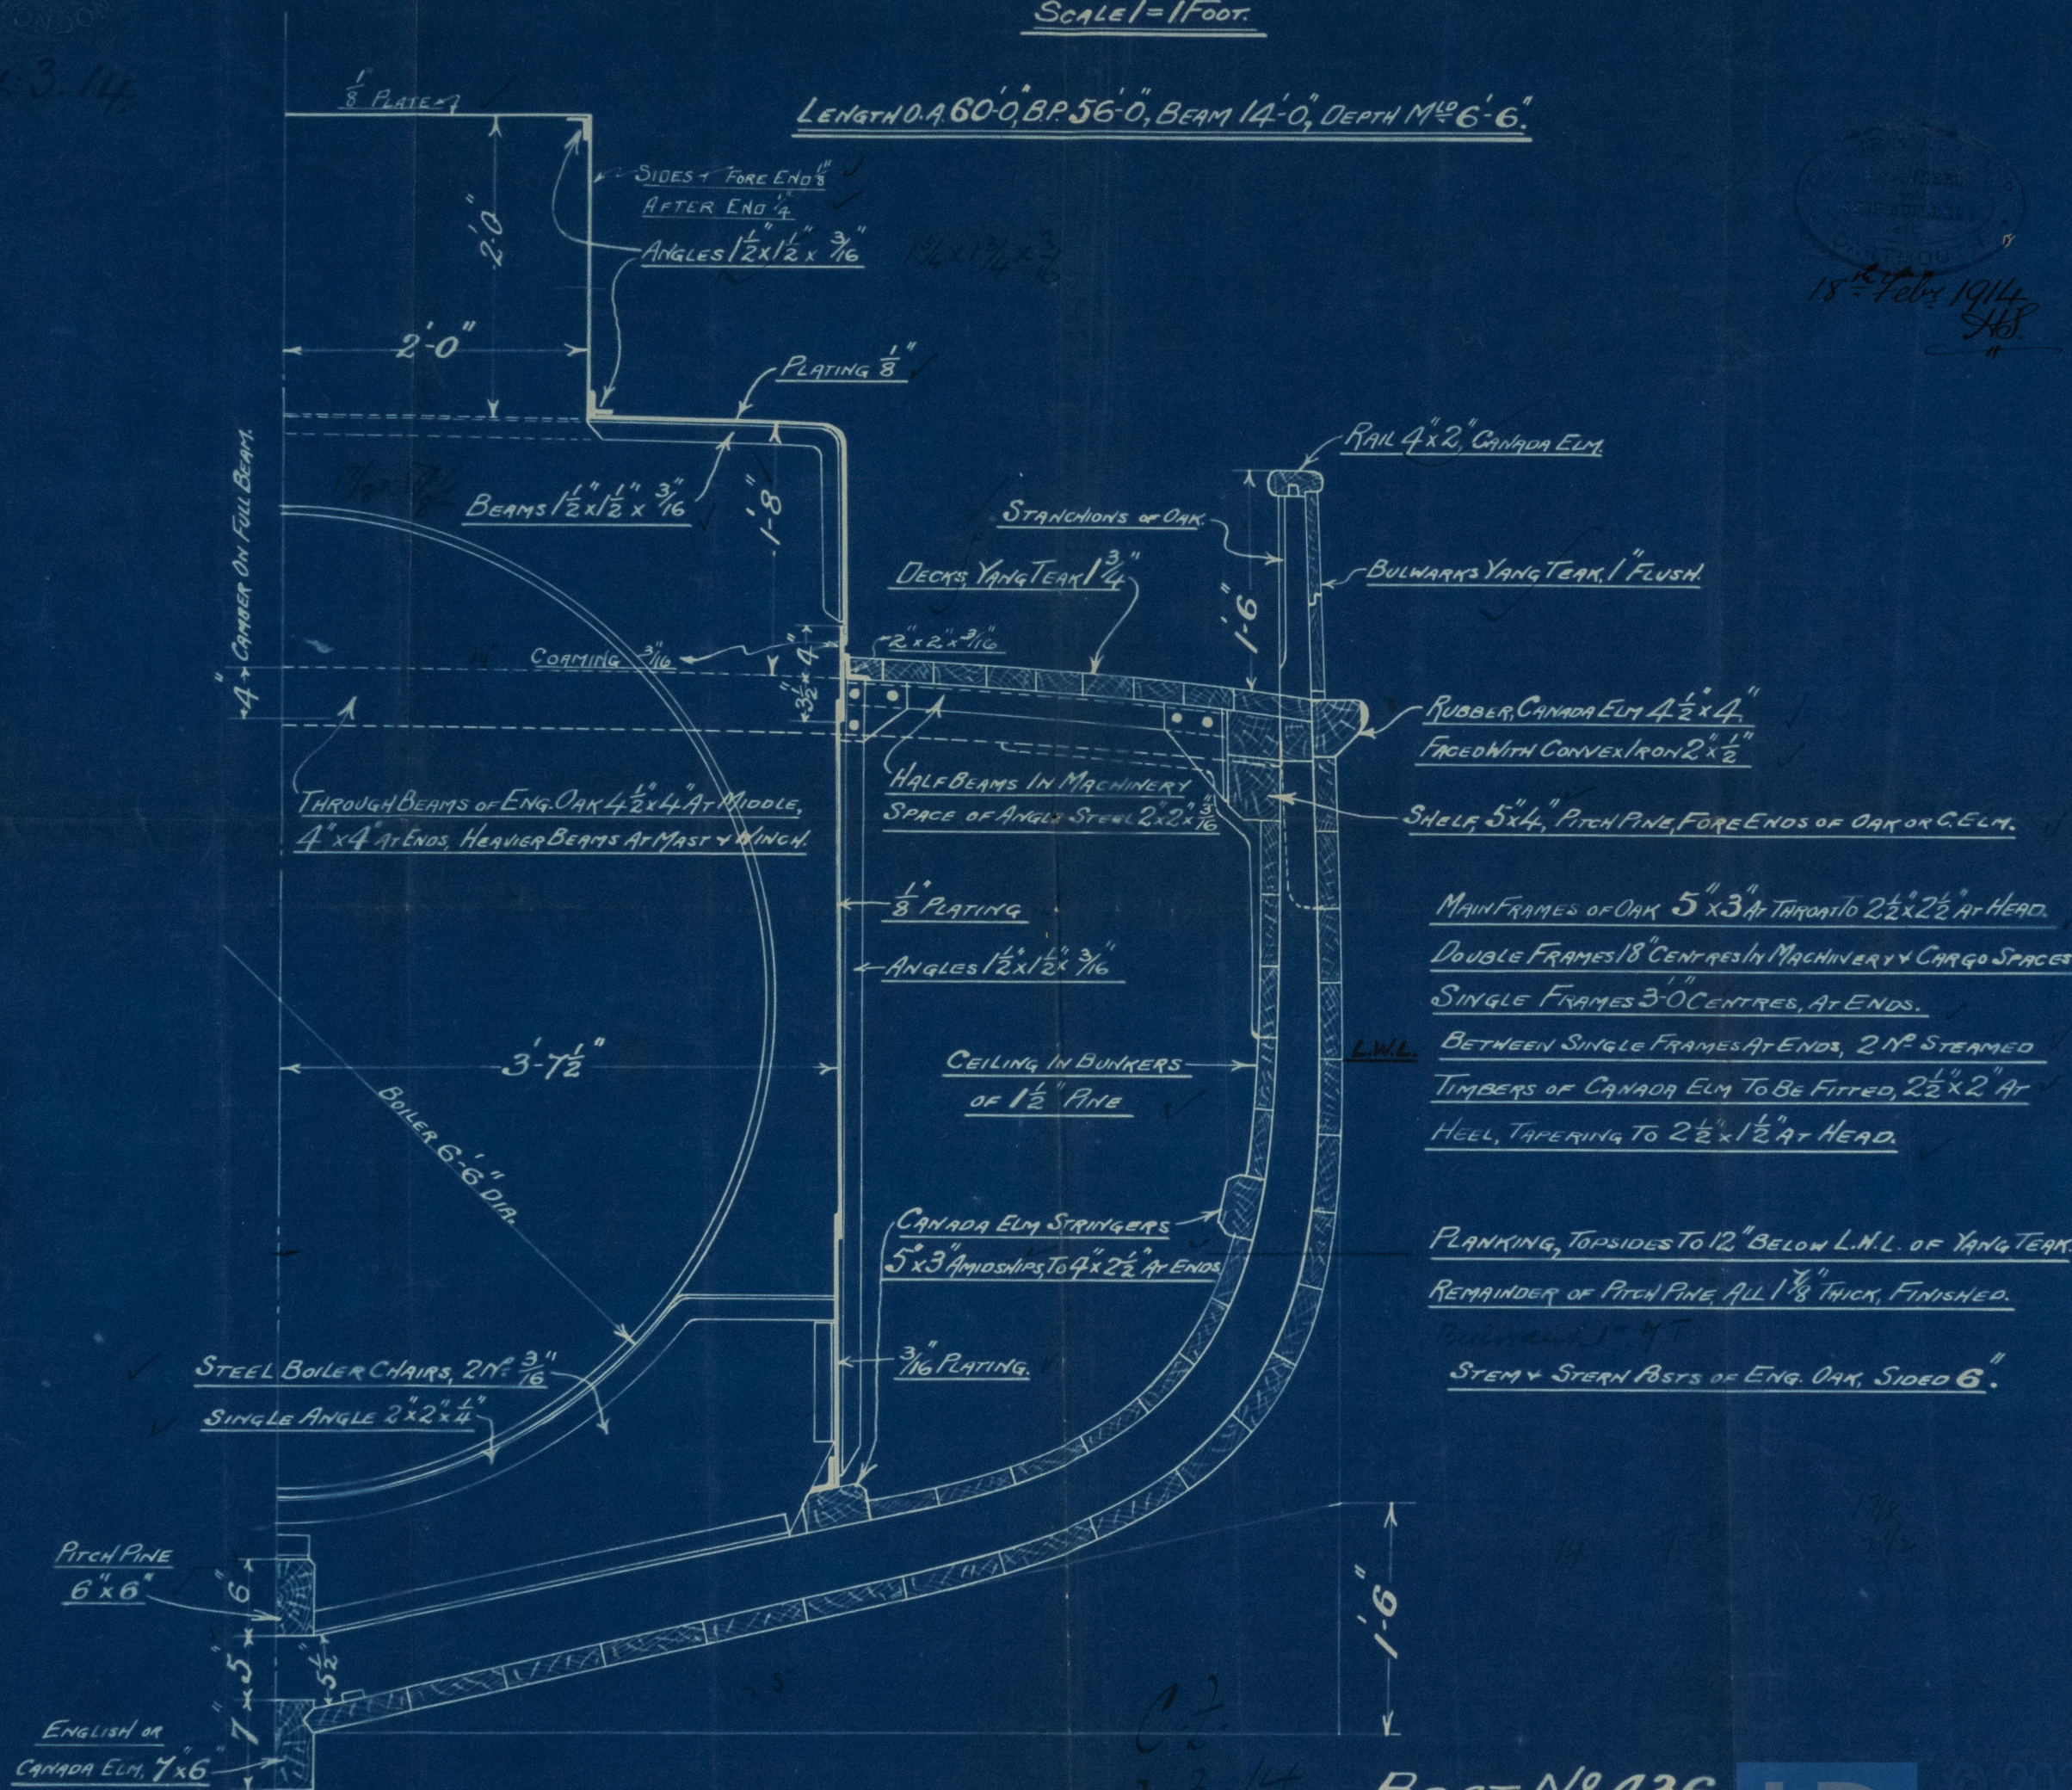

18 Feb 1914
H.B.

33 1/4

BOAT No 436.






© 2021

OCT 27 1913.

Foundation

436

Midship Section
of
by
Philip Hough. DWT No 436

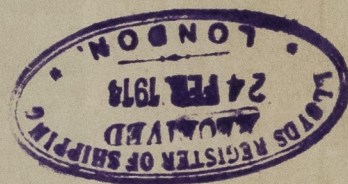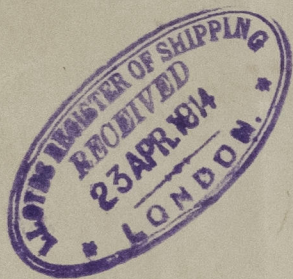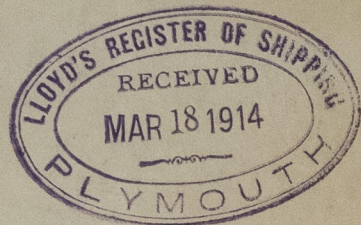

RETAIN

W1603-0233



© 2021

Lloyd's Register
Foundation