

S. Nos. 336-7


MIDSHIP SECTION

STEEL SCREW TRAWLER.

LENGTH 123'-6". BREADTH 21'-11" DEPTH 12'-4" MLD 12'-4" HOLD 11'-6"

TO CLASS 100.A.1. STEAM TRAWLER.

SCALE 1/2" = 1 FOOT.

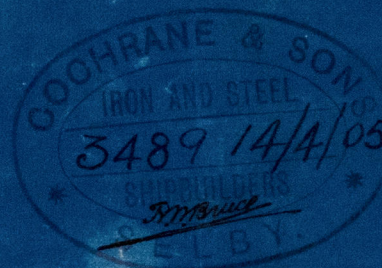

NUMERAL AS PER RULES.

1/2 BREADTH. 10.95

1/2 GIRTH 19.62

DEPTH 12.80

43.37 = 1ST NO

122.37. RULE LENGTH

5307.1869 = 2ND NO

PROPORTIONS.

DEPTH TO LENGTH = 9.5.

BREADTH " " = 5.5.

EQUIPMENT.

1ST BOWER 5 1/2 CWTs EX STOCK.


2ND BOWER 5 " " " "

3RD BOWER 2 3/4 " " " "

105 FATHS 1 1/2 DIA CABLE

60 " 6 " HAWSER

60 " 4 1/2 " WARD.

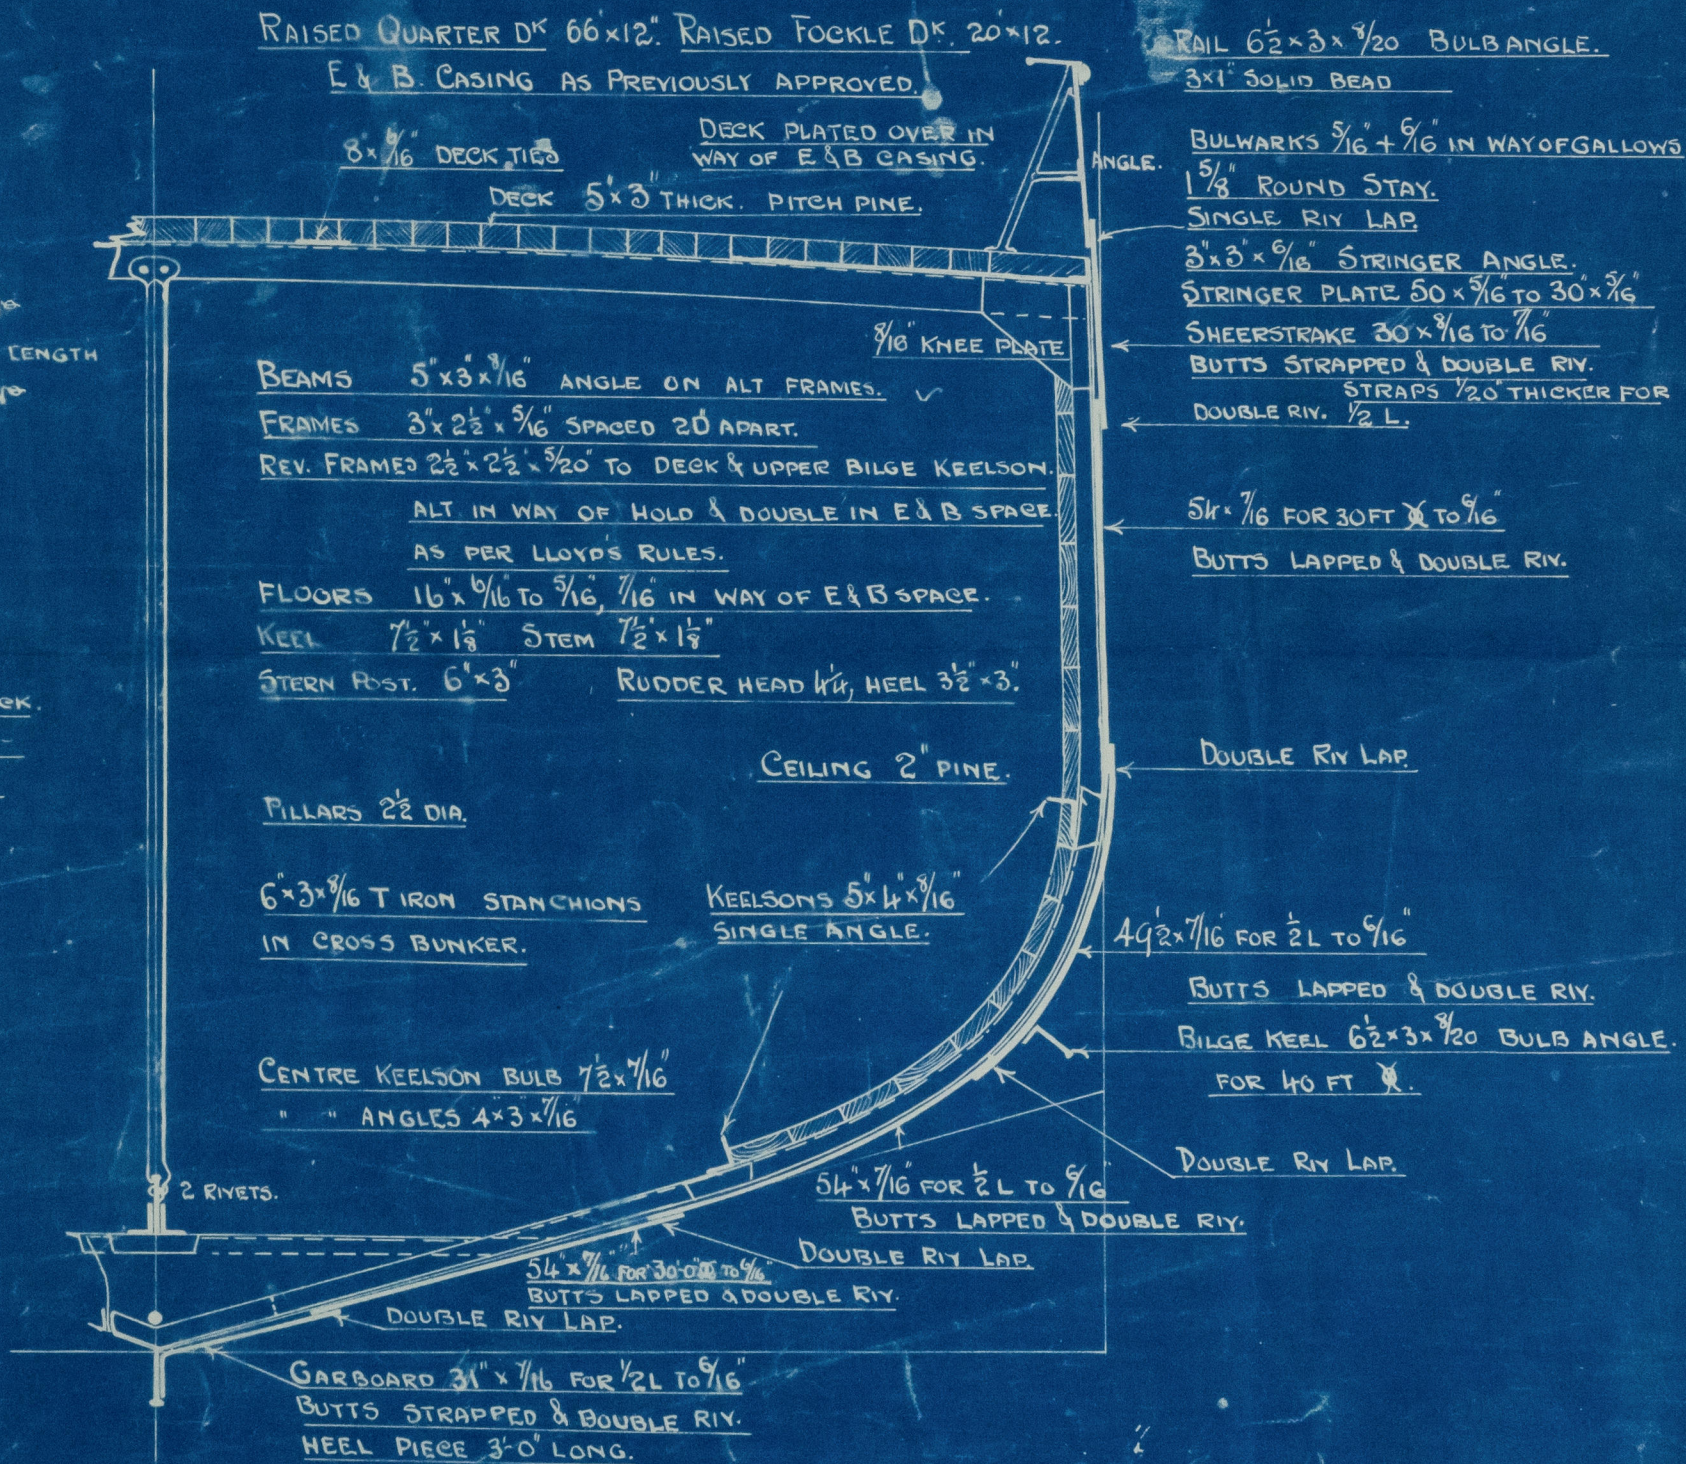

C.P. (Signed)

112-01 LLOYD'S REGISTER OF SHIPPING. 15 DEC 1904. HULL




RETAIN

Cochran & Sons
N^o 366+7.
^{Duplicate}
Midship Section.

N^o 367. "Vesta".

Hull Report No. 16783

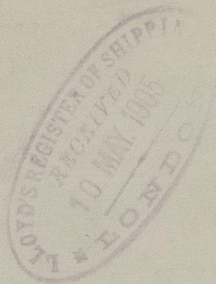

W1604-0176



© 2021

Lloyd's Register
Foundation