

S. No. 336-7


MIDSHIP SECTION

STEEL SCREW TRAWLER.

LENGTH 123'-6" BREADTH 21'-11" DEPTH 12'-4" HOLD 11'-6"

TO CLASS 100 A.1. STEAM TRAWLER.

SCALE 1/2" = 1 FOOT.

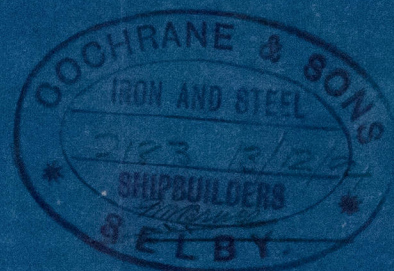

19.12.04  
10.3.05

NUMERAL AS PER RULES.

1/2 BREADTH. 10.95-

1/2 GIRTH 19.62.

DEPTH 12.80

43.37 = 1ST No

122.37. RULE LENGTH

5307.1869. = 2ND No

PROPORTIONS.

DEPTH TO LENGTH = 9.5.

BREADTH " " = 5.5.

EQUIPMENT.

1ST BOWER 5 1/2 CWTs EX STOCK.

2ND BOWER 5 " " " "

3RD BOWER 2 3/4 " " " "

105 FATHS 1 1/2 DIA CABLE

60 " 6 " HAWSER

60 " 4 1/2 " WARD.

RAISED QUARTER DECK 66'x12". RAISED FOCKLE DECK 20'x12".

E & B. CASING AS PREVIOUSLY APPROVED.

8'x 1/16" DECK TIES

DECK PLATED OVER IN WAY OF E & B CASING.

DECK 5'x3" THICK. PITCH PINE.

3/16" KNEE PLATE

BEAMS 5'x3'x 1/16" ANGLE ON ALT FRAMES.

FRAMES 3'x2 1/2'x 5/16" SPACED 20' APART.

REV. FRAMES 2 1/2'x2 1/2'x 5/16" TO DECK & UPPER BILGE KEELSON.

ALT IN WAY OF HOLD & DOUBLE IN E & B SPACE

AS PER LLOYD'S RULES.

FLOORS 16'x 1/16" TO 5/16" 1/16" IN WAY OF E & B SPACE.

KEEL 7 1/2'x 1 1/8" STEM 7 1/2'x 1 1/8"

STERN POST. 6'x3" RUDDER HEAD 4'x4", HEEL 3 1/2'x3".

CEILING 2" PINE.

PILLARS 2 1/2" DIA.

6'x3'x 1/16" T IRON STANCHIONS

IN CROSS BUNKER.

KEELSONS 5'x4'x 1/16"

SINGLE ANGLE.

CENTRE KEELSON BULB 7 1/2'x 1/16"

" " ANGLES 4'x3'x 1/16"

2 RIVETS.

5 1/4'x 1/16" FOR 1/2 L TO 9/16"

BUTTS LAPPED & DOUBLE RIV.

DOUBLE RIV LAP.

5 1/4'x 9/16" ALLTHRO.

BUTTS LAPPED & DOUBLE RIV.

DOUBLE RIV LAP.

GARBOARD 31'x 1/16" FOR 1/2 L TO 9/16"

BUTTS STRAPPED & DOUBLE RIV.

HEEL PIECE 3'-0" LONG.

RAIL 6 1/2'x3'x 3/20 BULB ANGLE.

3'x1" SOLID BEAD

BULWARKS 5/16" + 6/16" IN WAY OF GALLOW.

1 5/8" ROUND STAY.

SINGLE RIV LAP.

3'x3'x 1/16" STRINGER ANGLE.

STRINGER PLATE 50'x 5/16" TO 30'x 5/16"

SHEERSTAKE 30'x 1/16" TO 1/16"

BUTTS STRAPPED & DOUBLE RIV.

STRAPS 1/20" THICKER FOR

DOUBLE RIV. 1/2 L.

5 1/4'x 1/16" FOR 30 FT X TO 9/16"

BUTTS LAPPED & DOUBLE RIV.

DOUBLE RIV LAP.

4 1/2'x 1/16" FOR 1/2 L TO 9/16"

BUTTS LAPPED & DOUBLE RIV.

BILGE KEEL 6 1/2'x3'x 3/20 BULB ANGLE.

FOR 40 FT X.

DOUBLE RIV LAP.



17.12.04

Cochrane & Sons

N<sup>o</sup> 336 & 337

Midship Section.



s/s Ulverston

Hull Report No. 16728

s/s Vesta

Hull Report No.



**RECEIVED**



© 2011

Lloyd's Register  
Foundation