


Apple a Co's No 550

Midship Section
Steel Coasting Steamer

$$\underline{100' \times 19'-6'' \times 8'-6'' \text{ mld}^d}$$

Class 100 ft. Lloyd's

Scale $\frac{3}{4} = 1$ foot

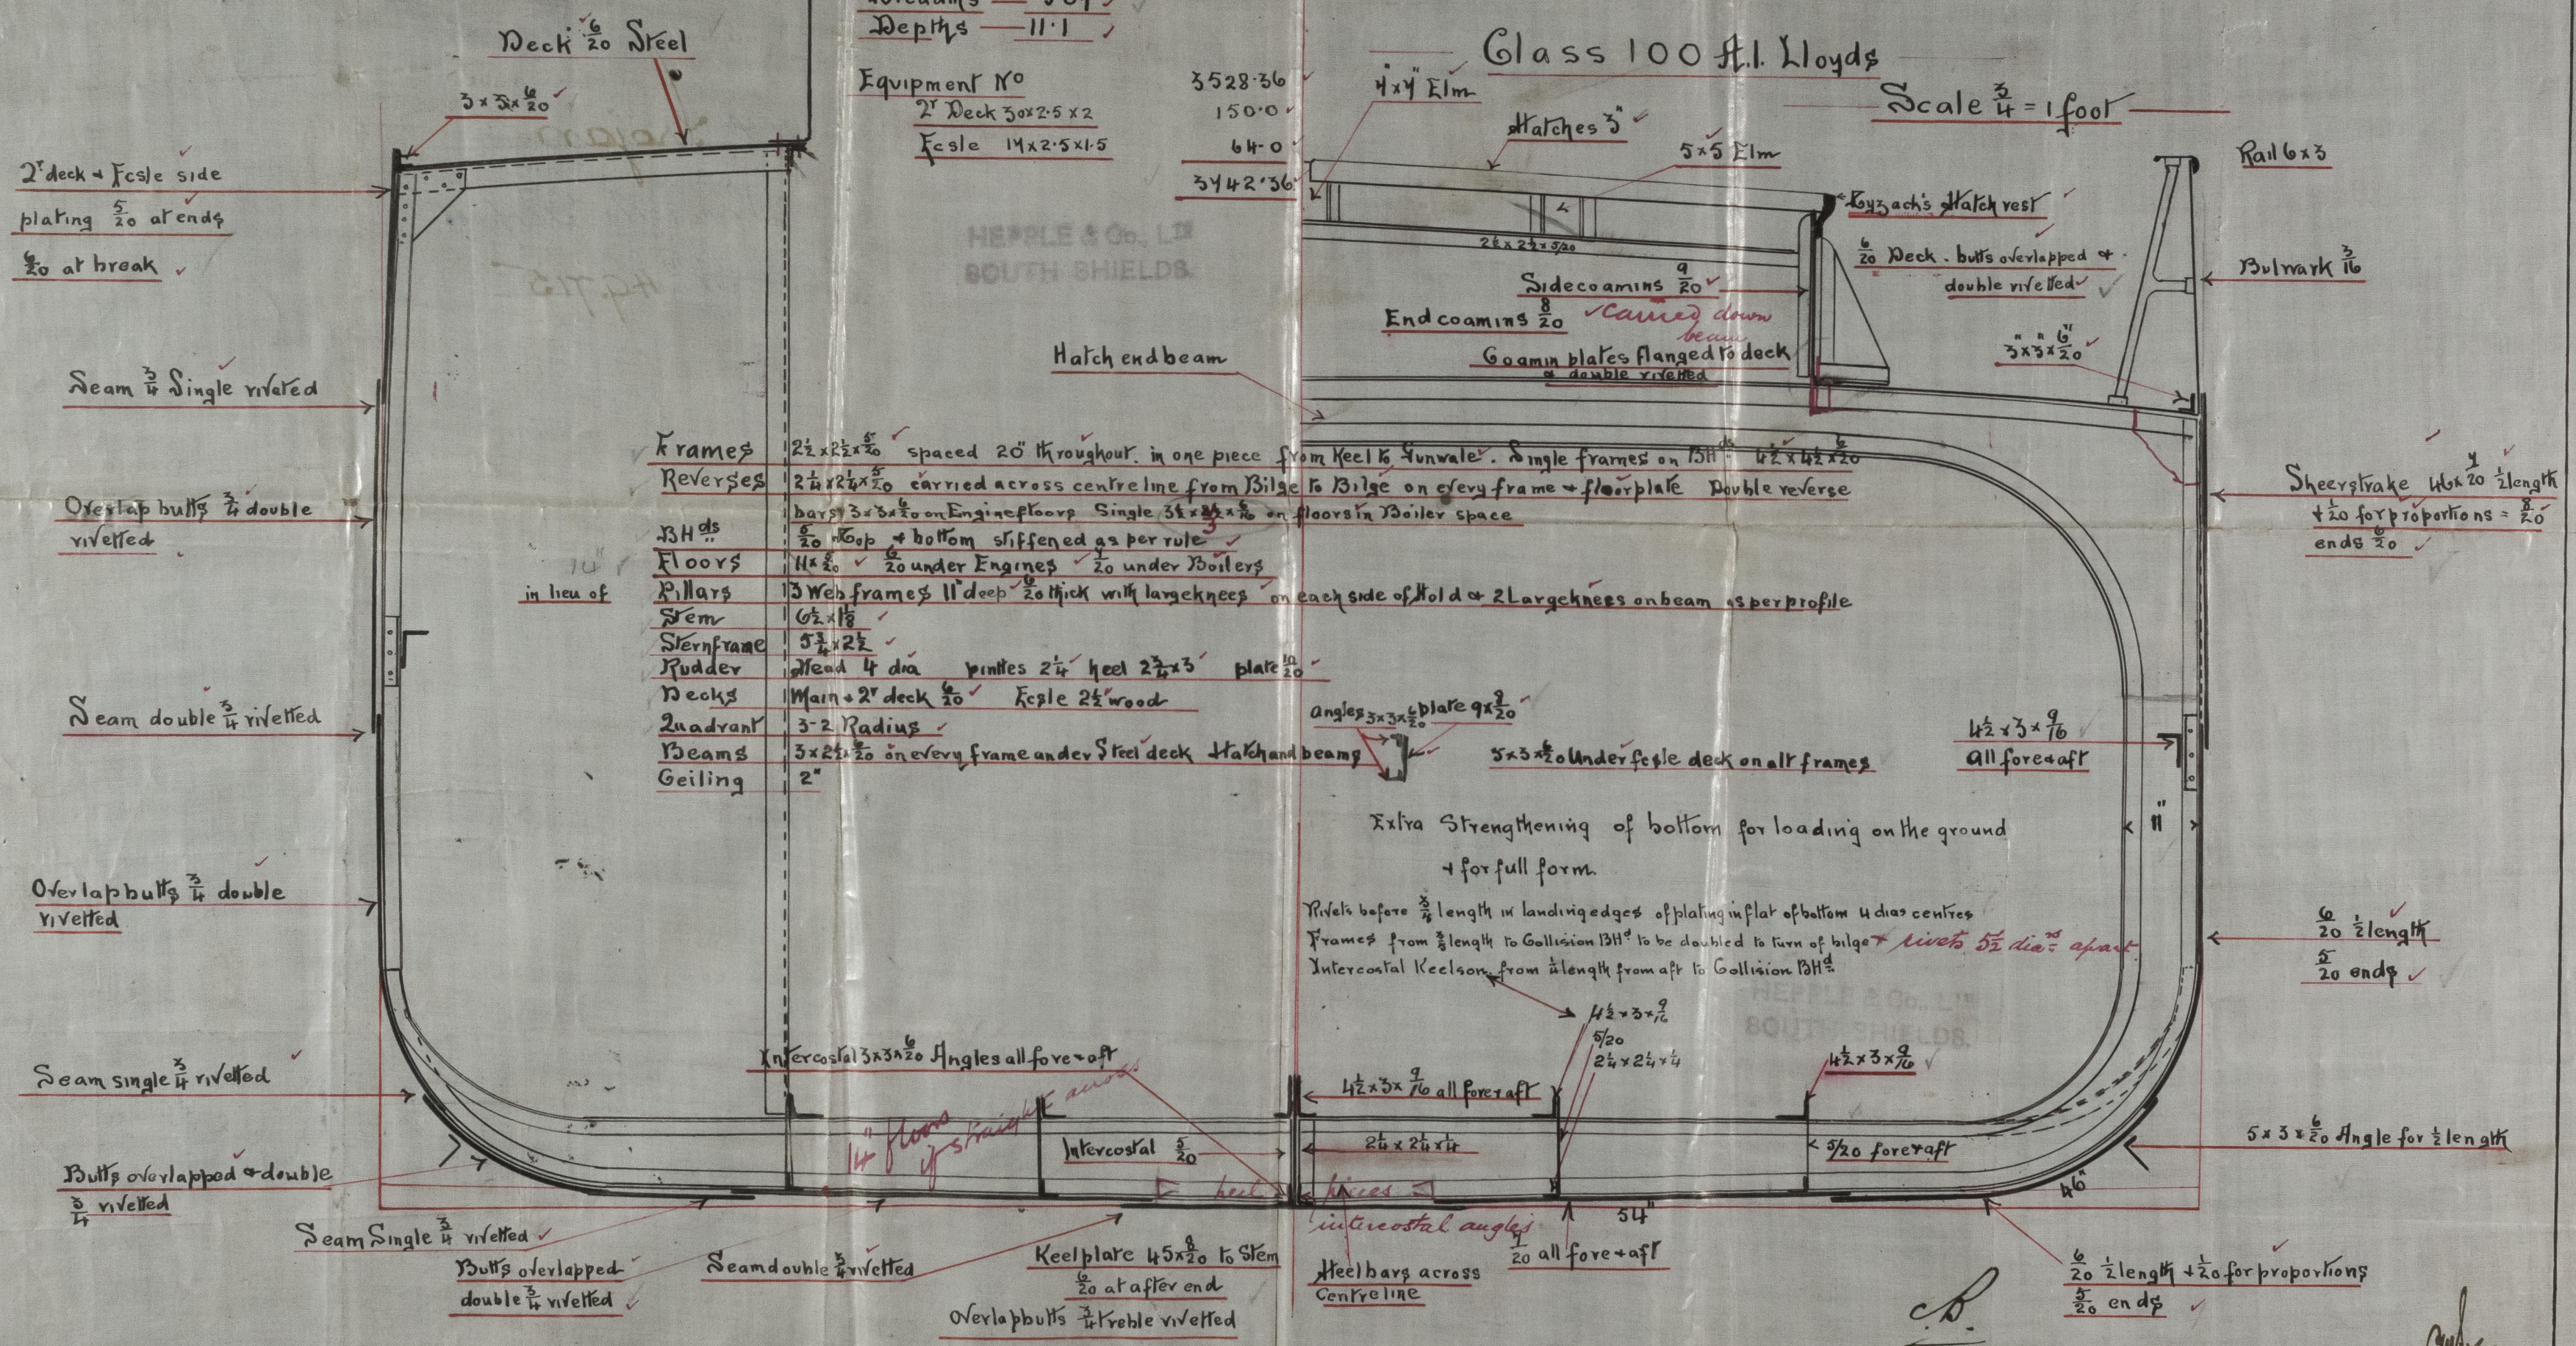

21. 2. 05.
24. 2. 05.

Midship Section
(Amended)

Thoms Hebble Nos
S.S. N° 650.

RETAIN

J. I. Trojan

Newcastle Report

N° 49.715



© 2021

Lloyd's Register
Foundation

W1605-0163