





21.2.05
 24.2.05
 3.3.05

Profile & Plan
Hepple & Co's No 550

Scale $\frac{1}{4}$ " = 1 foot

HEPPLE & CO. LTD
 SOUTH SHIELDS.

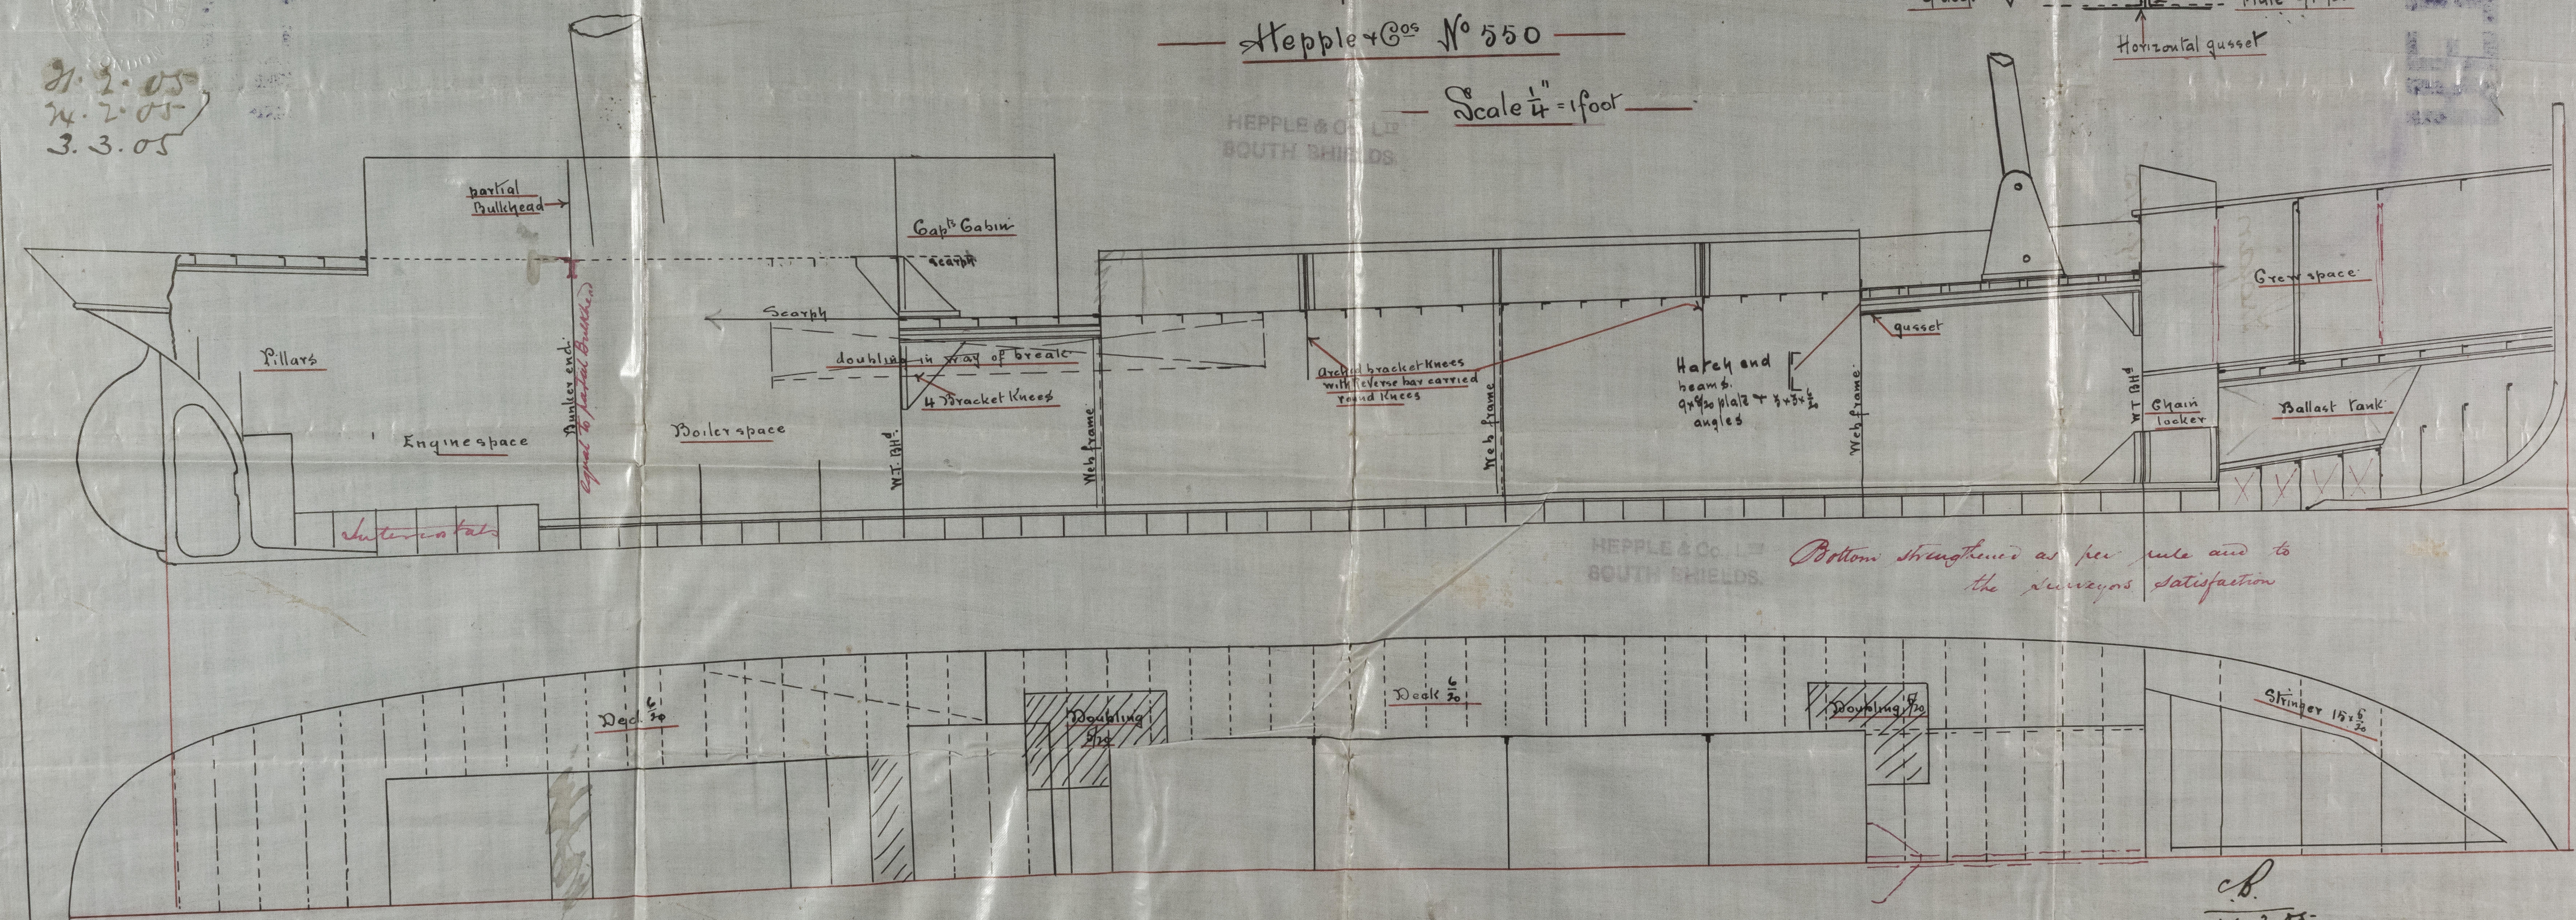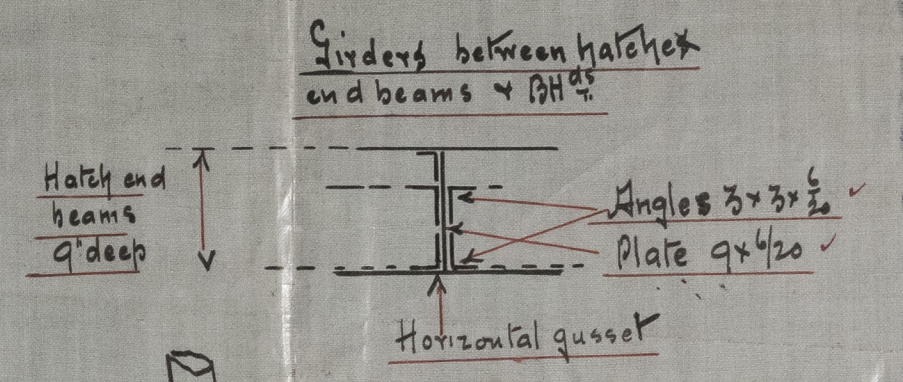

21.2.05
 24.2.05
 3.3.05

C.B.
 21.2.05

21.2.05

W1605-0164

Profile (Amended)

W1605-0164

Mess Hepples' Cos
S.S. No 550.

RETAIN

J.P. Trojan

Newcastle Report

No 149.715



© 2021

Lloyd's Register
Foundation