


H. M. S. "Veronica"

Profile & deck plans
(as built)

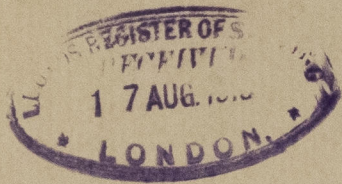

"Veronica"

Grk 16896.

RETAIN



© 2021

Lloyd's Register
Foundation

W1609-0046